MAP OF SURVEY AND LOT SPLIT

PREPARED FOR

THE KING LAND COMPANY

SITUATED IN THE TOWNSHIP OF EATON, COUNTY OF LORAIN, STATE OF OHIO AND BEING KNOWN AS PART OF ORIGINAL EATON TOWNSHIP LOT 30

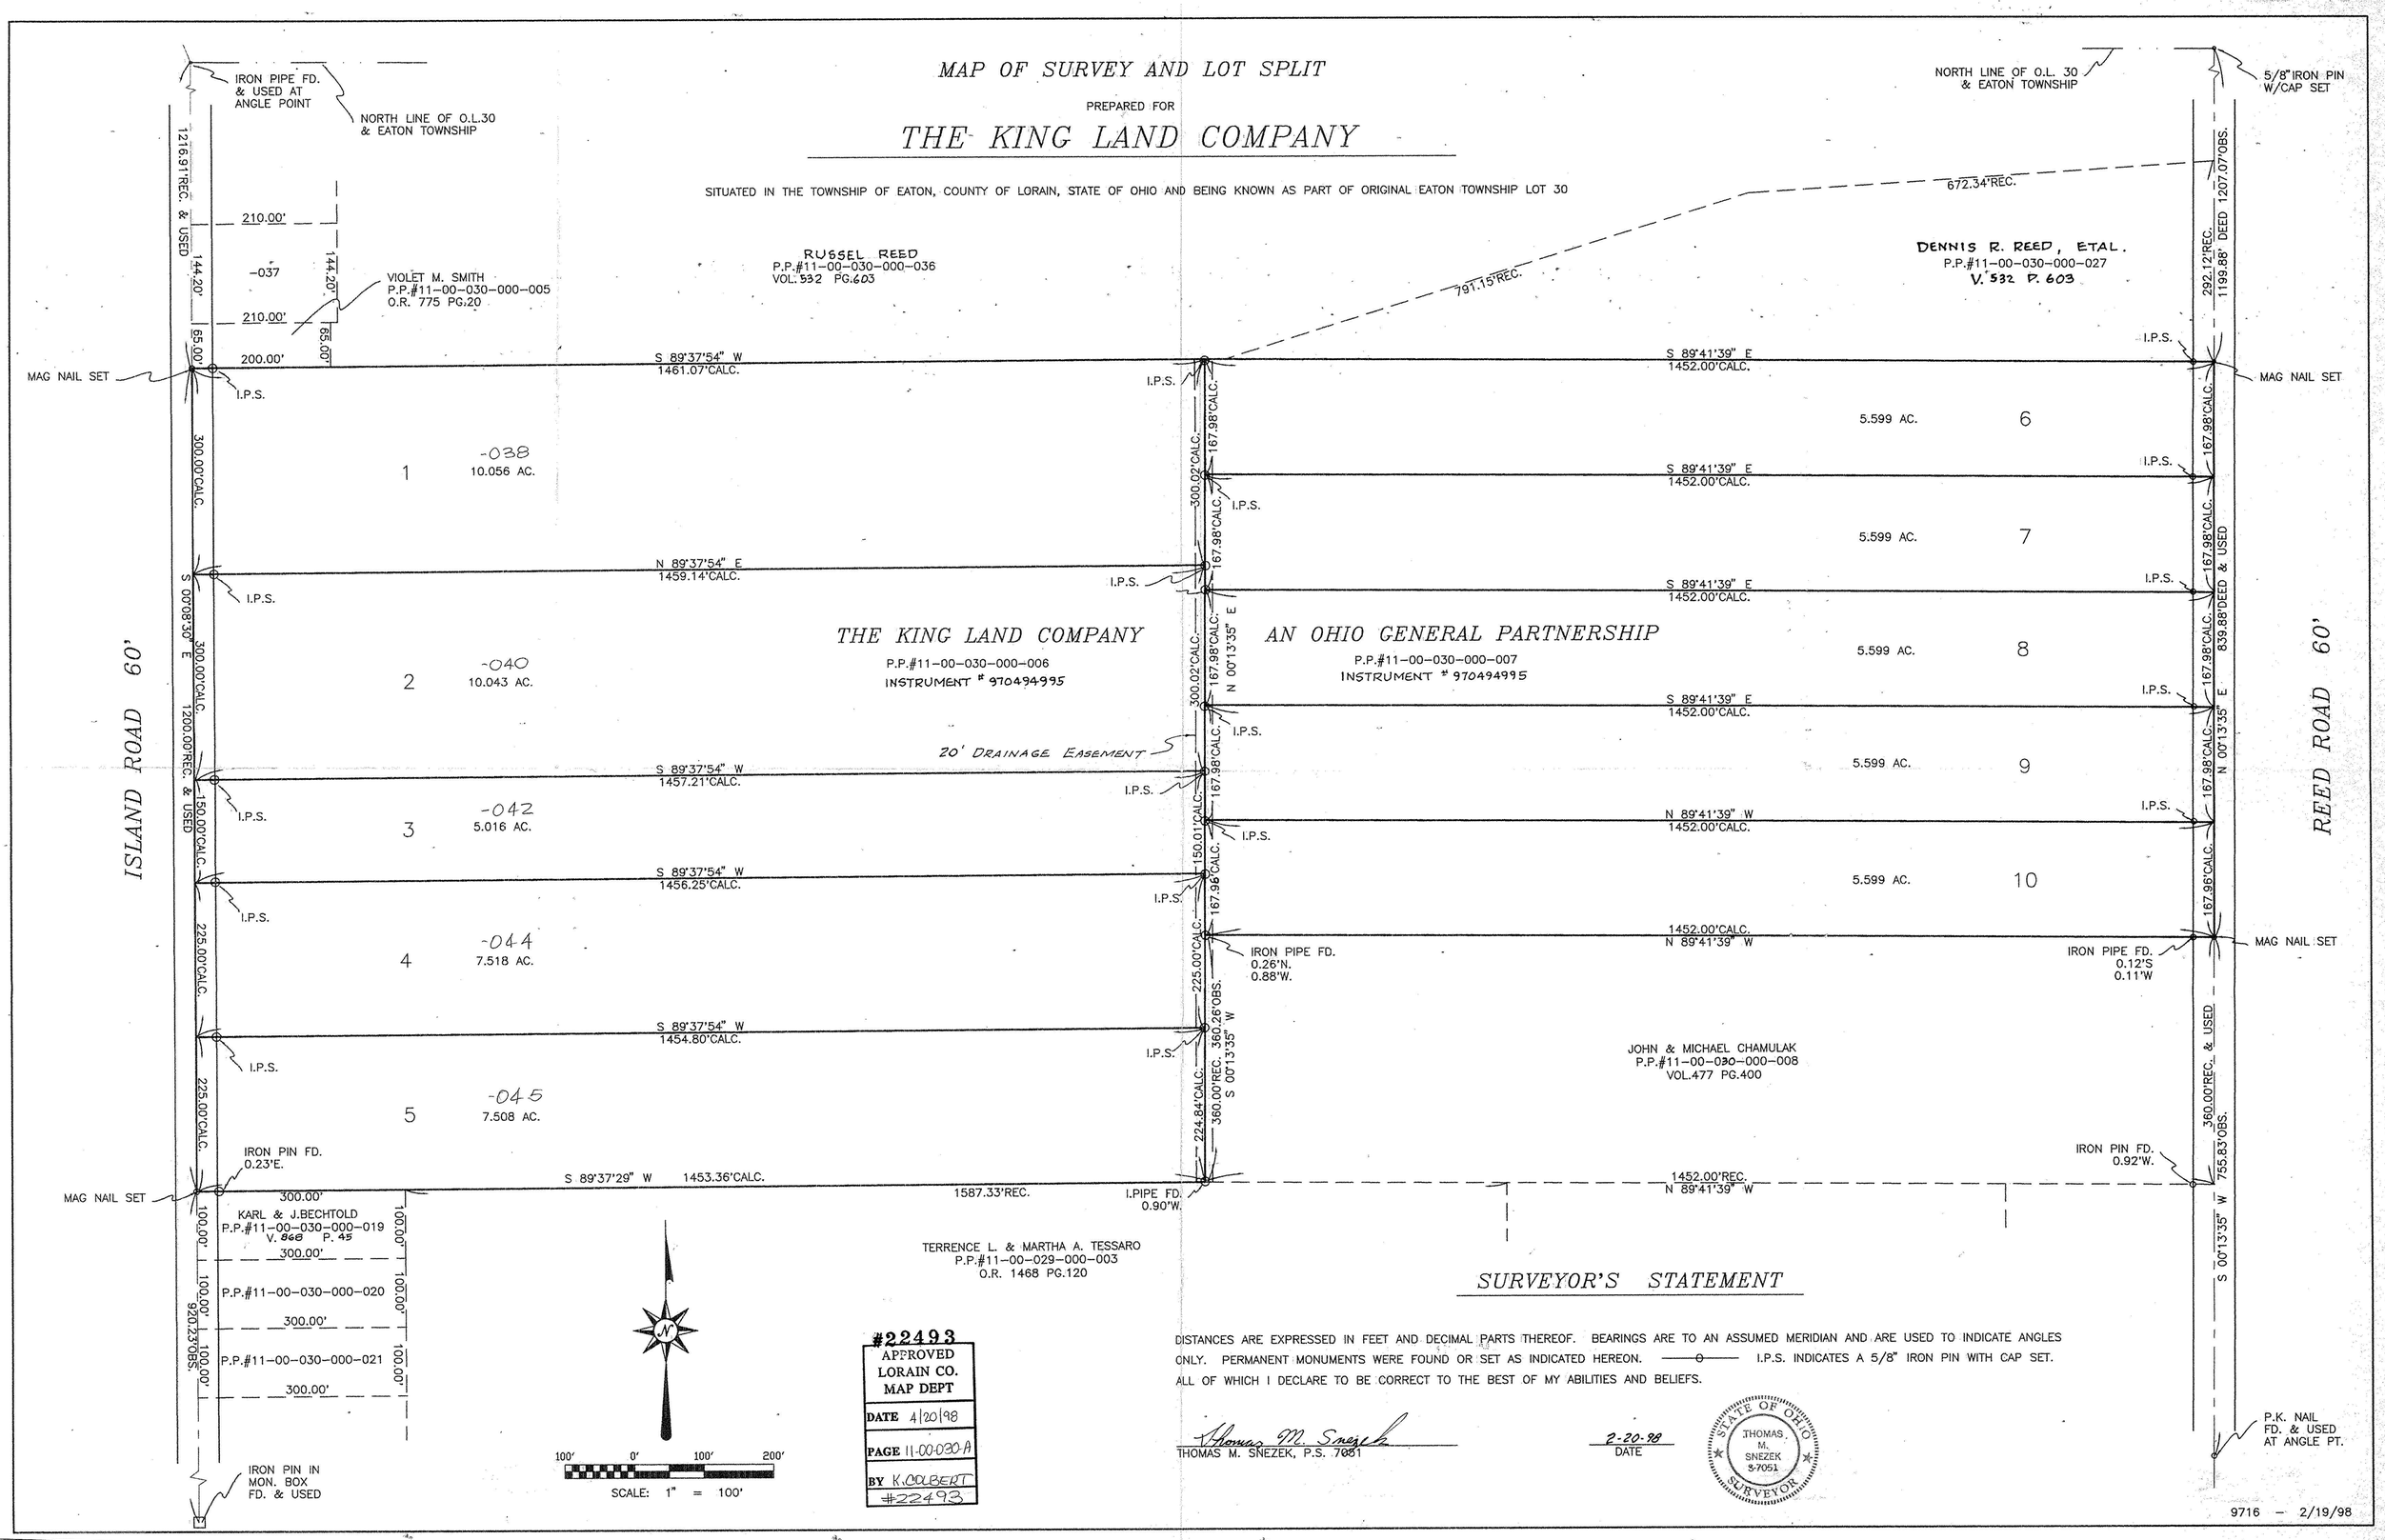

#22493
APPROVED
LORAIN CO.
MAP DEPT
DATE 4/20/98
PAGE 11-00-030-A
BY K.COLBERT
#22493

SURVEYOR'S STATEMENT

DISTANCES ARE EXPRESSED IN FEET AND DECIMAL PARTS THEREOF. BEARINGS ARE TO AN ASSUMED MERIDIAN AND ARE USED TO INDICATE ANGLES ONLY. PERMANENT MONUMENTS WERE FOUND OR SET AS INDICATED HEREON. —o— I.P.S. INDICATES A 5/8" IRON PIN WITH CAP SET. ALL OF WHICH I DECLARE TO BE CORRECT TO THE BEST OF MY ABILITIES AND BELIEFS.

Thomas M. Snezek
THOMAS M. SNEZEK, P.S. 7051

2-20-98
DATE

STATE OF OHIO
THOMAS M. SNEZEK
S-7051
SURVEYOR

NO.