LOT SPLIT OF P.P.Nº 11-00-028-000-048
FOR
LINDA J. TAYLOR & RUTH C. TOMPKINS

SITUATED IN THE TOWNSHIP OF EATON, COUNTY OF LORAIN, AND STATE OF OHIO. BEING PART OF ORIGINAL EATON TOWNSHIP LOT Nº 28

ACCEPTANCE

I/WE, THE UNDERSIGNED OWNER(S) OF THE LAND SHOWN HEREON AS P.P.Nº 11-00-028-000-048, DO HEREBY ASSENT TO AND ADOPT THIS MAP OF PARTITION OF THE SAME AND ACKNOWLEDGE THAT THE SAME WAS MY/OUR FREE ACT AND DEED INDIVIDUALLY

LINDA J. TAYLOR RUTH C. TOMPKINS

STATE OF OHIO
COUNTY OF LORAIN (S.S.)
BEFORE ME, A NOTARY PUBLIC IN AND FOR SAID COUNTY AND STATE, PERSONALLY APPEARED THE ABOVE SIGNED _____
WHO ACKNOWLEDGED THE SIGNING OF THE FOREGOING INSTRUMENT TO BE THEIR FREE ACT & DEED. IN TESTIMONY WHEREOF I HAVE SET MY HAND AND SEAL AT _____, OHIO. THIS _____ DAY OF _____, 1993

NOTARY PUBLIC
MY COMMISSION EXPIRES _____

APPROVALS

THIS LOT SPLIT APPROVED BY THE PLANNING COMMISSION OF THE TOWNSHIP OF EATON, OHIO THIS _____ DAY OF _____, 1993

CHAIRMAN SECRETARY

LORAIN COUNTY ENGINEER

APPROVED _____
DATE _____

ZONING INSPECTOR

APPROVED _____
DATE _____

TAX MAP DEPARTMENT

APPROVED _____
DATE _____

11-00-028-000-

11-00-028-A 20458 MAY 25, 1993

MICHAEL R. ELEWSKI

I HEREBY STATE THAT I HAVE SURVEYED THE LAND SHOWN ON THIS PLAT AND HAVE FOUND OR SET MONUMENTS AS SHOWN. DISTANCES ARE IN FEET DECIMAL PARTS THEREOF. BEARINGS ARE TO AN ASSUMED MERIDIAN AND ARE USED TO DENOTE ANGLES ONLY. ALL OF WHICH I STATE TO BE CORRECT TO THE BEST OF MY PROFESSIONAL KNOWLEDGE, INFORMATION, & BELIEF.

Michael R. Elewski
MICHAEL R. ELEWSKI ~ Ohio registered Surveyor Nº 7252

STATE OF OHIO
MICHAEL R. ELEWSKI
7252
REGISTERED
PROFESSIONAL SURVEYOR

N

0 50 100 200
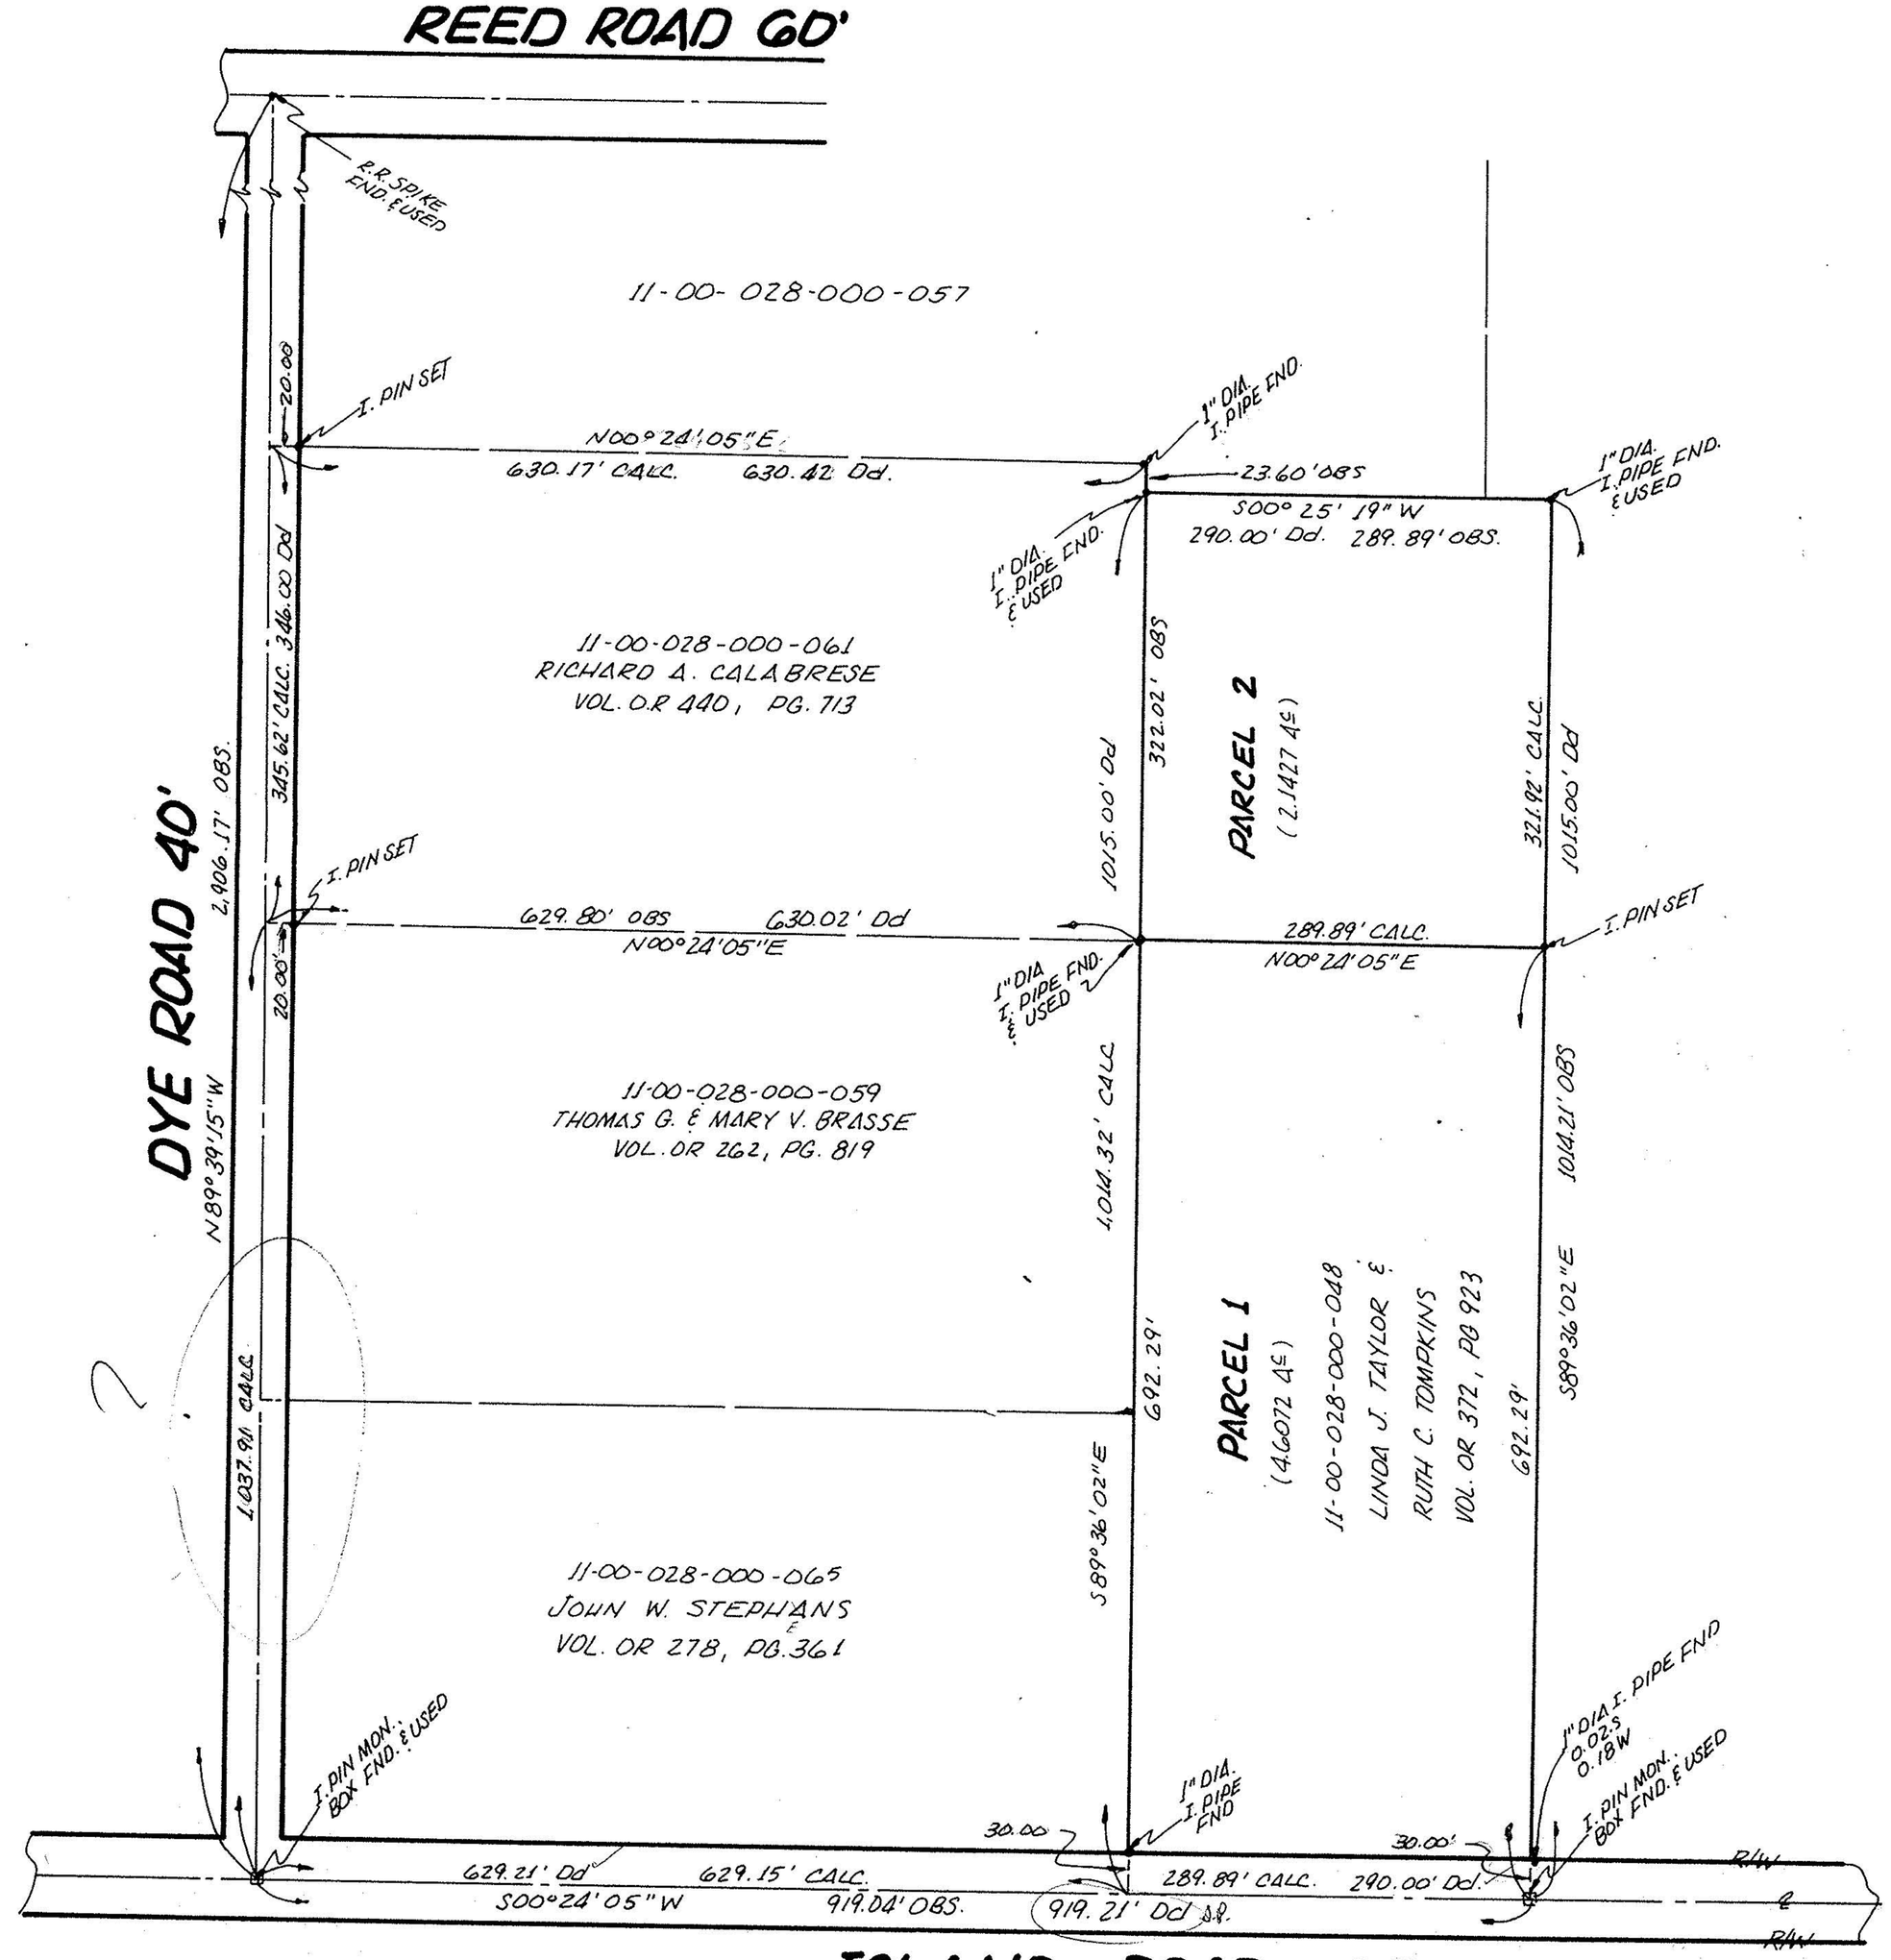
SCALE: 1" = 100'