SURVEY
PART OF
ORIGINAL EATON TOWNSHIP
LOT No 26
TOWNSHIP OF EATON COUNTY OF LORAIN
STATE OF OHIO

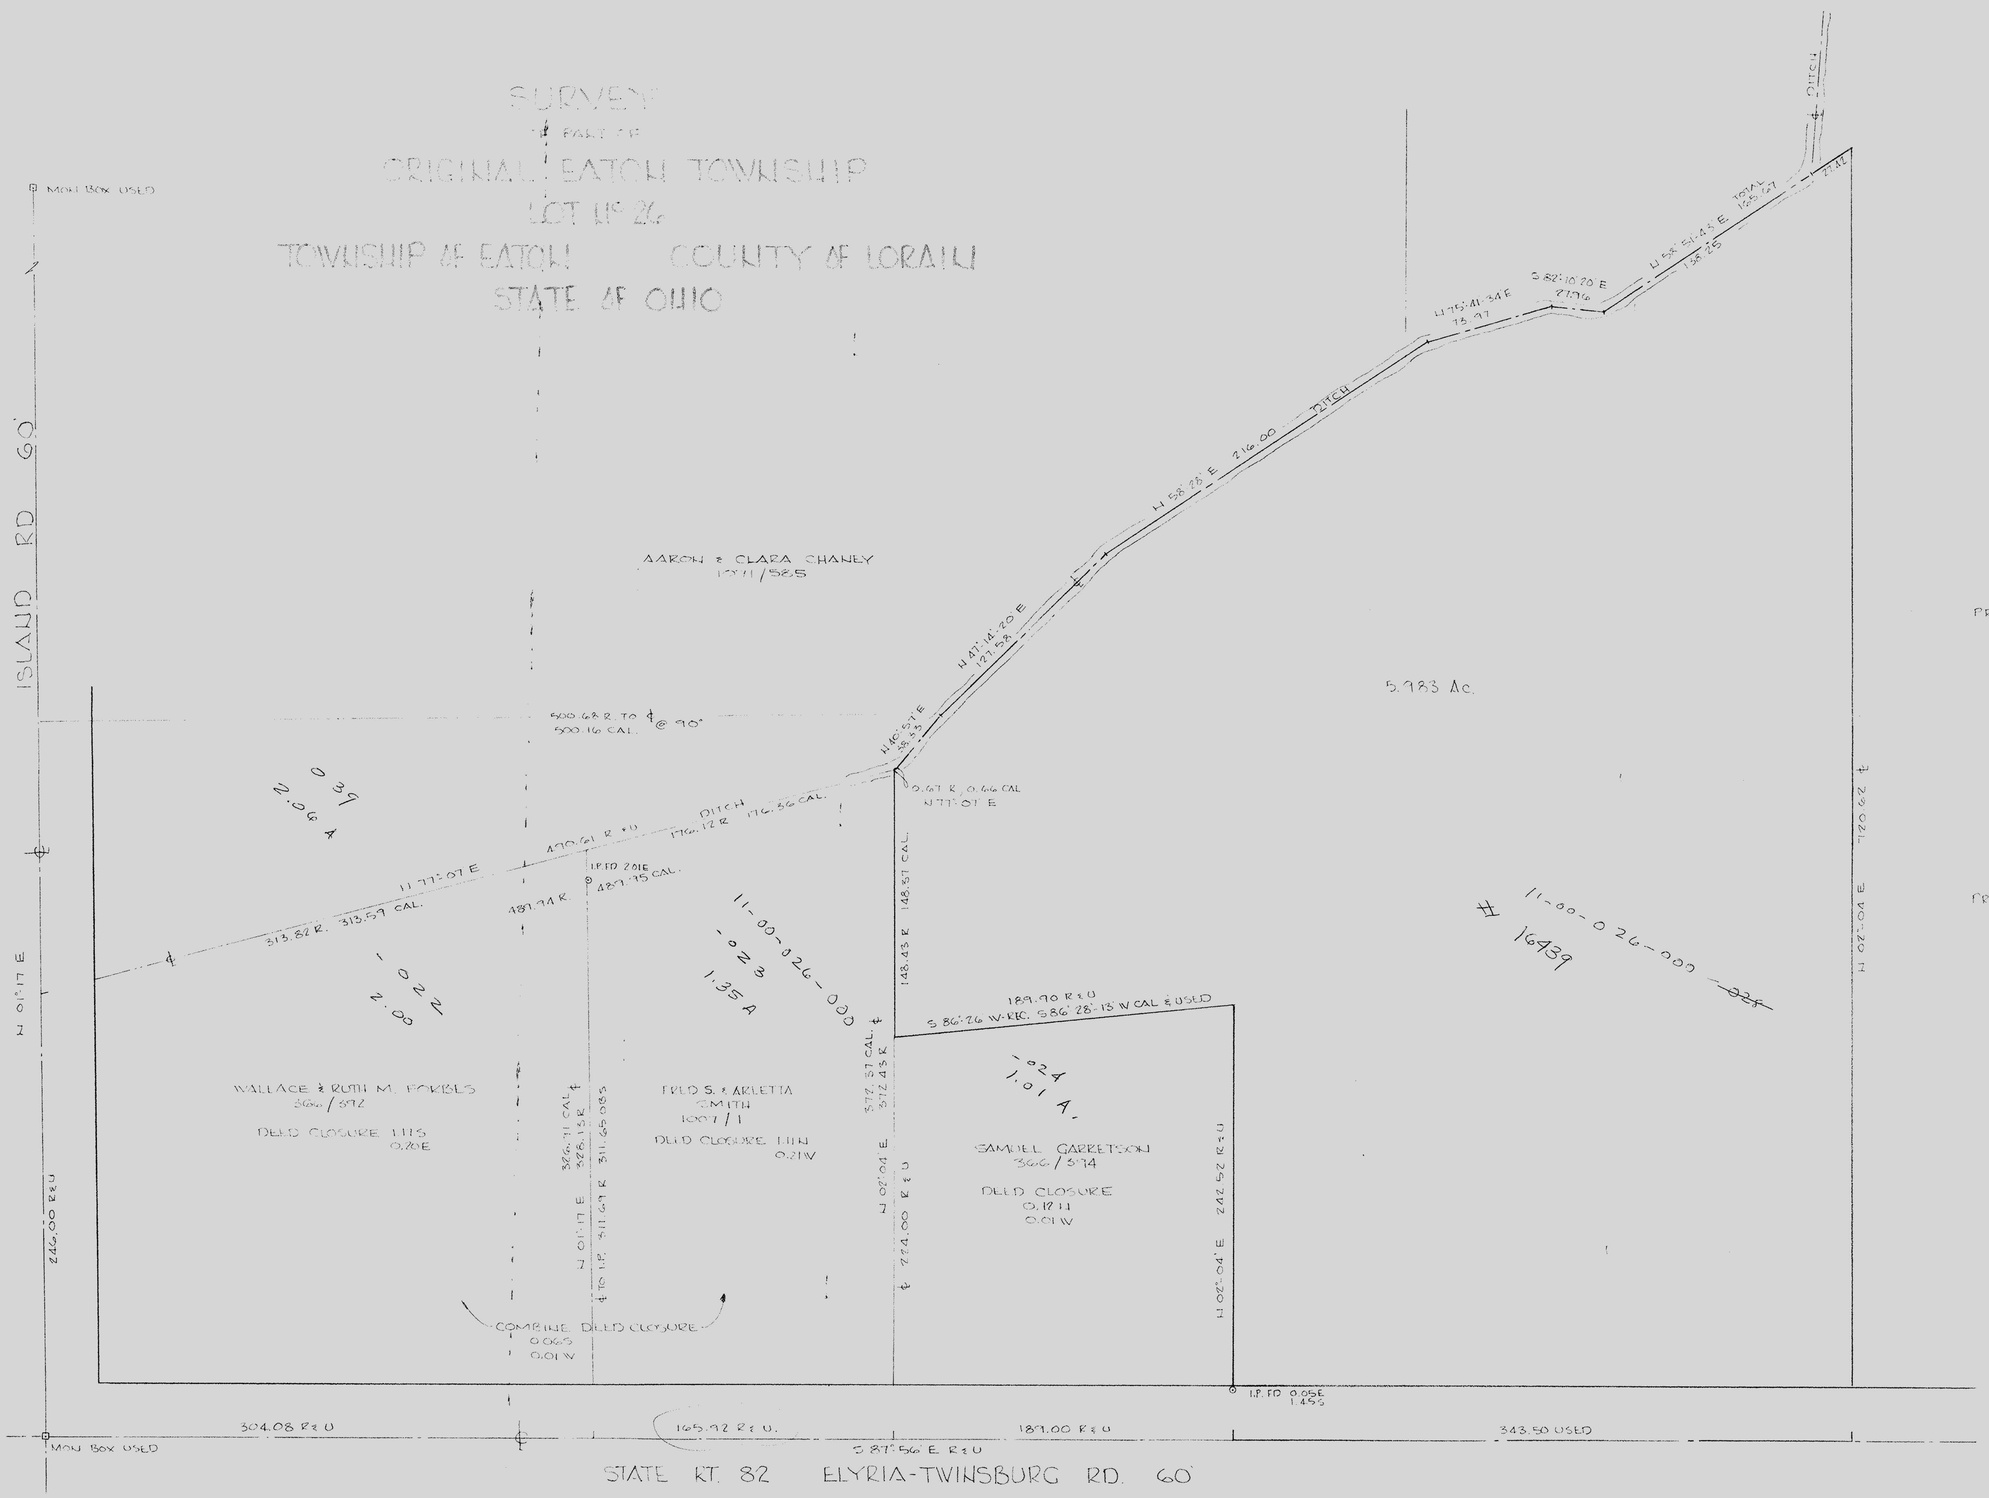

N

DATE: JAN. 1986
SCALE: 1" = 40'

PREPARED FOR:
GARNET S. MENCL
AND
WAYNE F. SCHROTH et al.
AND/OR
MIDLAND TITLE SECURITY
119 EAST AVE.
ELYRIA, O.

PREPARED BY:
HAPONEK AND ASSOC INC.
SURVEYORS & ENGINEERS
N RIDGEVILLE, O

NOTE:
NO PERMANENT ℄ MONUMENTS WERE FOUND ON STATE RT. 82 EAST OF ISLAND RD. PROPERTY LINES WERE RE-ESTABLISHED USING RECORD INFORMATION FROM DEEDS SHOWN AND THE PERMANENT MONUMENTS FOUND ON ISLAND RD.

APPROVED
LORAIN CO.
MAP DEPT.
DATE 1-13-86
PAGE 11 00 026 A
027 A, B
BY T. McNair
VOID

#16439

68-91 #

74-41