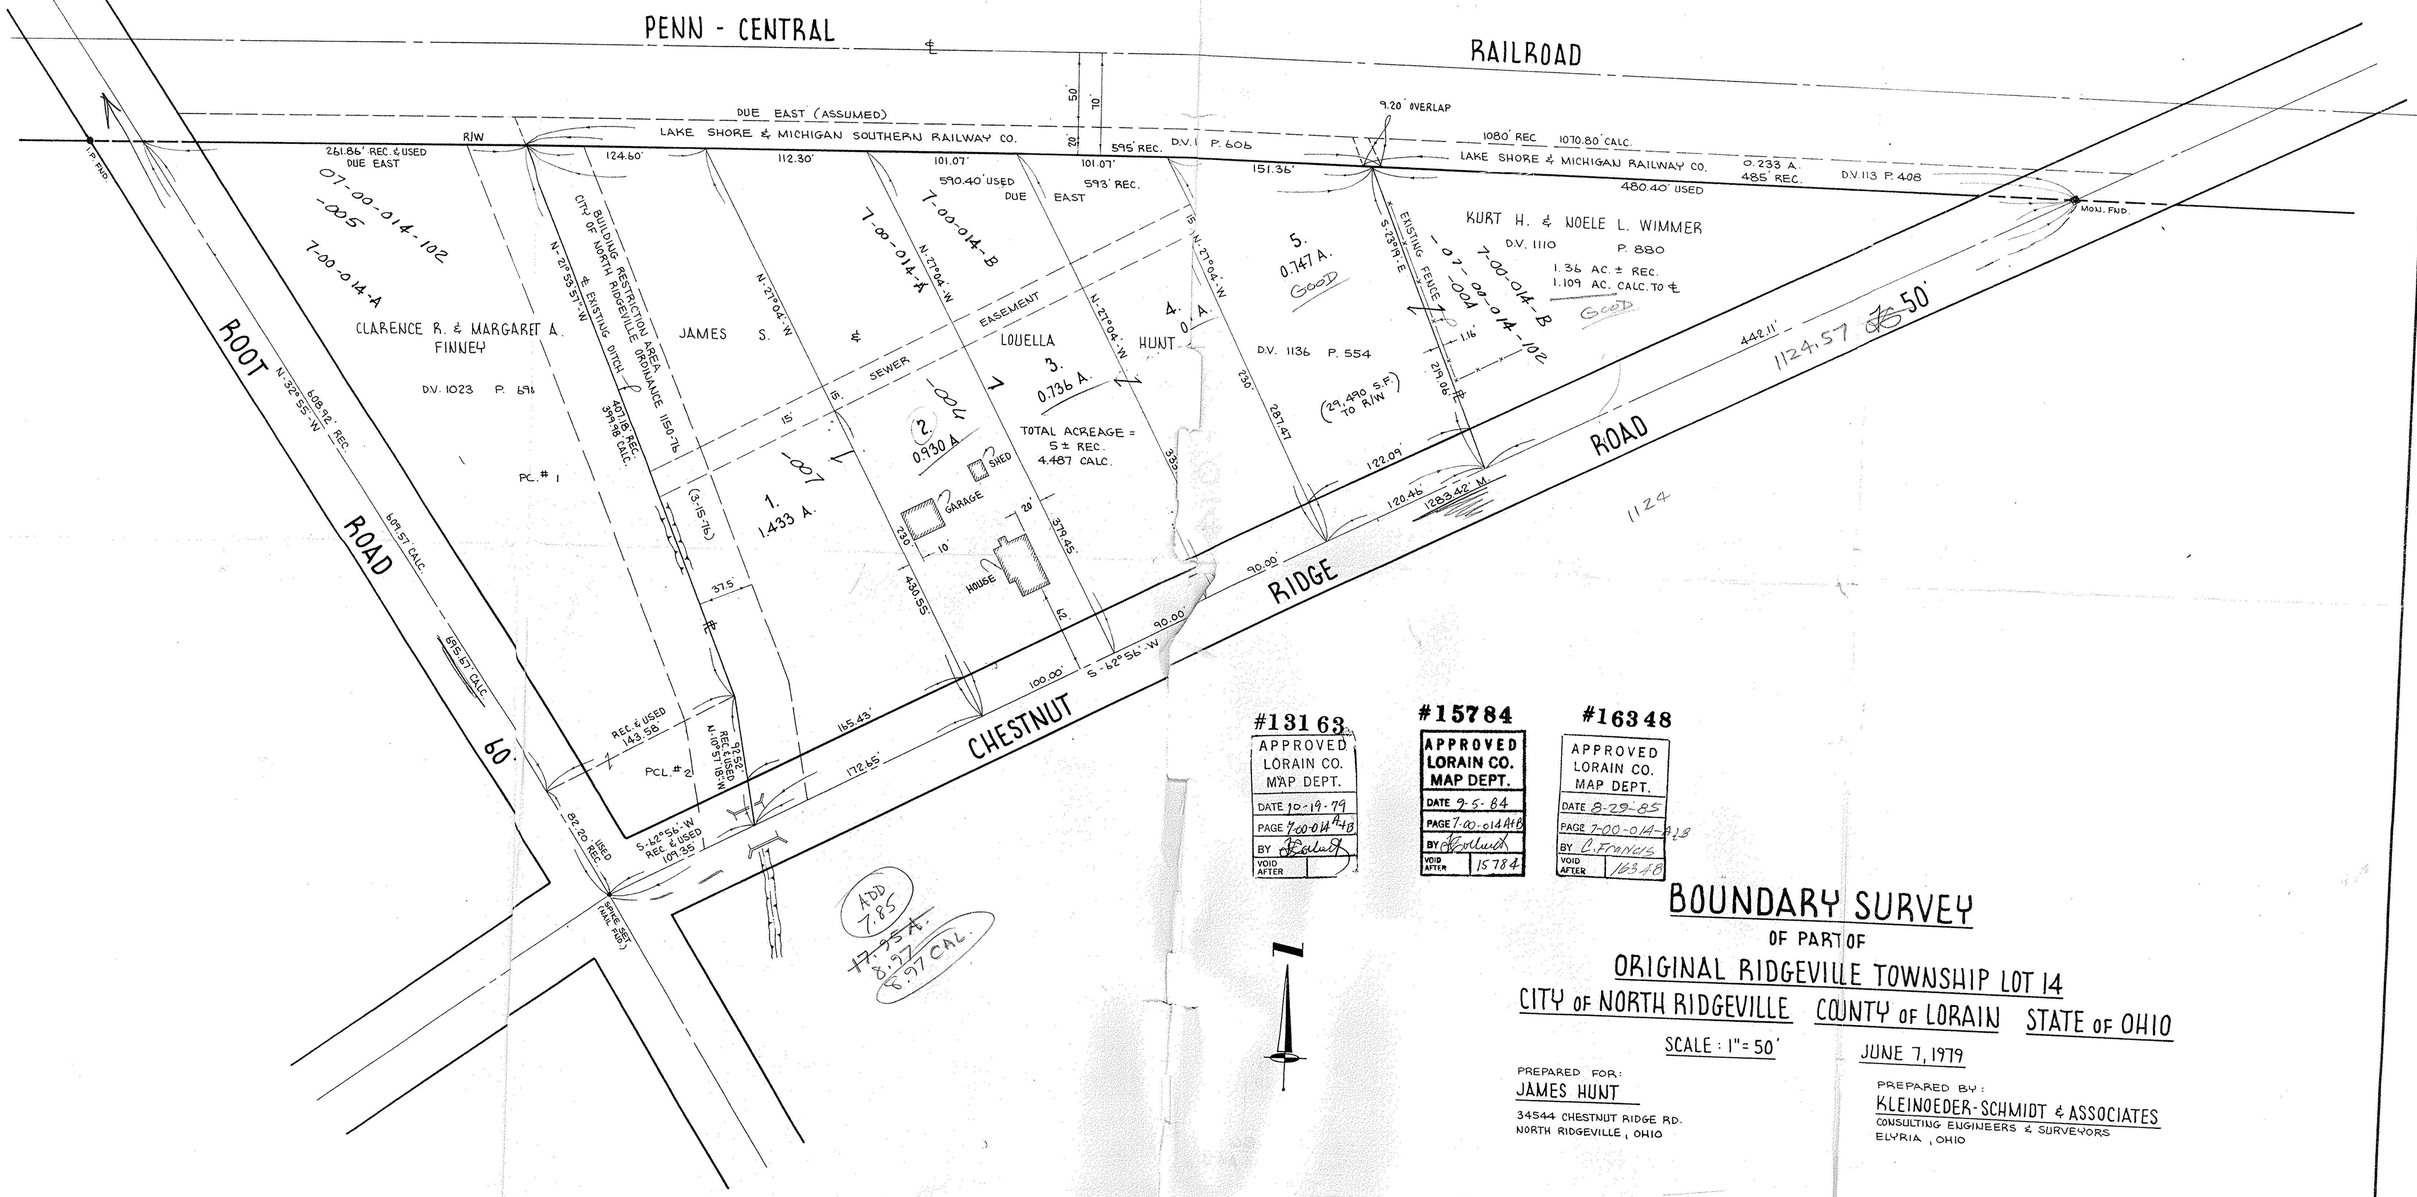

#13163
APPROVED
LORAIN CO.
MAP DEPT.
DATE 10-19-79
PAGE 7-00-014 A+B
BY
VOID AFTER

#15784
APPROVED
LORAIN CO.
MAP DEPT.
DATE 9-5-84
PAGE 7-00-014 A+B
BY
VOID AFTER 15784

#16348
APPROVED
LORAIN CO.
MAP DEPT.
DATE 8-29-85
PAGE 7-00-014-A+B
BY C. FRANCIS
VOID AFTER 16348

BOUNDARY SURVEY

OF PART OF

ORIGINAL RIDGEVILLE TOWNSHIP LOT 14

CITY OF NORTH RIDGEVILLE COUNTY OF LORAIN STATE OF OHIO

SCALE : 1" = 50'

JUNE 7, 1979

PREPARED FOR:
JAMES HUNT
34544 CHESTNUT RIDGE RD.
NORTH RIDGEVILLE, OHIO

PREPARED BY:
KLEINOEDER-SCHMIDT & ASSOCIATES
CONSULTING ENGINEERS & SURVEYORS
ELYRIA, OHIO

