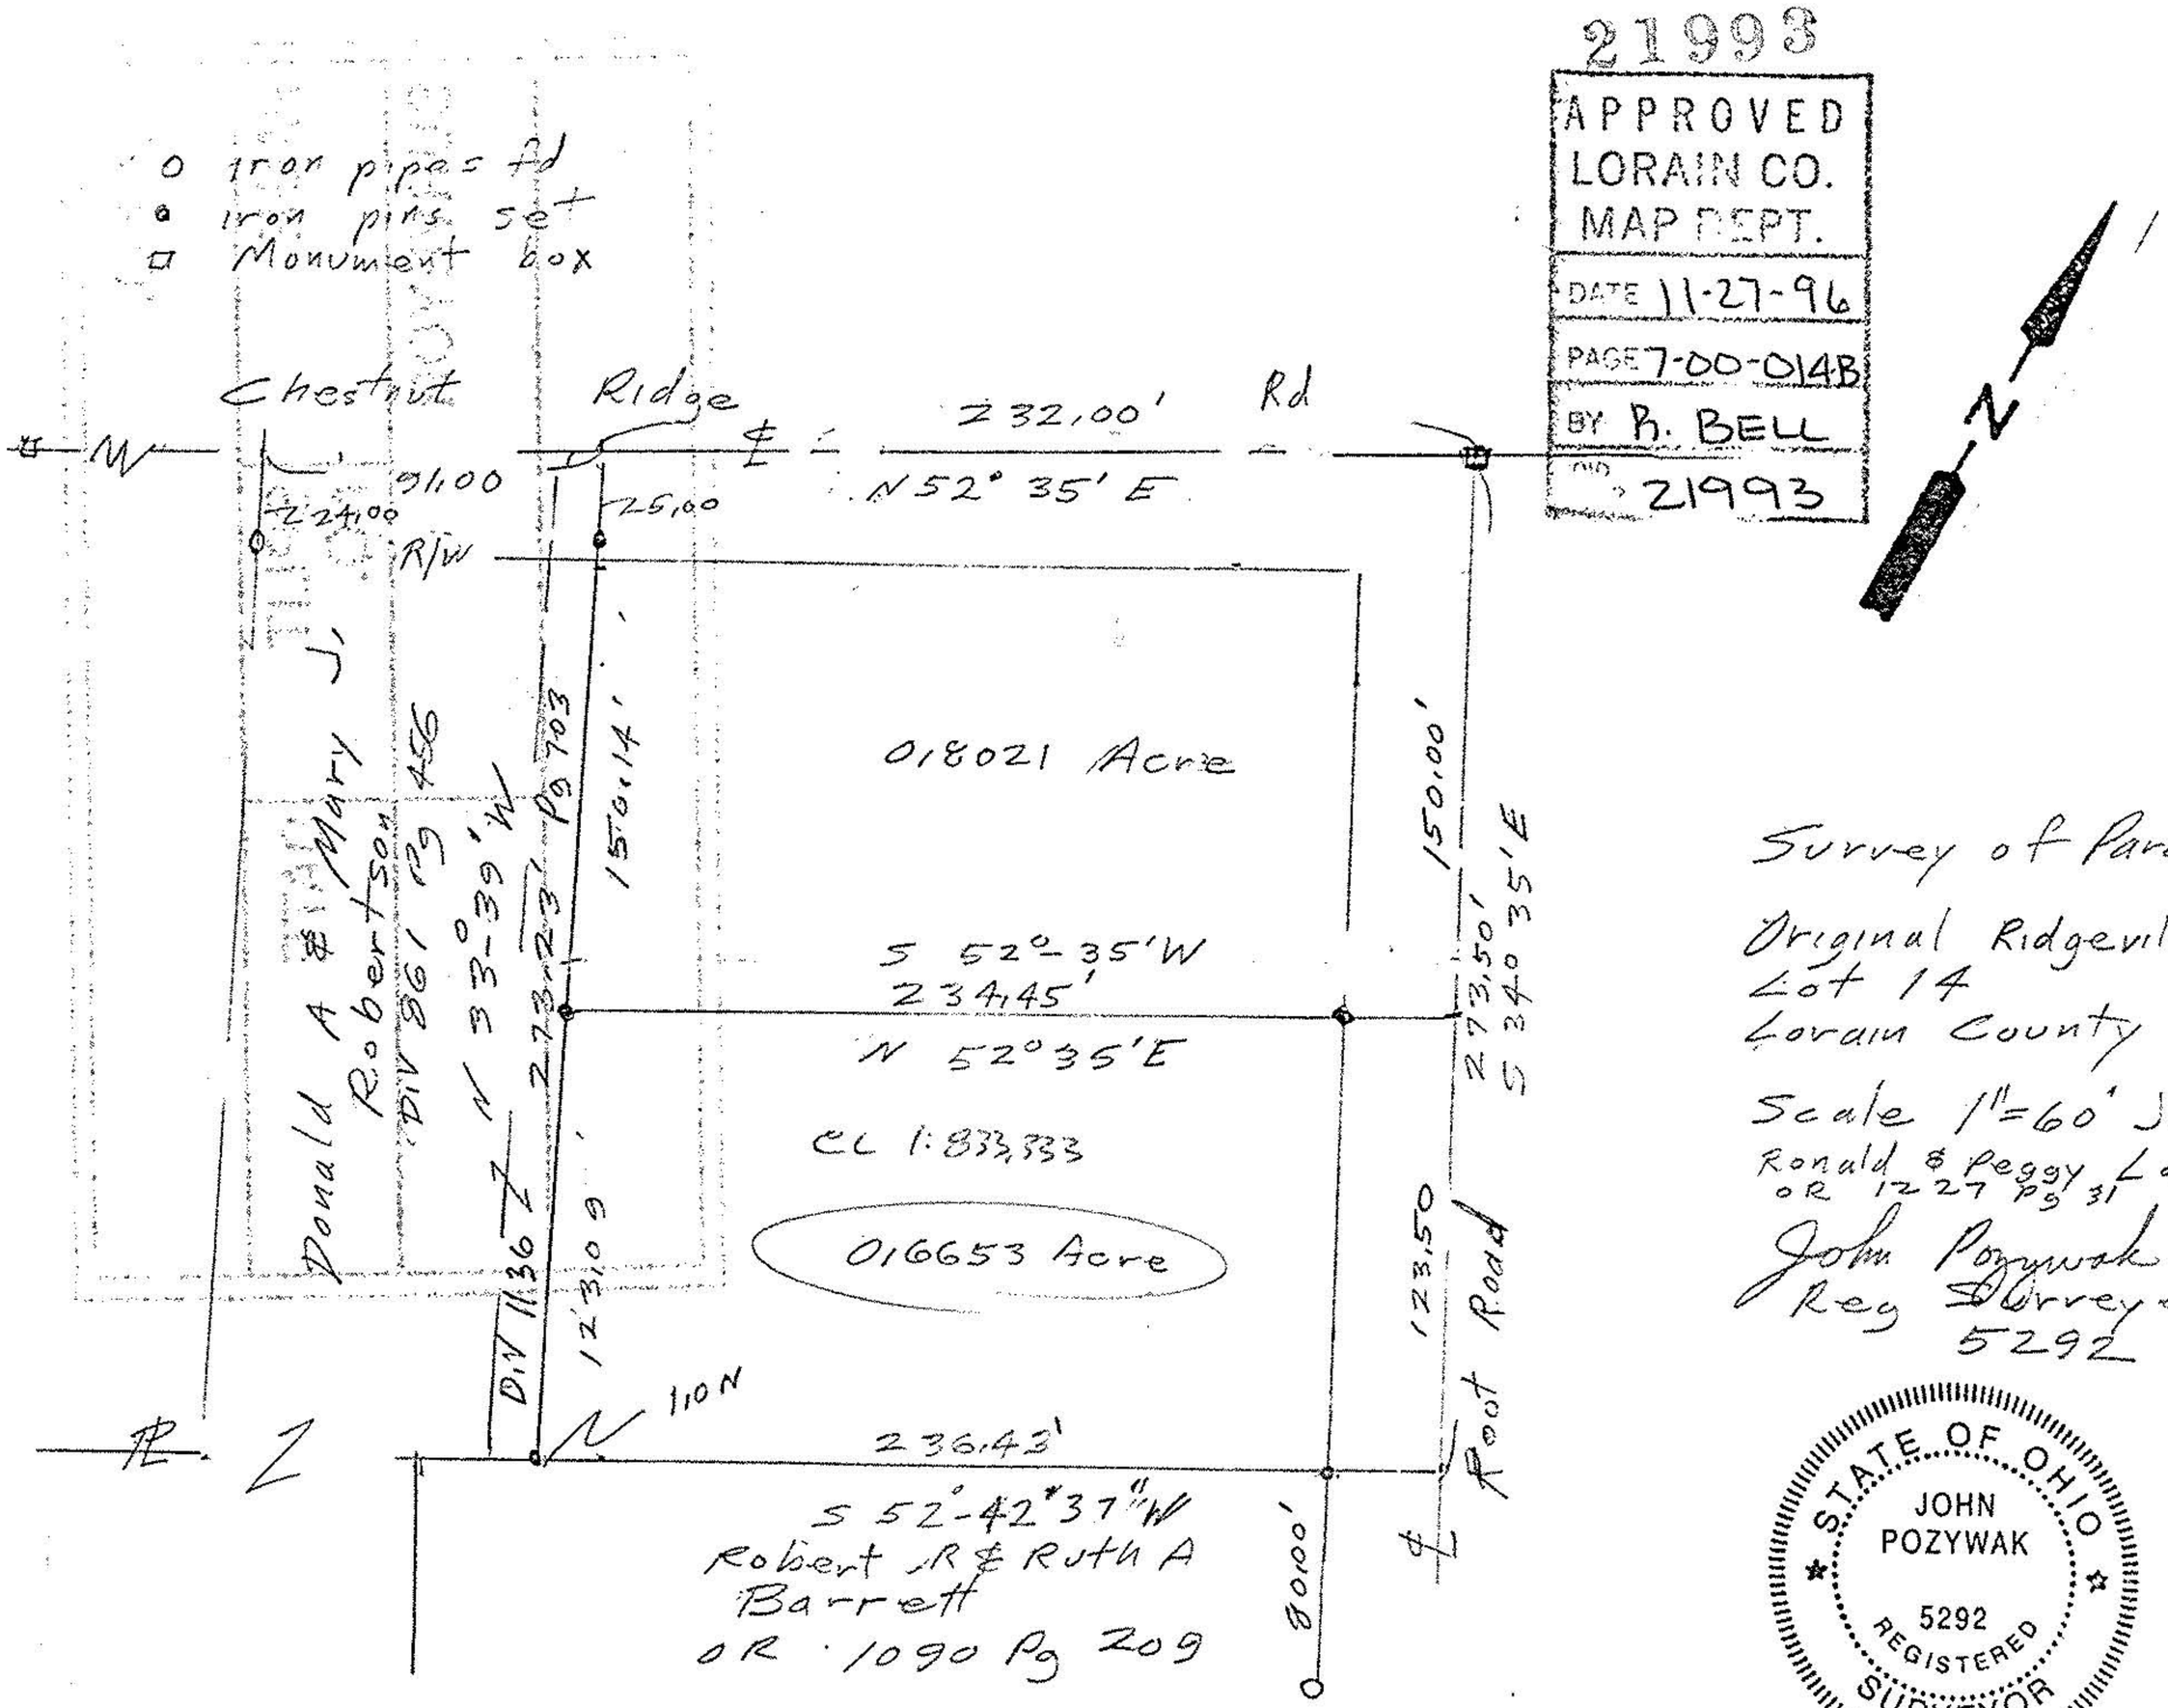

Survey of Parcel Splits

Original Ridgeville Township
Lot 14
Lorain County Ohio

Scale 1"=60' July 1996
Ronald & Peggy Lafollette
OR 1227 Pg 31

John Pozywak
Reg Surveyor
5292

STATE OF OHIO
JOHN POZYWAK
5292
REGISTERED
SURVEYOR