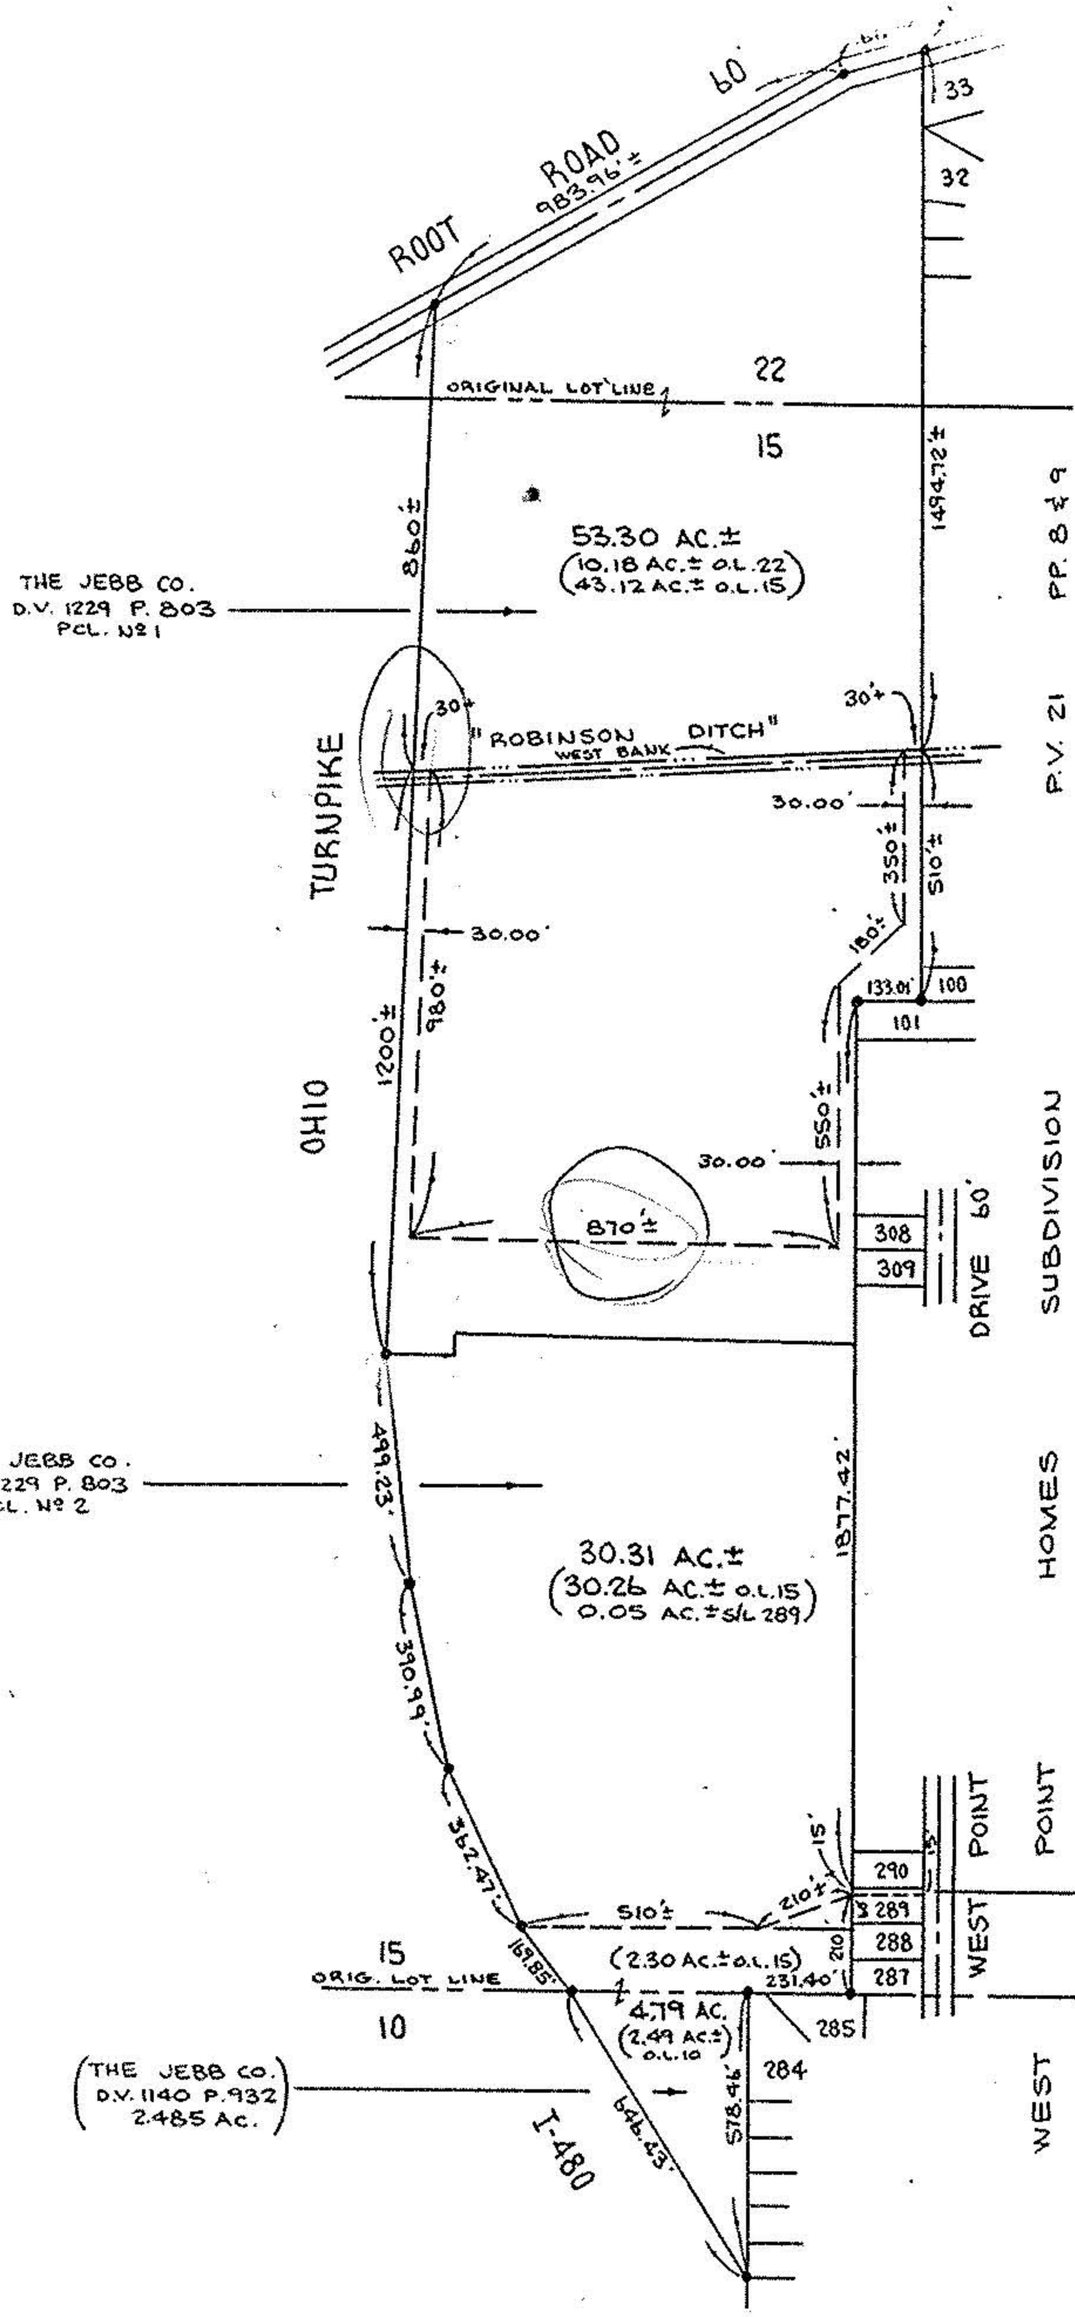

#13393

#13393

APPROVED
LORAIN CO.
MAP DEPT.
DATE 2-6-80
PAGE 7-00-015-A&B
BY T. McNair
VOID AFTER

NOTE: THIS MAP PREPARED FROM RECORD ONLY.
NOT A PLAT OF SURVEY.

Prepared for: THE JEBB CO.

Scale: 1" = 500'

Date: FEB. 6, 1980

7-00-015 A & B

7-00-015

7-00-015-110-05