


7-00-014-A
7-00-023-B,D

1708

07-00-014-103-129
07-00-023-102-029

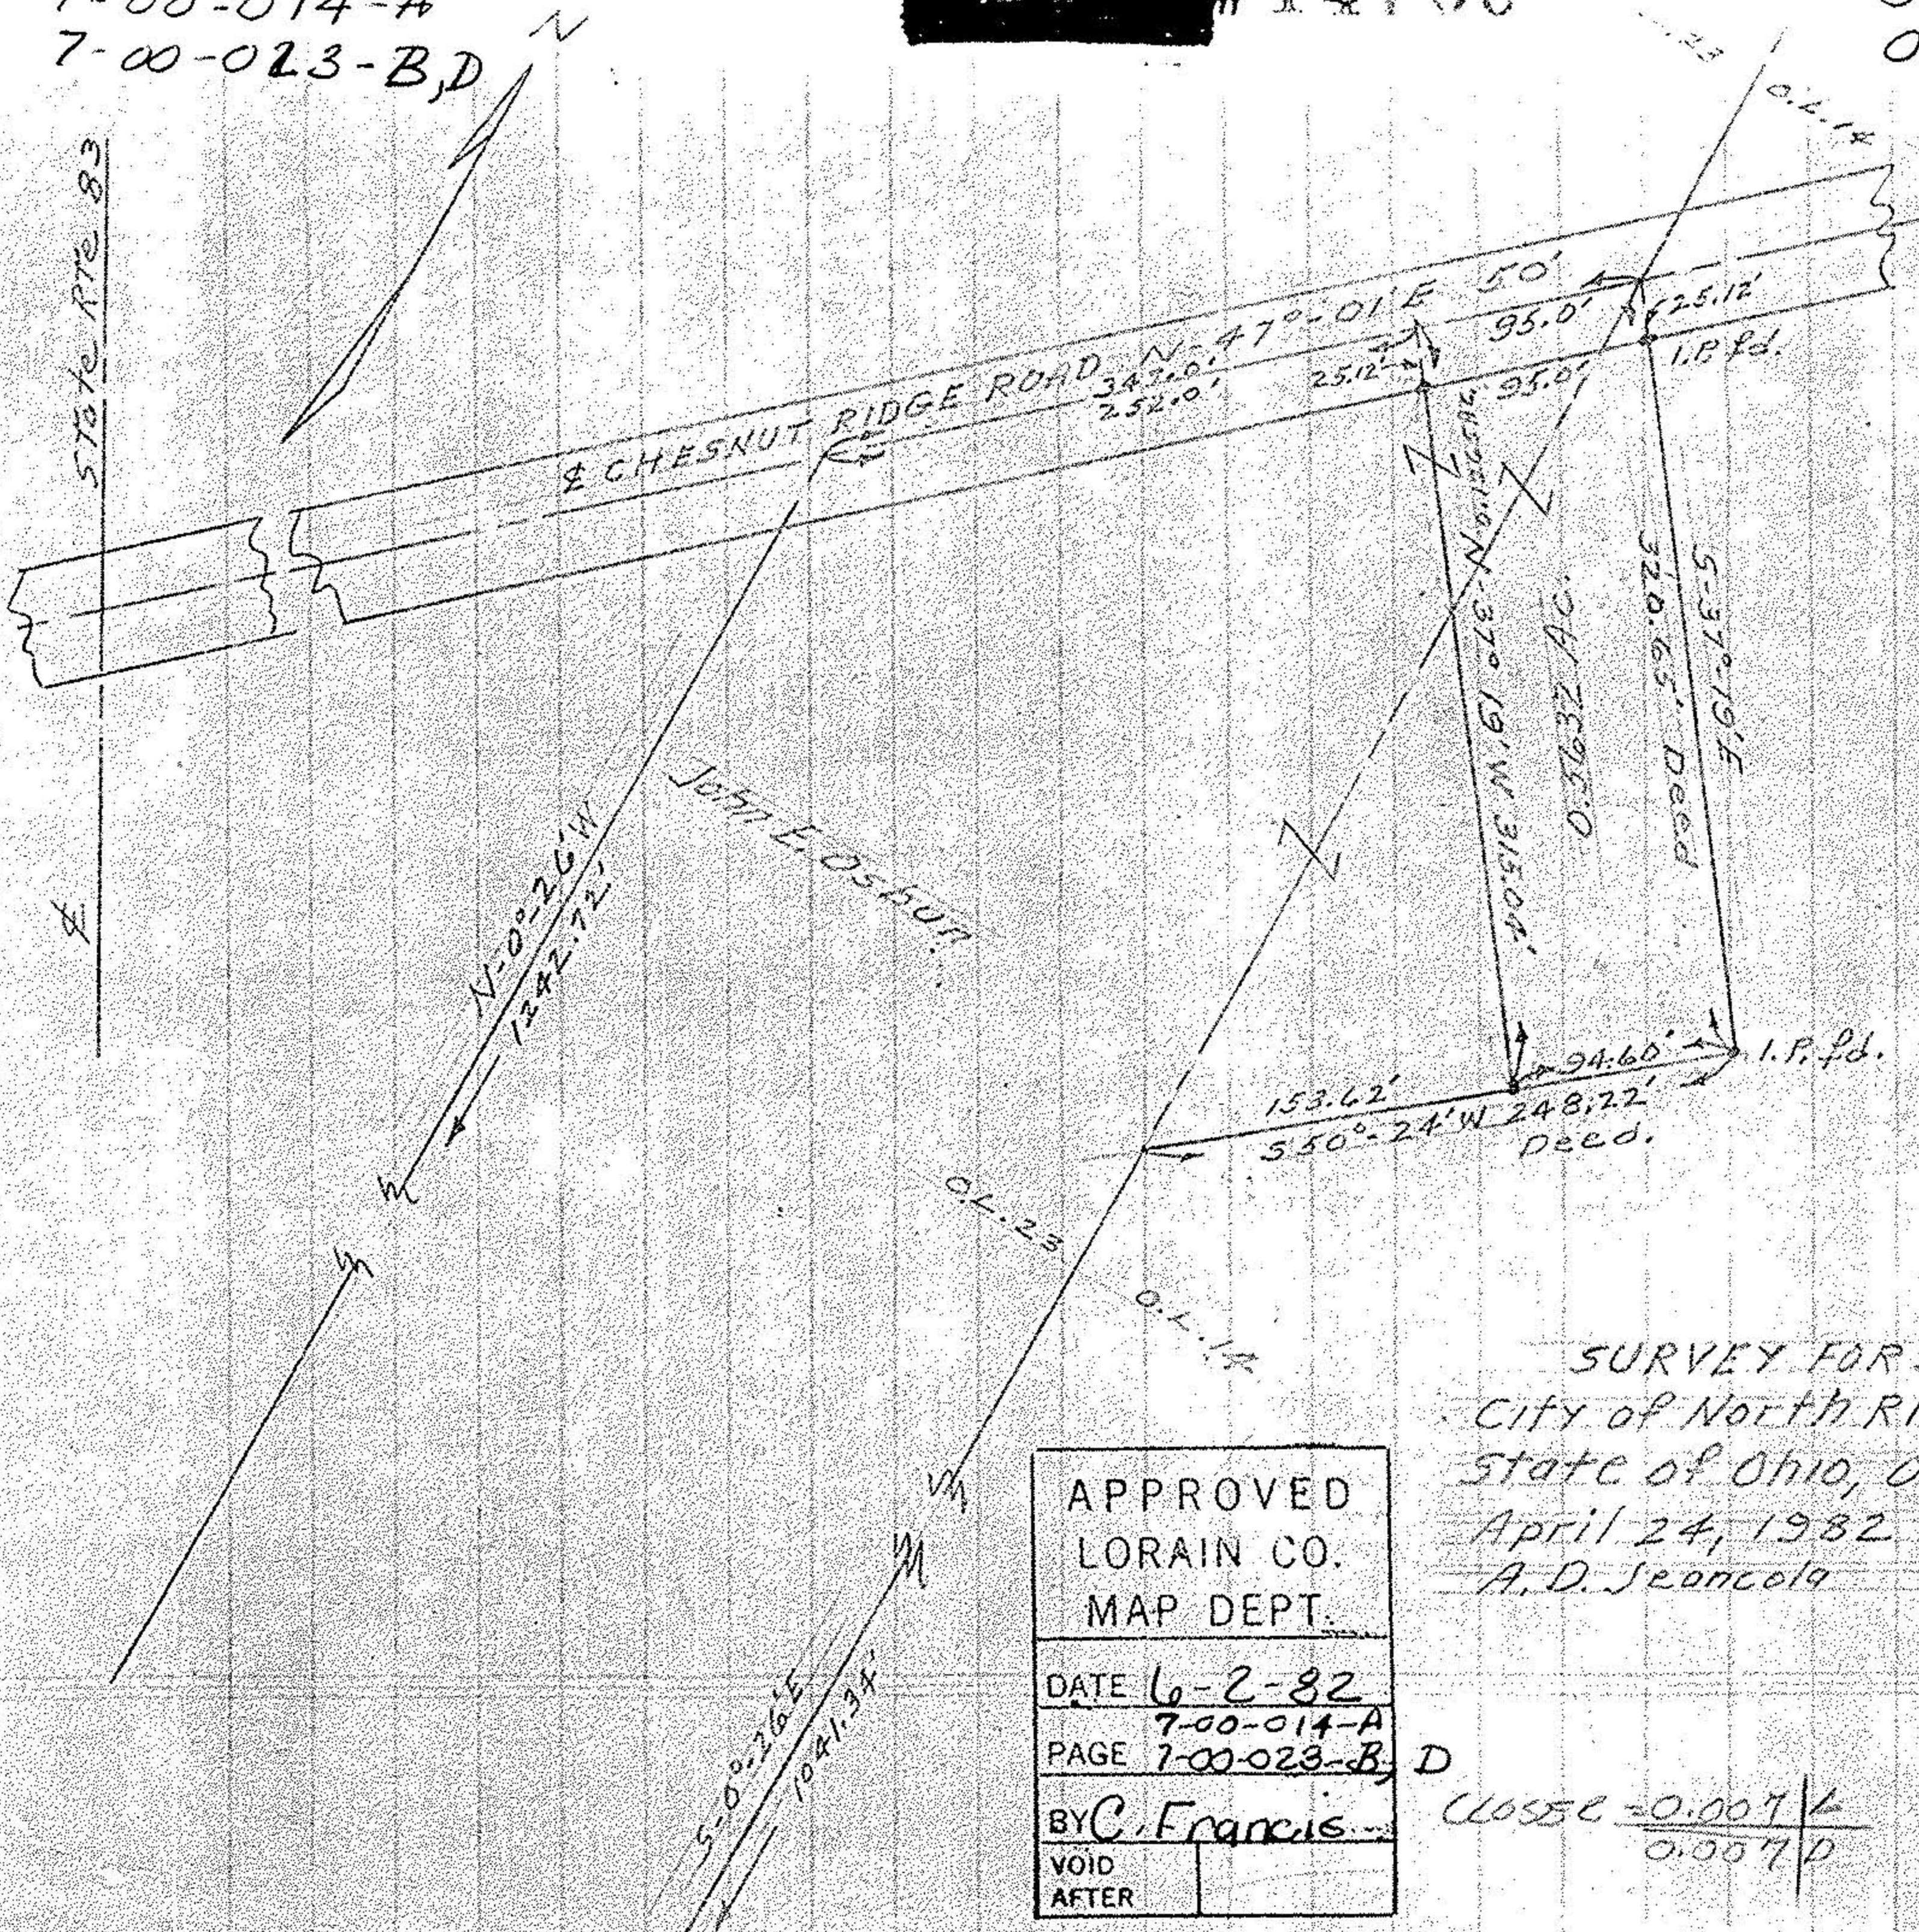

SURVEY FOR JOHN E. OSBUN ST.
 City of North Ridgeville, County of Lora
 State of Ohio, O.L. 23, 14.
 April 24, 1982 Scale 1 inch = 100.0 ft
 A. D. Jeancola Reg. Surveyor

APPROVED	
LORAIN CO.	
MAP DEPT.	
DATE	6-2-82
PAGE	7-00-014-A 7-00-023-B, D
BY	C. Francis
VOID AFTER	

CLOSE = 0.007 / 4
 0.007 / D

1:76423 (signature)