HAPONEK & ASSOCIATES, INC. Engineers & Surveyors

34100 Center Ridge Road • NORTH RIDGEVILLE, OHIO 44039 • (216) 327-4776 • Lorain 288-4400

APPROVED
LORAIN CO.
MAP DEPT.
DATE 9-14-90
PAGE 11-00-051-B
BY CAROLYN FRANCIS
AFTER #19128

#19128

11-00-051-B

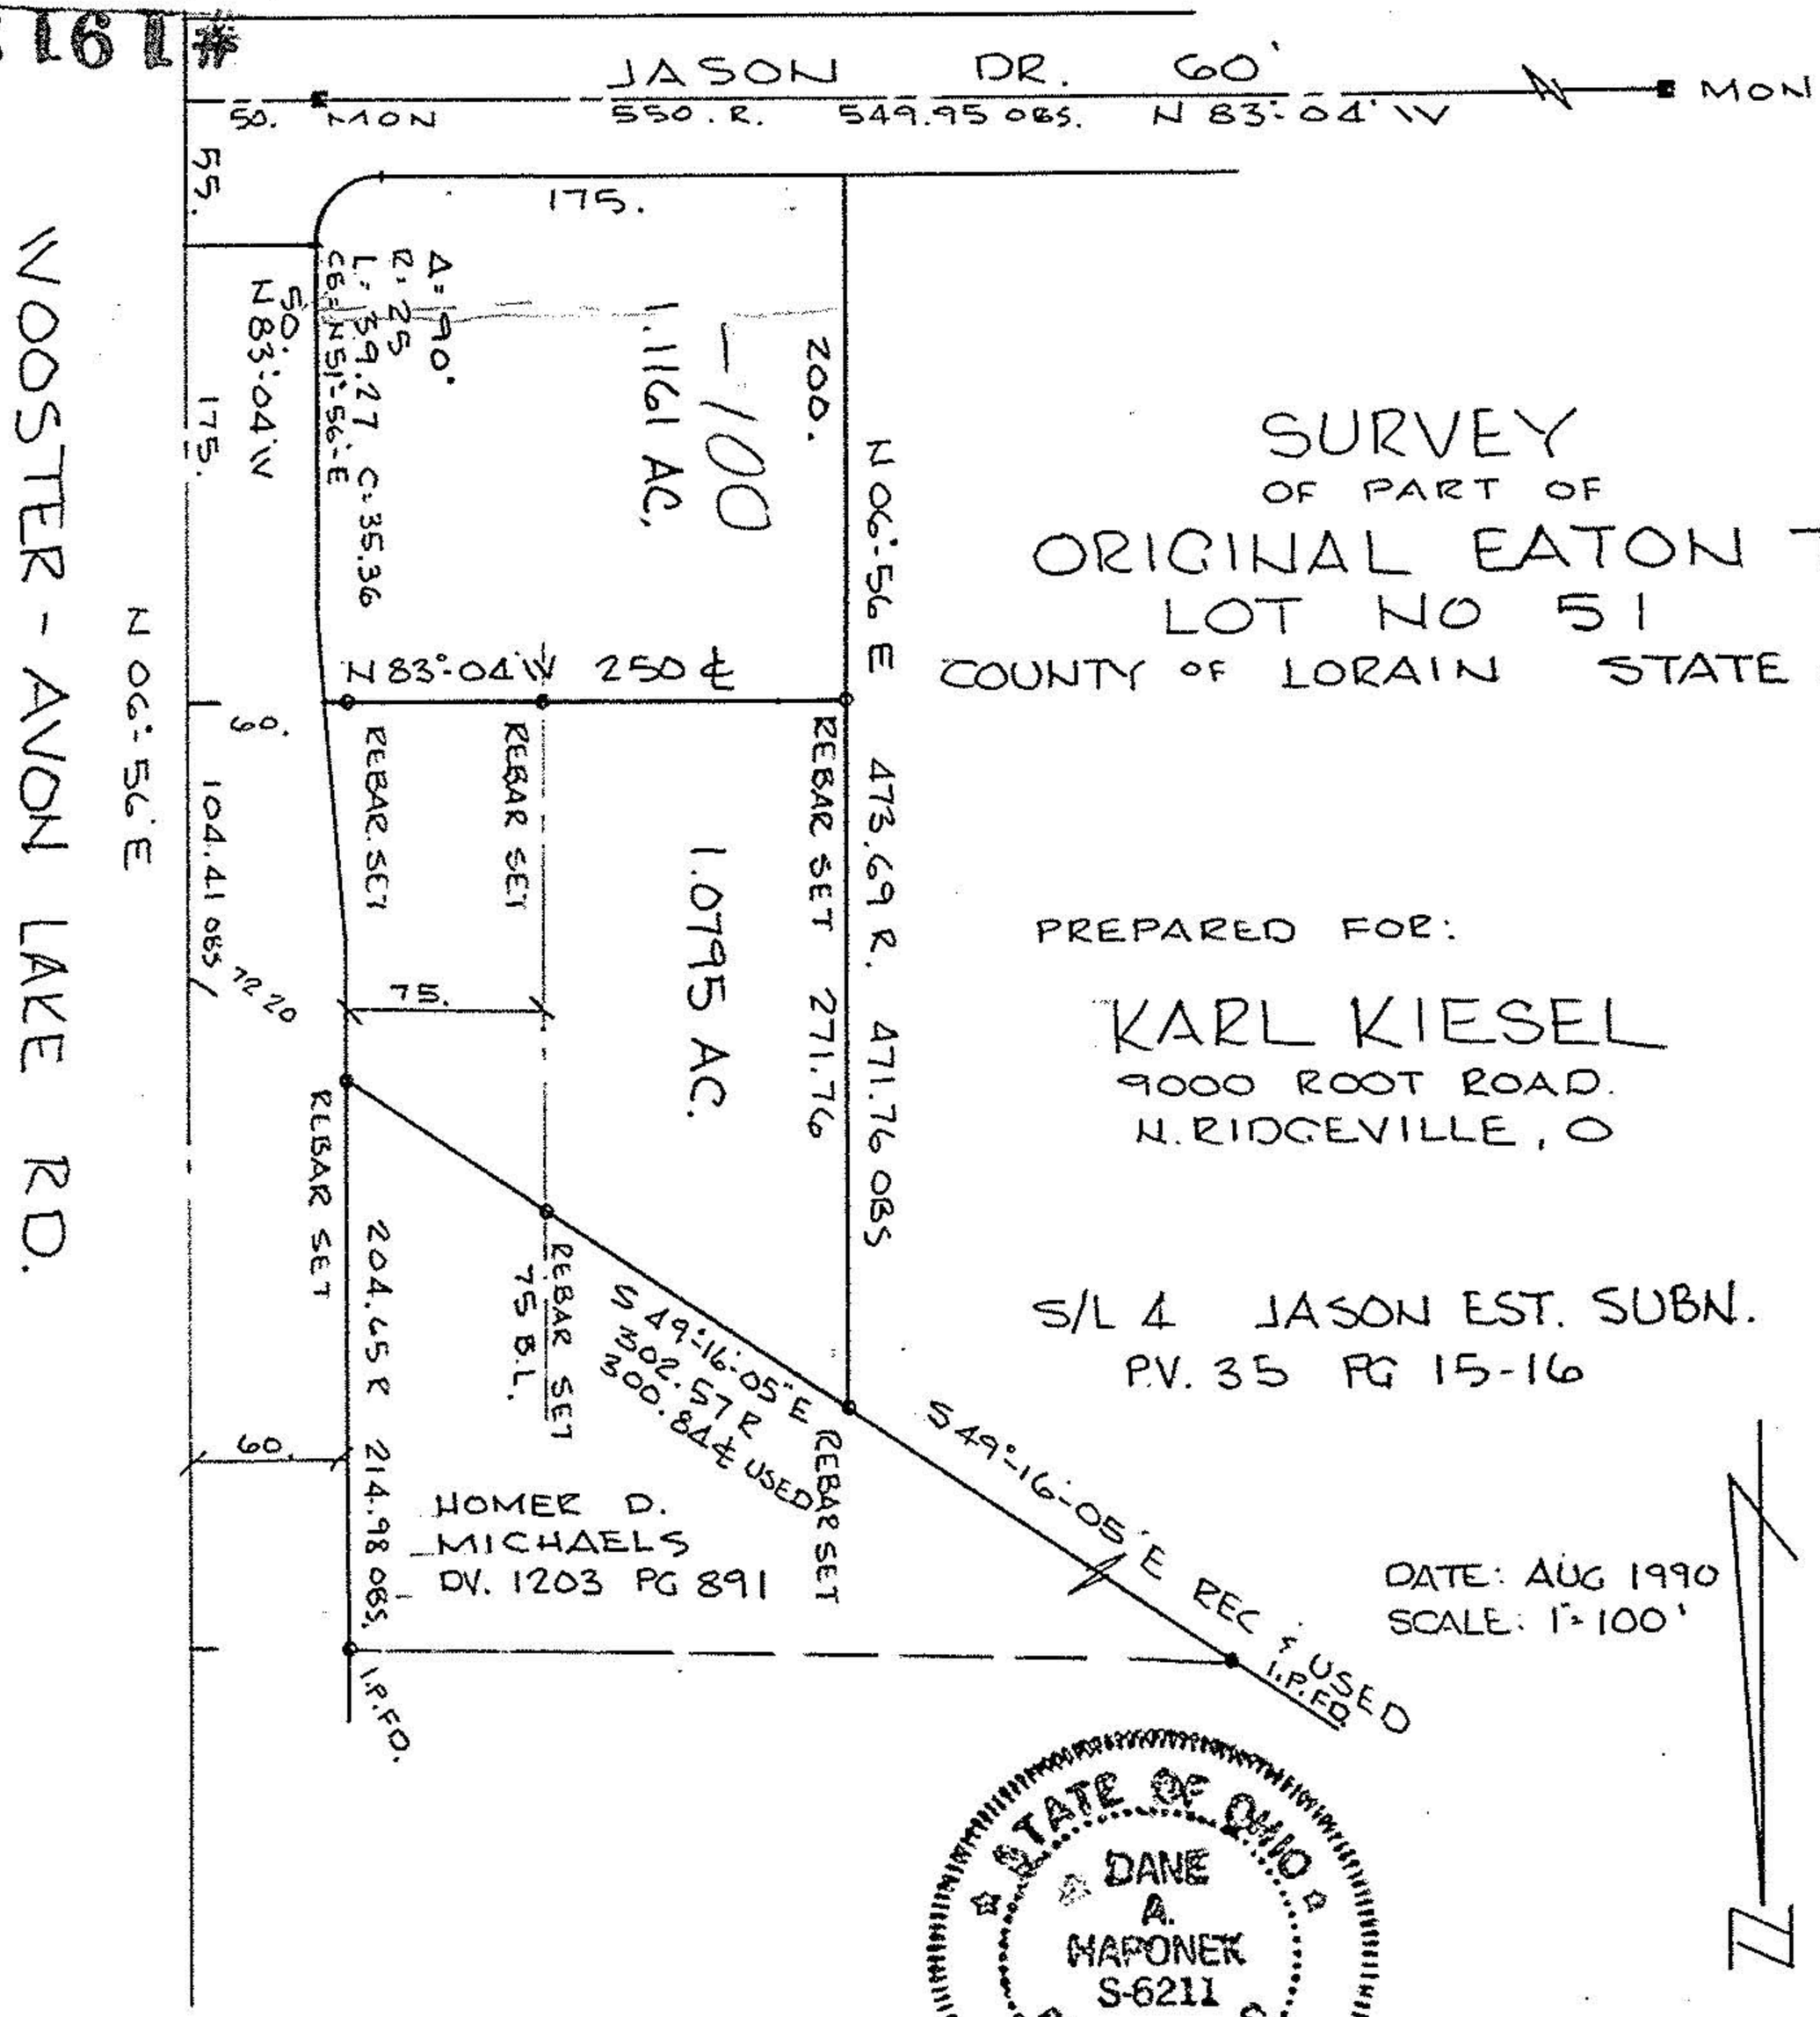

SURVEY
OF PART OF
ORIGINAL EATON TWP
LOT NO 51
COUNTY OF LORAIN STATE OF OHIO

PREPARED FOR:

KARL KIESEL
9000 ROOT ROAD.
N. RIDGEVILLE, O

S/L 4 JASON EST. SUBN.
P.V. 35 PG 15-16

DATE: AUG 1990
SCALE: 1"=100'

STATE OF OHIO
DANE A. HAPONEK
S-6211
REGISTERED SURVEYOR

#19128

11-00-051-000-100

101