



#15325
15287

11-00 - 054-000

NOTES: \circ indicates iron pin found
unless otherwise designated.
• indicates iron pin set unless otherwise designated.

AC CORR.
#15325

APPROVED
LORAIN CO.
MAP DEPT.
DATE 10.24.83
PAGE 11-B
BY T. McNair
VOID AFTER

PLAT OF SURVEY FOR
JAMES E. & JEAN V. COBB
ORIGINAL LOT 54. EATON-TOWNSHIP
LORAIN COUNTY OHIO
SCALE: 1"=100'
MAY-1978
Gary E. Parfoum. Reg. Surveyor No. 4457

#15287
#15325

432.64
455
453.64

0.2.53
0.2.54

Locate Wtr. Line from hose to pond
for easement purposes

16.864
+ 0.562 - Slack
17.426 - Total
- 1.770
15.656
3.214 - Ternes & Slack

16.864
1.770
15.094

Robert Ross & Sons, Inc.
Parcel No. 2 D. Vol. 1180 Pg. 206


Robert Ross & Sons, Inc. Parcel No. 2 D. Vol. 1180 Pg. 206

Gail & Icie Sue Cogar
D. Vol. 933 Pg. 660
- 00 G N. 85°45'10"W.
245.00'

Philip G. & Marie G.
Slack 0.562 Ac.
D. Vol. 986 Pg. 436
245.00'
N. 85°45'10"W.
I.P. Replaced

James R. Ternes
9-17-79 1244/843
2.65A.

12.442
AC.
16.864 ACRES

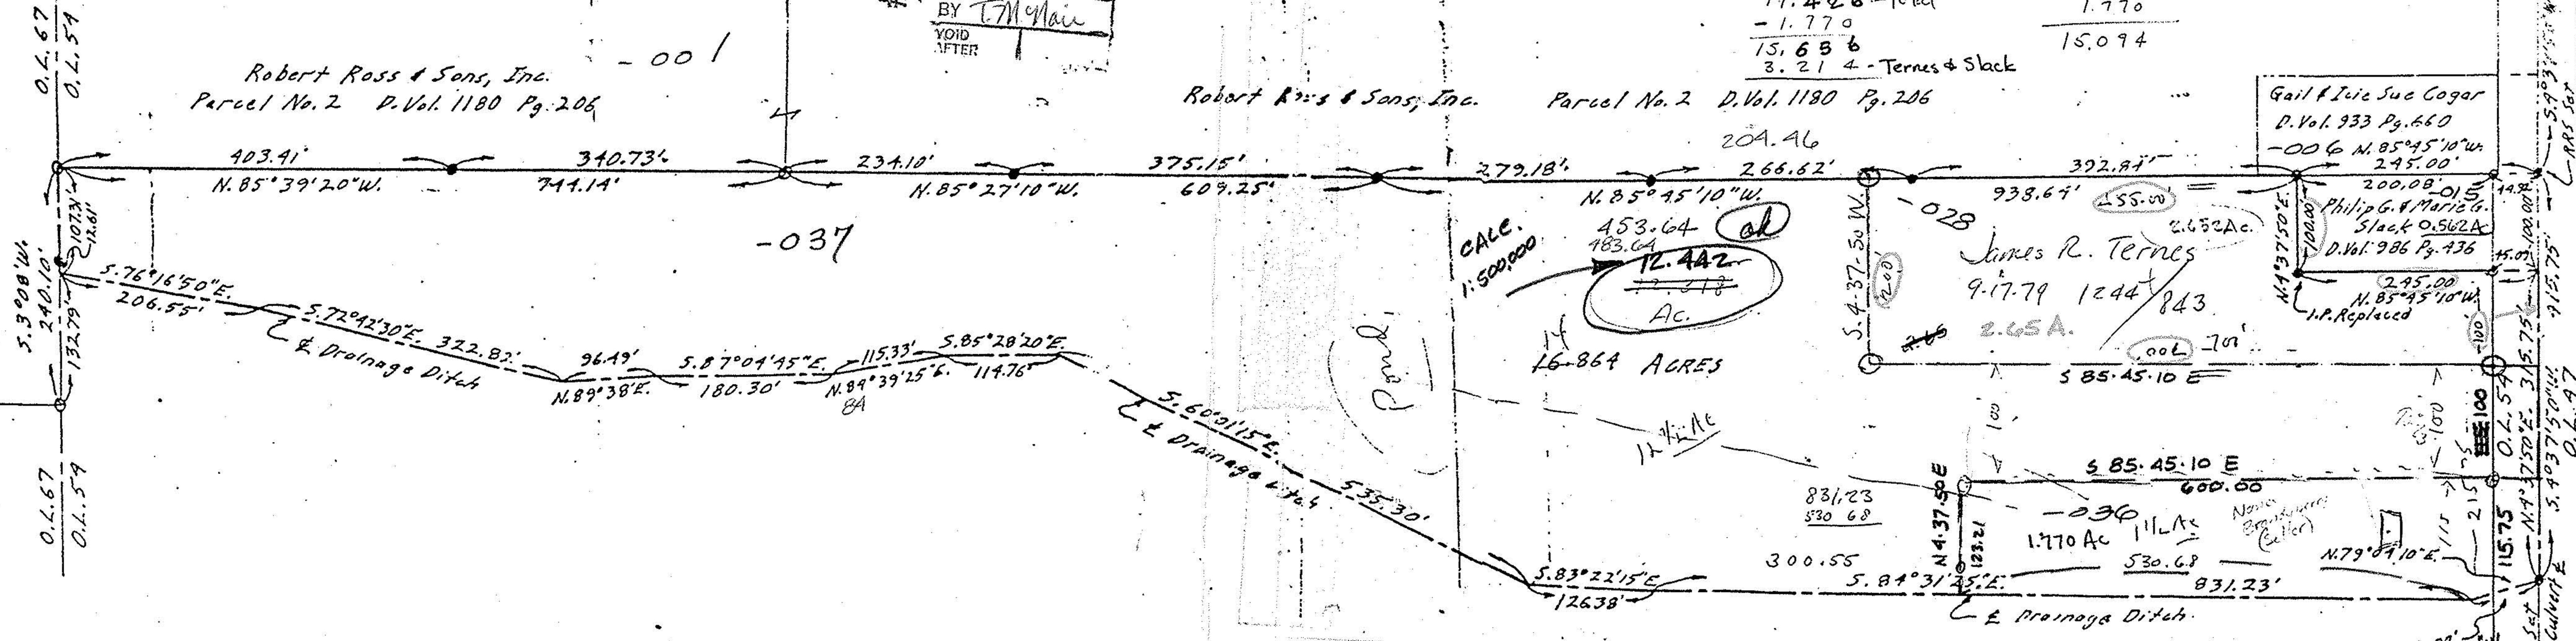

AVON-BELDEN ROAD STARR ROUTE B3

3.214
362
3.652

451
245
700

85-45-10
4 37-30
90-23-00

#15287
APPROVED
LORAIN CO.
MAP DEPT.
DATE 10.13.83
PAGE 11-B
BY T. McNair
VOID AFTER