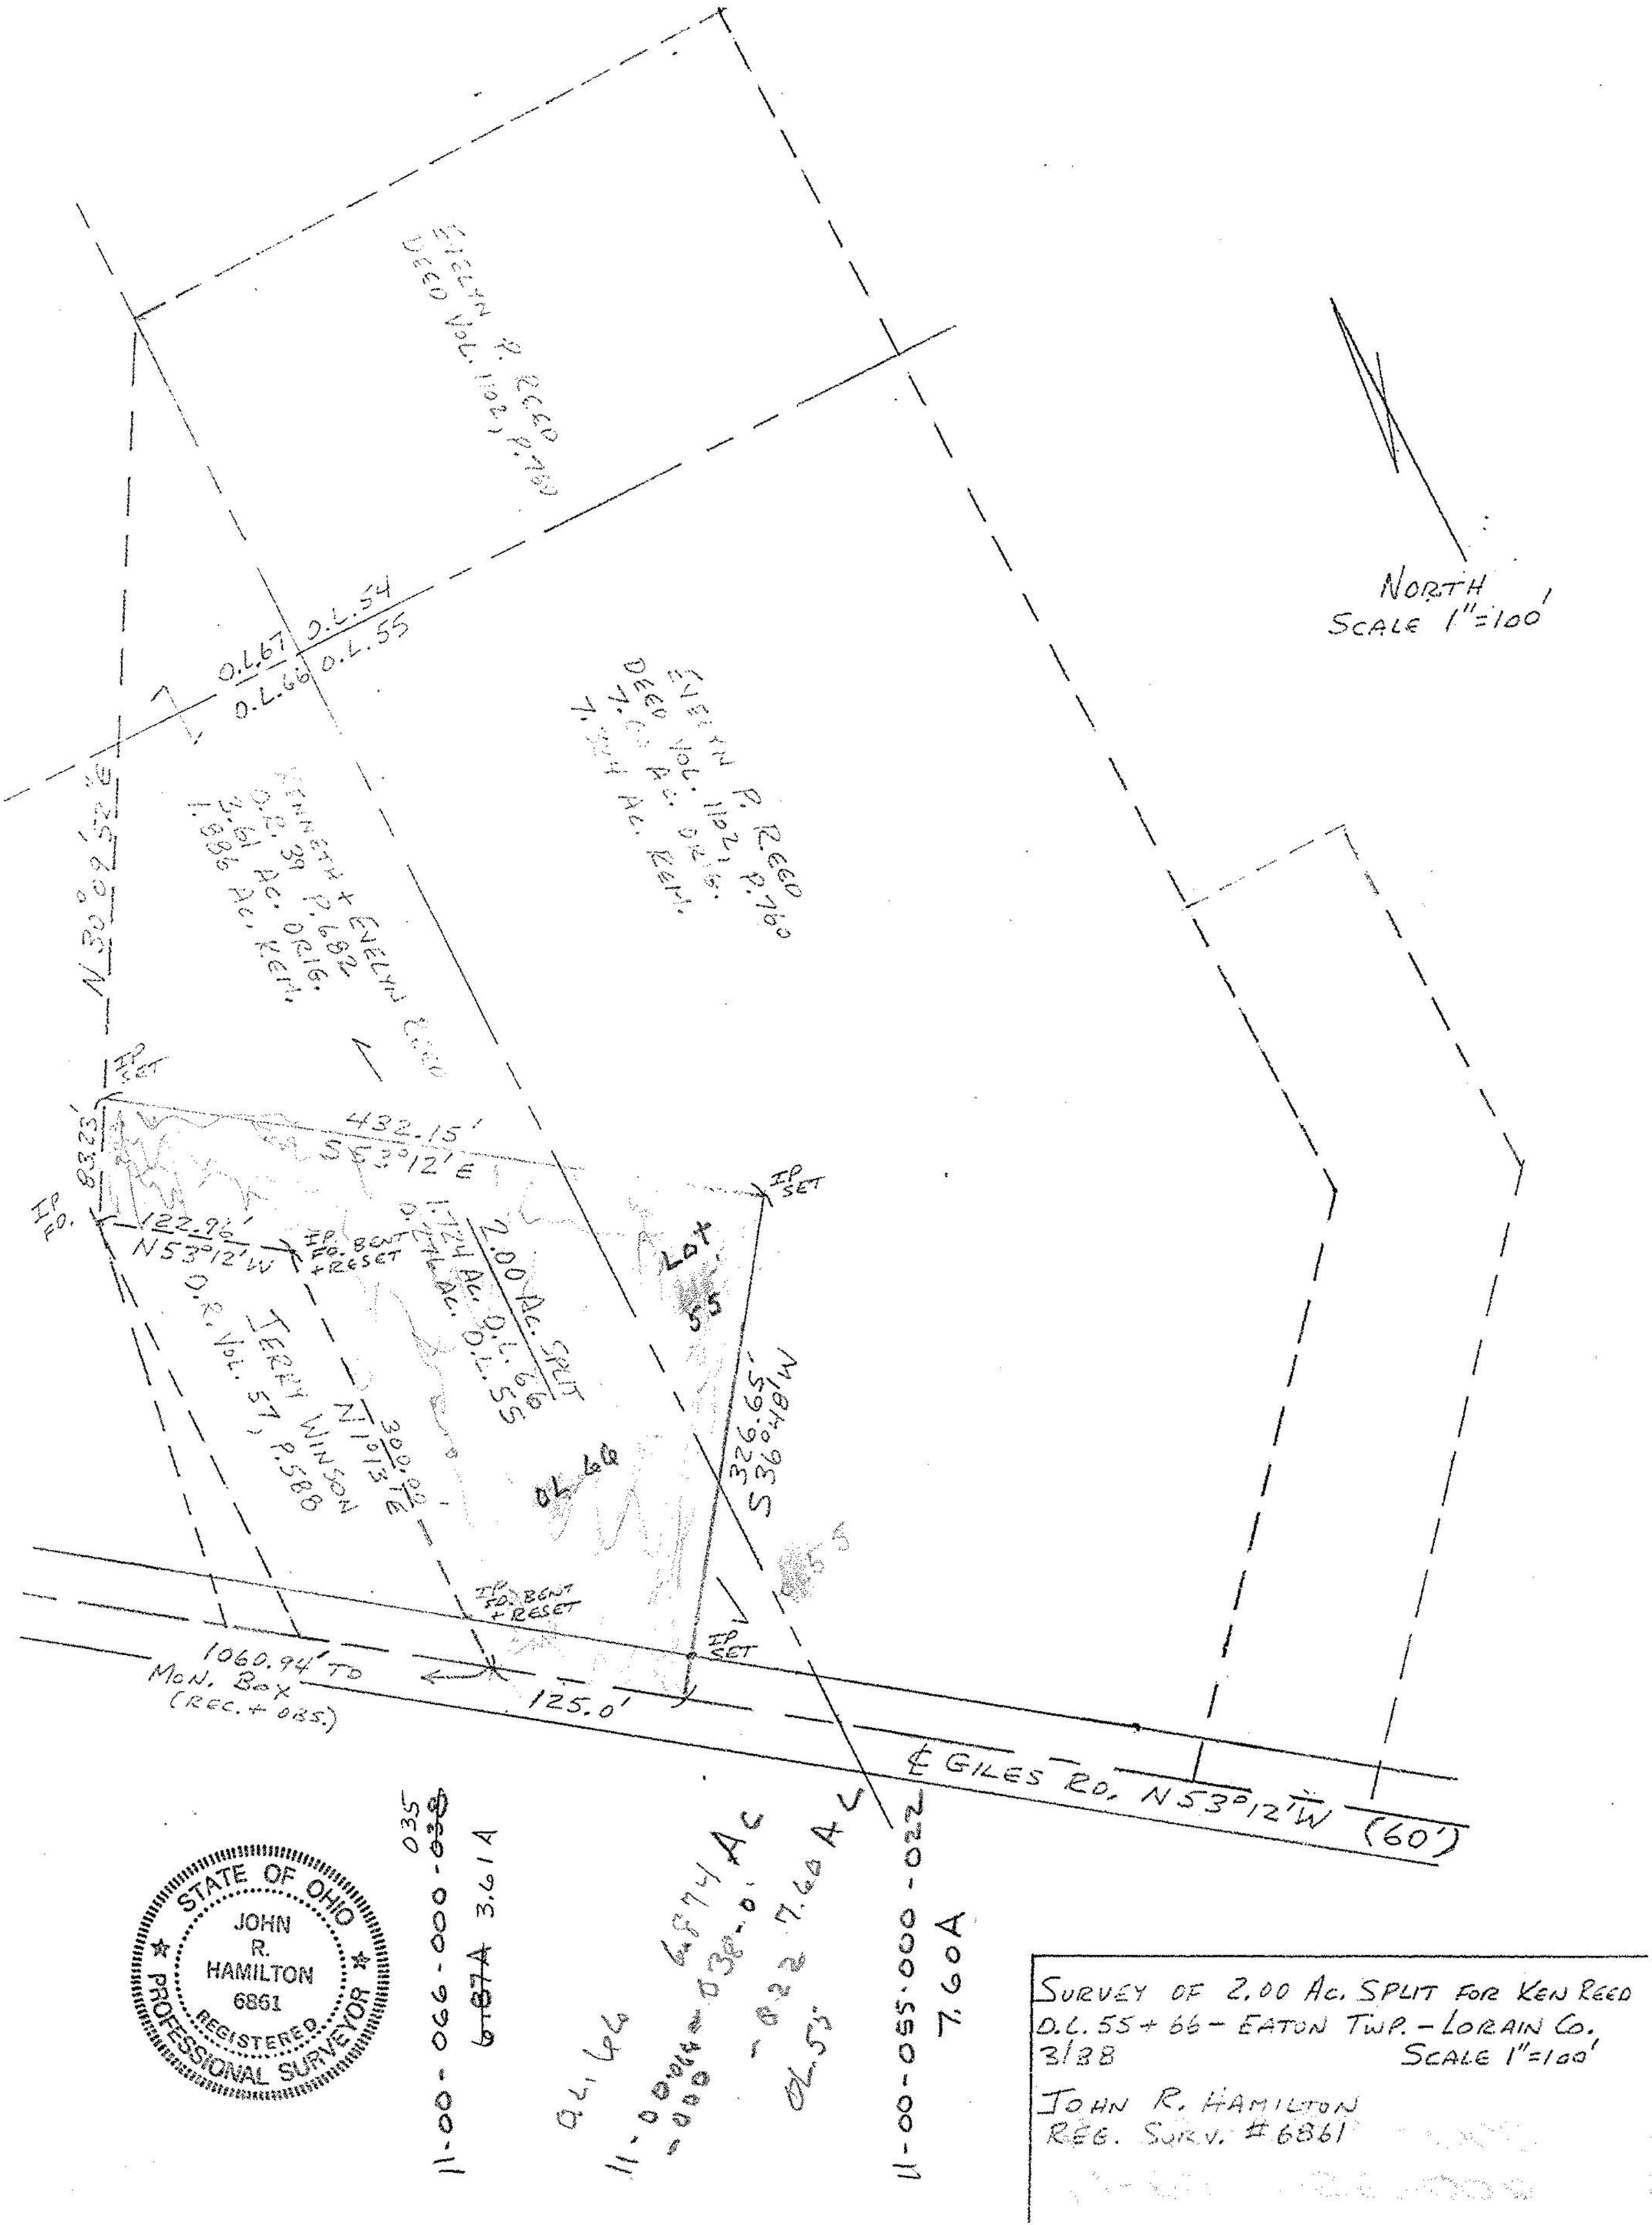

STATE OF OHIO
JOHN R. HAMILTON
6861
REGISTERED PROFESSIONAL SURVEYOR

Survey of 2.00 Ac. Split for Ken Reed
D.L. 55 + 66 - Eaton Twp. - Lorain Co.
3/88 Scale 1" = 100'

John R. Hamilton
Reg. Surv. # 6861