anne Nicholas
4824 Scotch Pine Way
Ridgeville, OH 44039-2342

SURVEY

OF PART OF

ORIGINAL EATON TWP.

LOT Nos 54 AND 55

COUNTY OF LORAIN STATE OF OHIO

TOTAL 99.1613 AC.

PREPARED FOR:

LELAND DURKEE
11615 AVON BELDEN RD.
GRAFTON, OH.

PREPARED BY:

DANE A. HAPONEK
ENGINEERS & SURVEYORS
N. RIDGEVILLE, OH.

STATE OF OHIO
DANE
A.
HAPONEK
S-6211
REGISTERED
SURVEYOR

REVISION PREPARED FOR:

DIANE NICHOLAS
4824 SCOTCH PINE WAY
N RIDGEVILLE, OH.

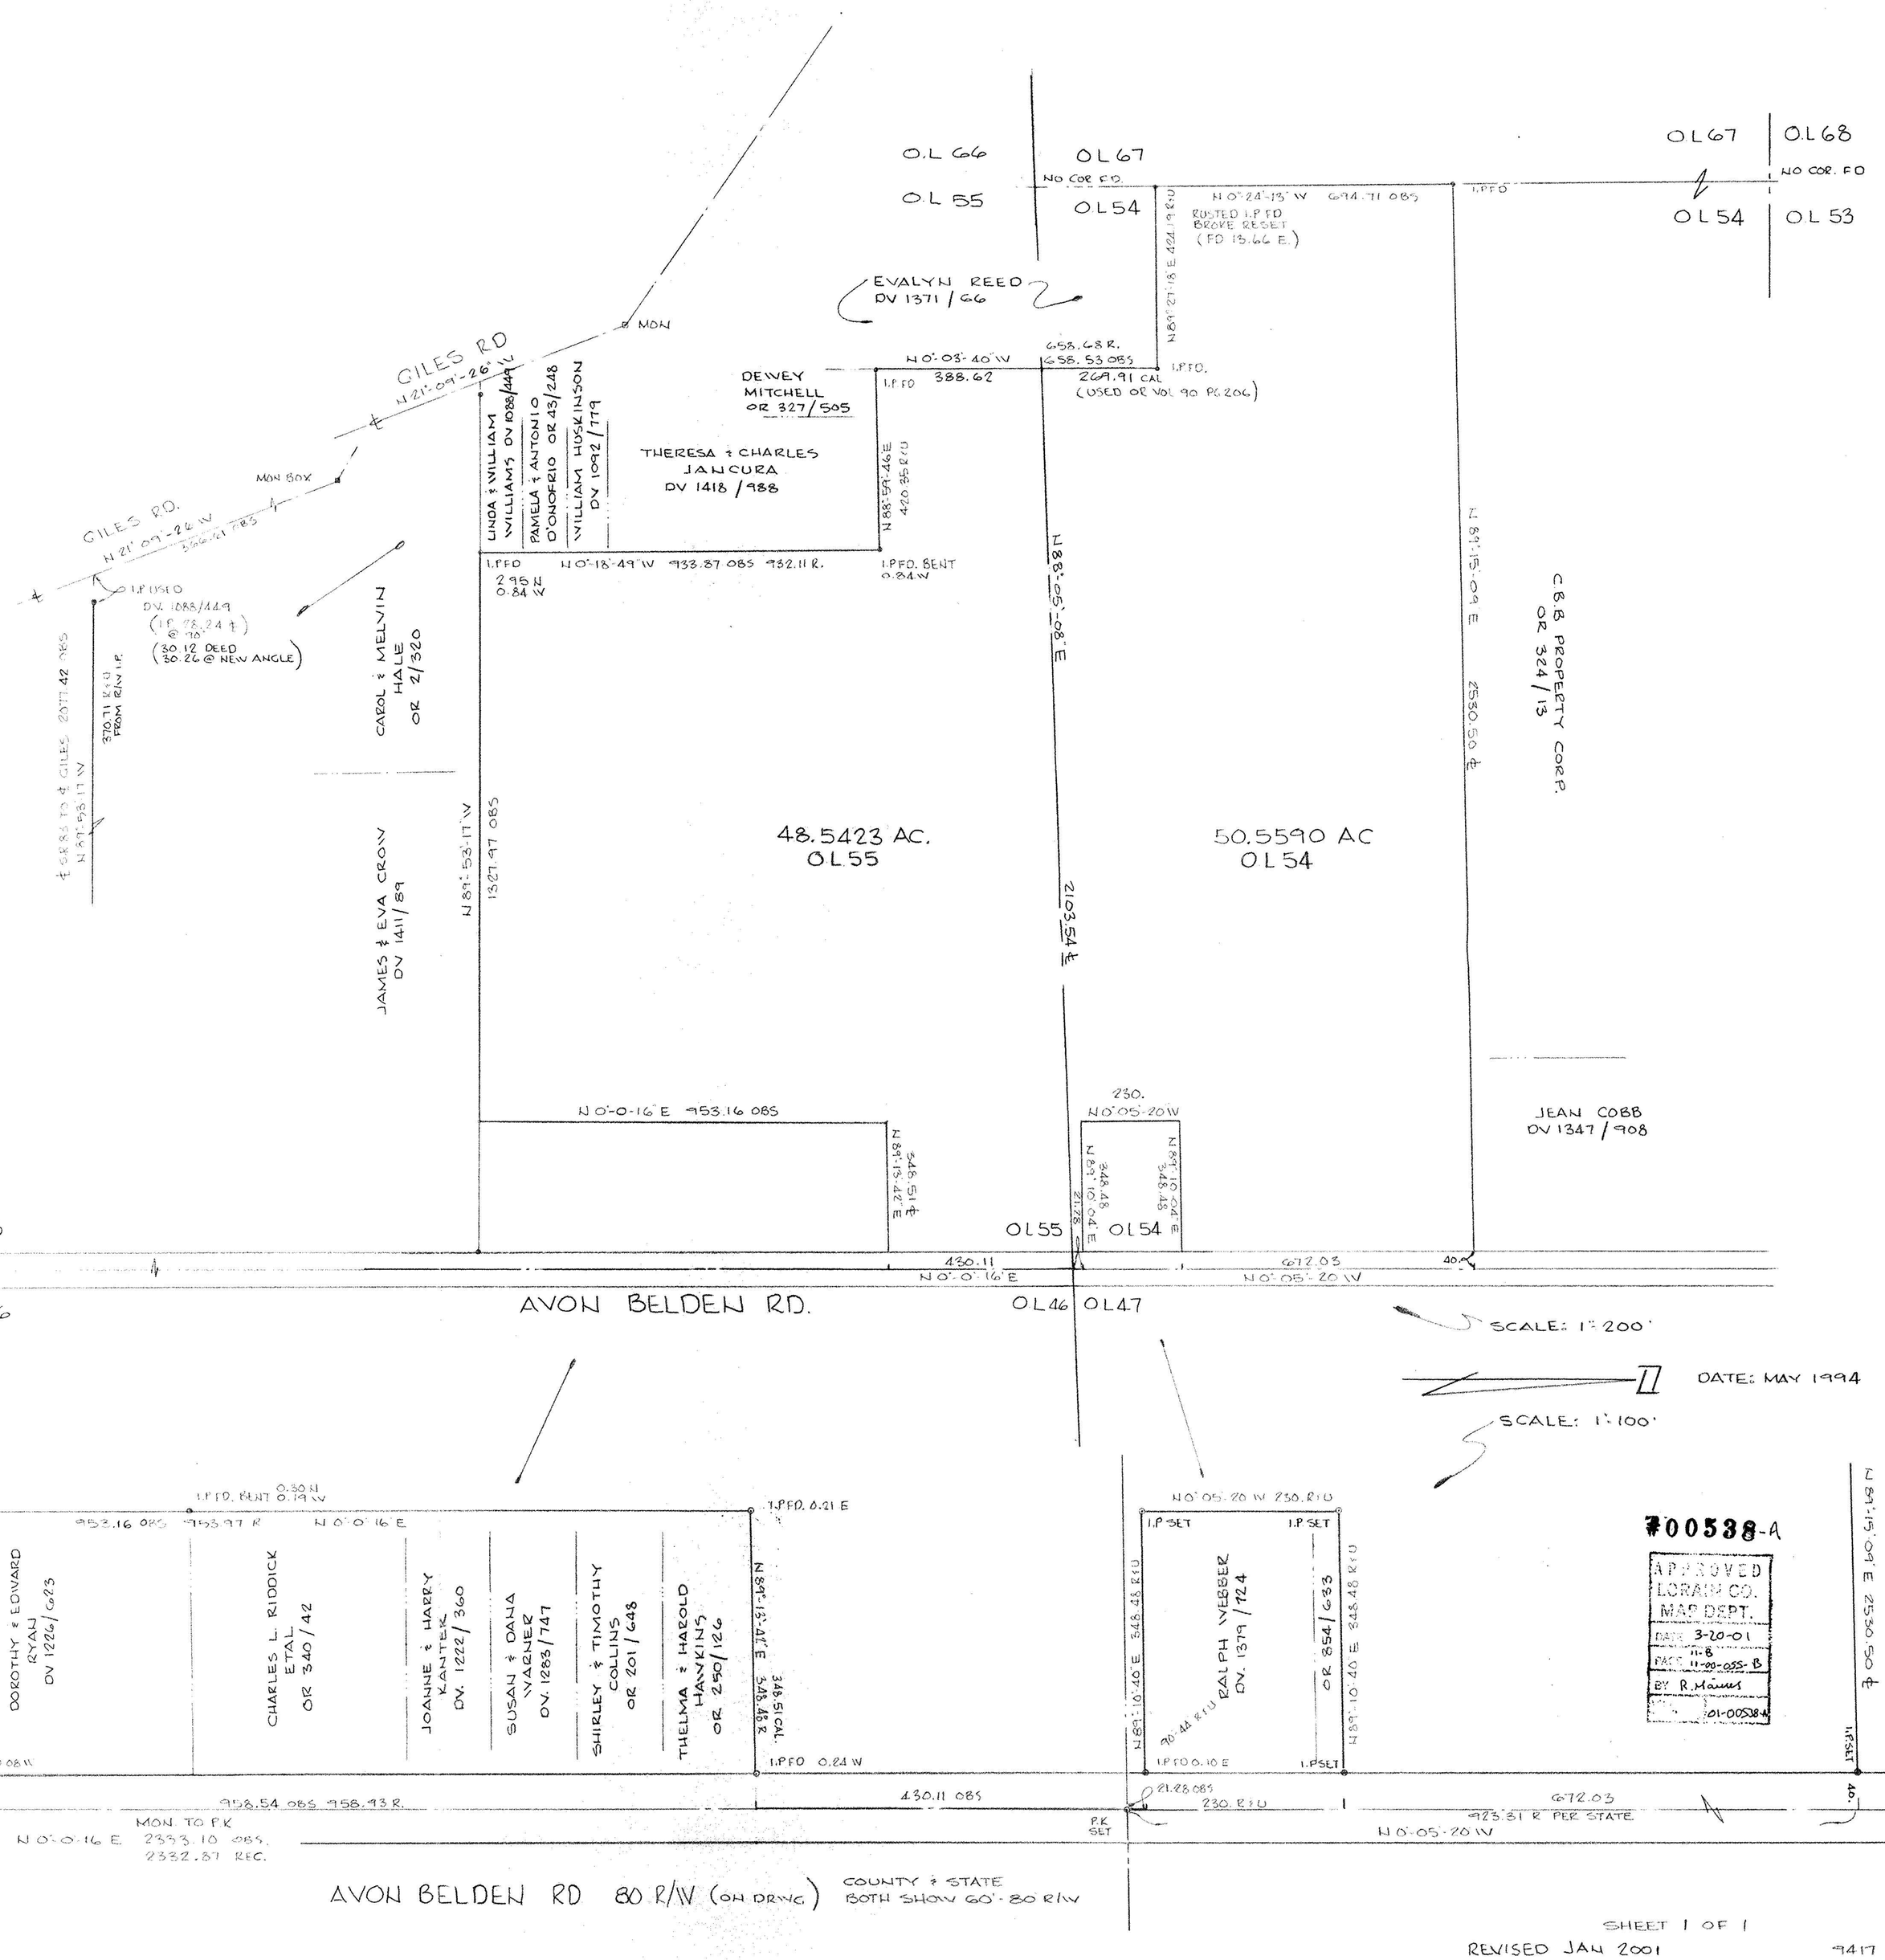

SHEET 1 OF 1

REVISED JAN 2001

9417