


11-00-057-000-058
REV.
11-00-057-B#21516 Aug 95

John Pozzywak Reg Surveyor

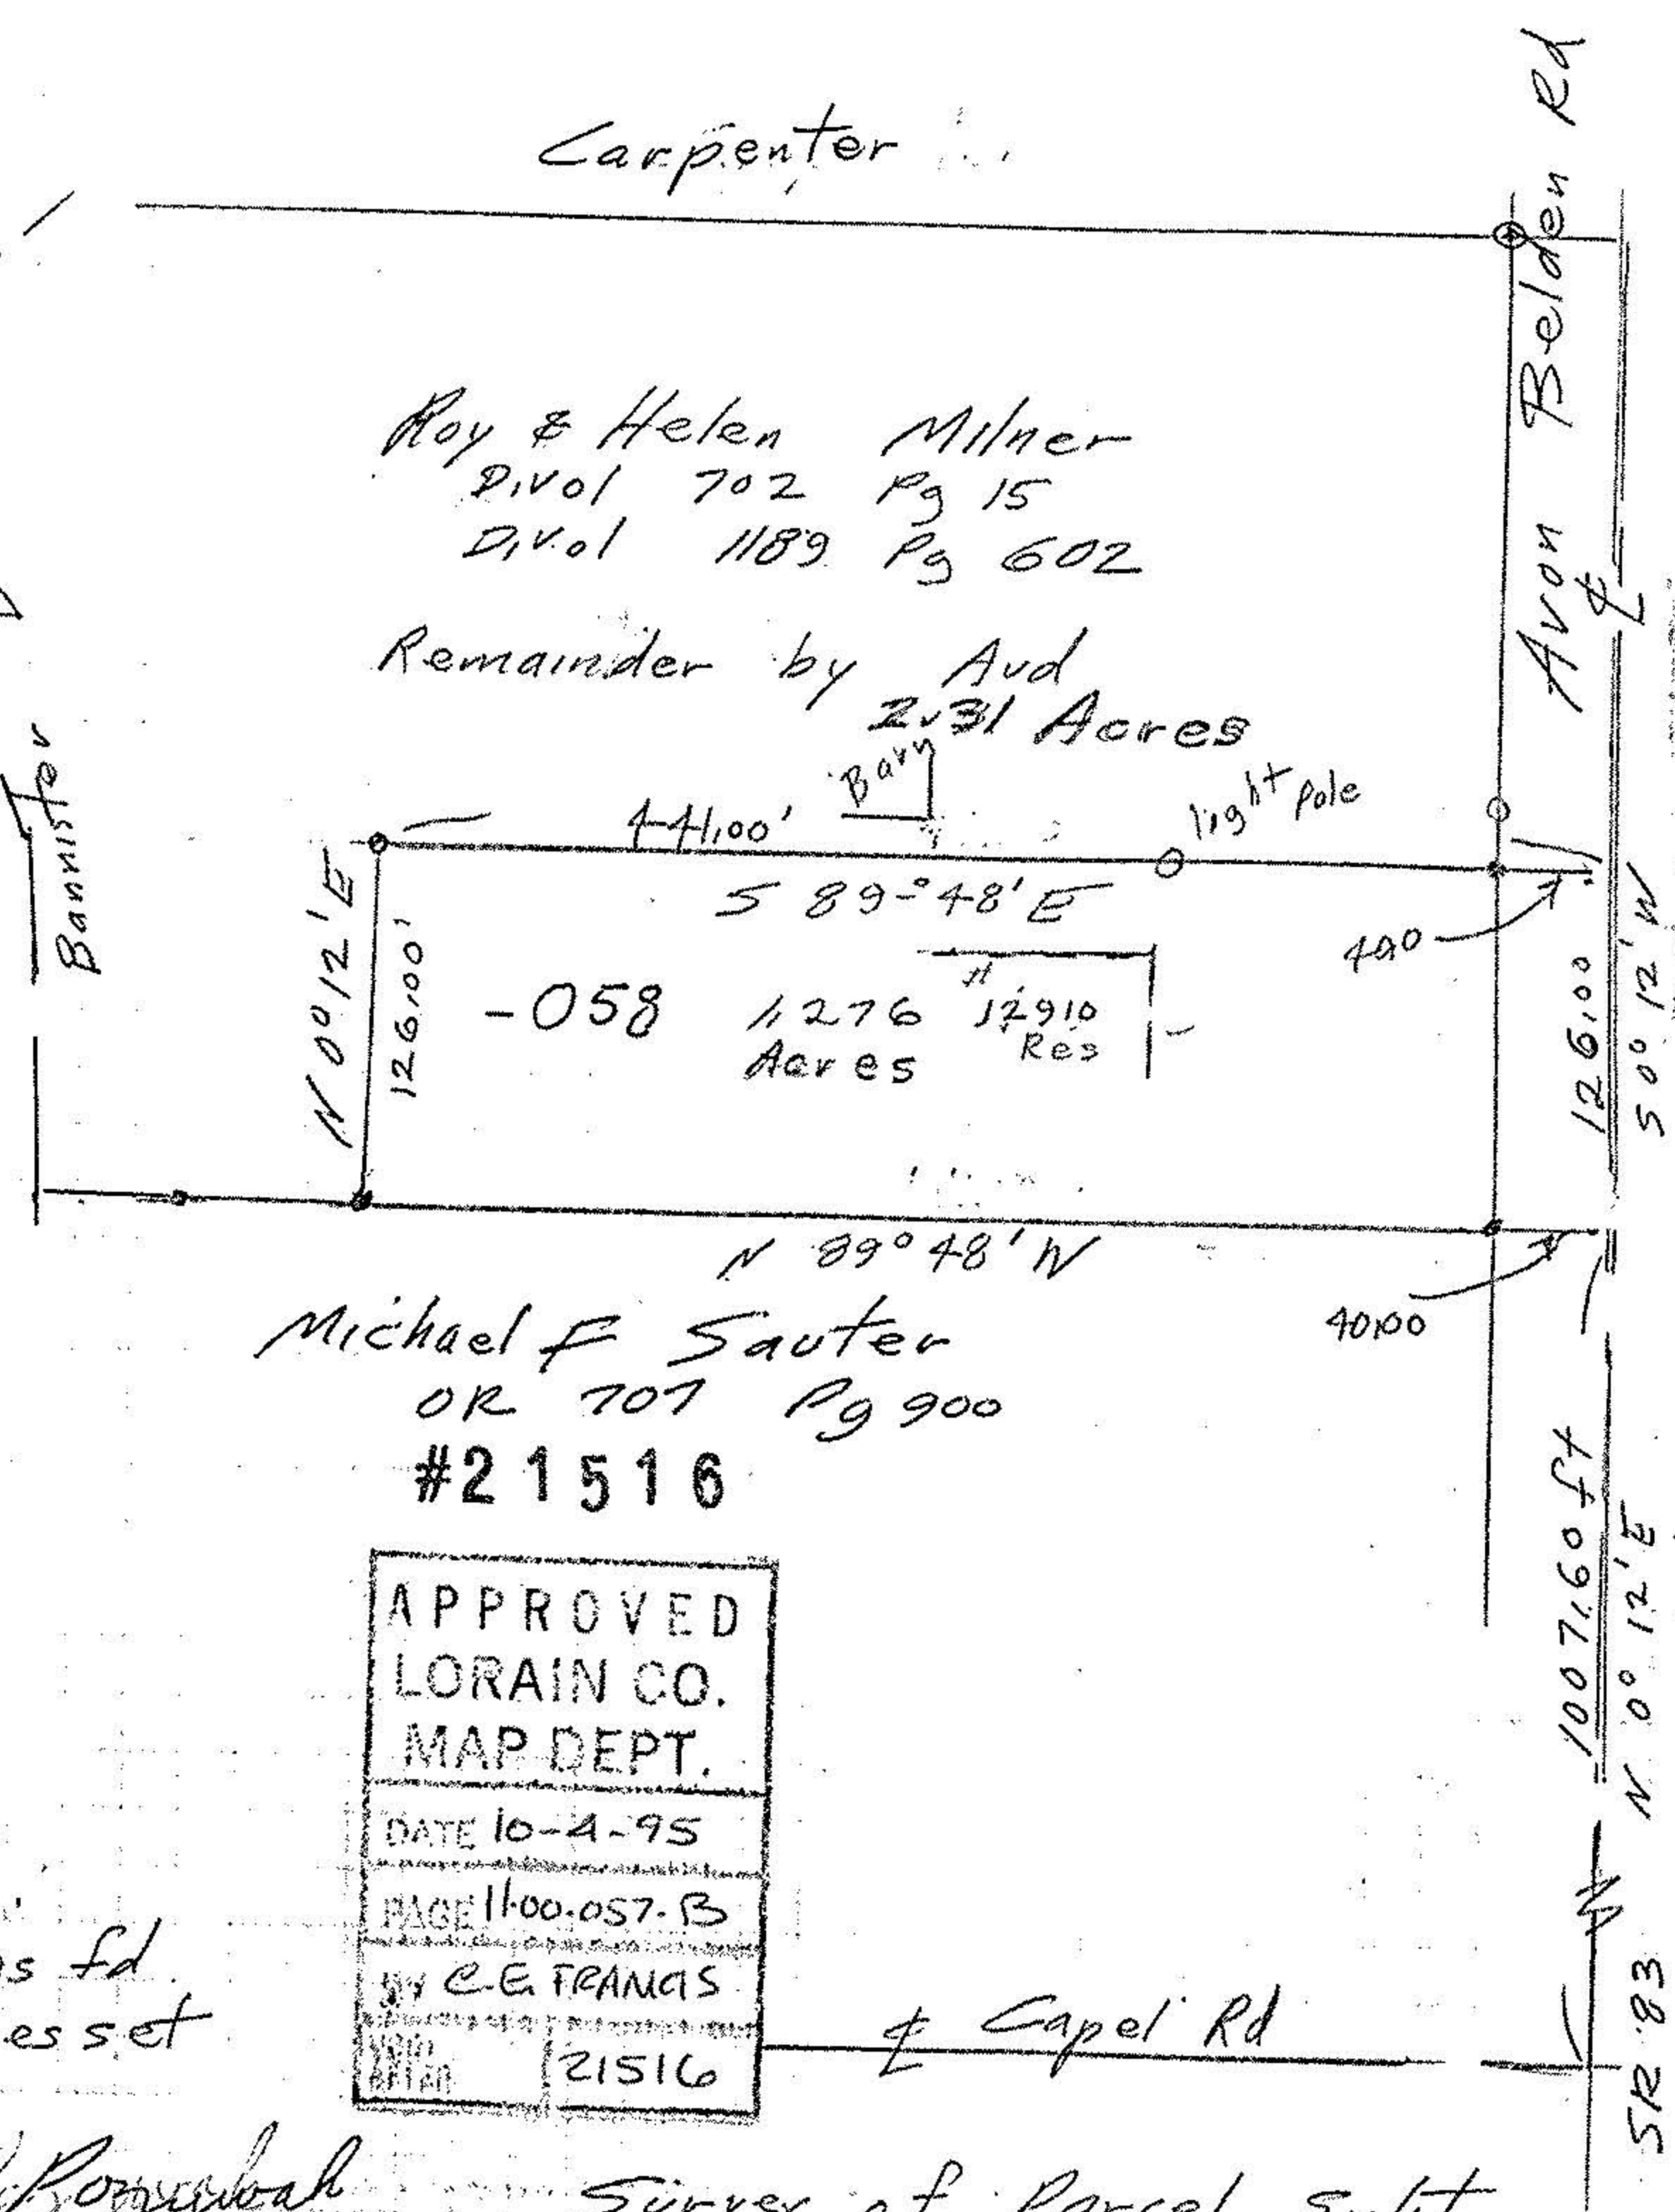

Bannister



Roy & Helen Milner
Divol 702 Pg 15
Divol 1189 Pg 602

Remainder by Aud 2.31 Acres


-058 1276 Acres 12910 Res

Michael F Sauter
OR 707 Pg 900
#21516

APPROVED
LORAIN CO.
MAP DEPT.
DATE 10-4-95
PAGE 11-00-057-B
BY E.E. FRANCIS
21516

- o iron pins fd.
- o iron pipes set

John Pozzywak
Reg Surveyor

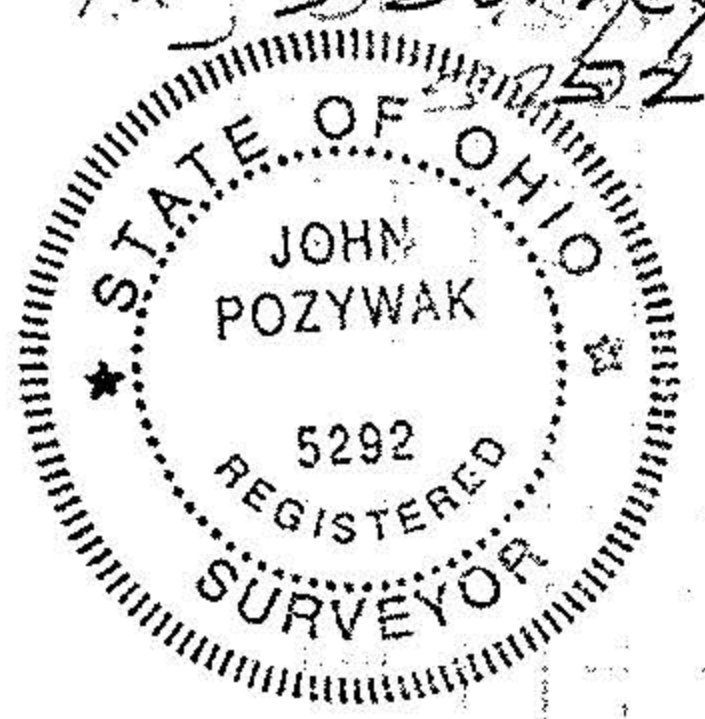

Survey of Parcel split
Roy Milner
Original Lot 57
Eaton Township
Lorain County Ohio
Scale 1"=100' Feb 1993
Rev Aug 1995

