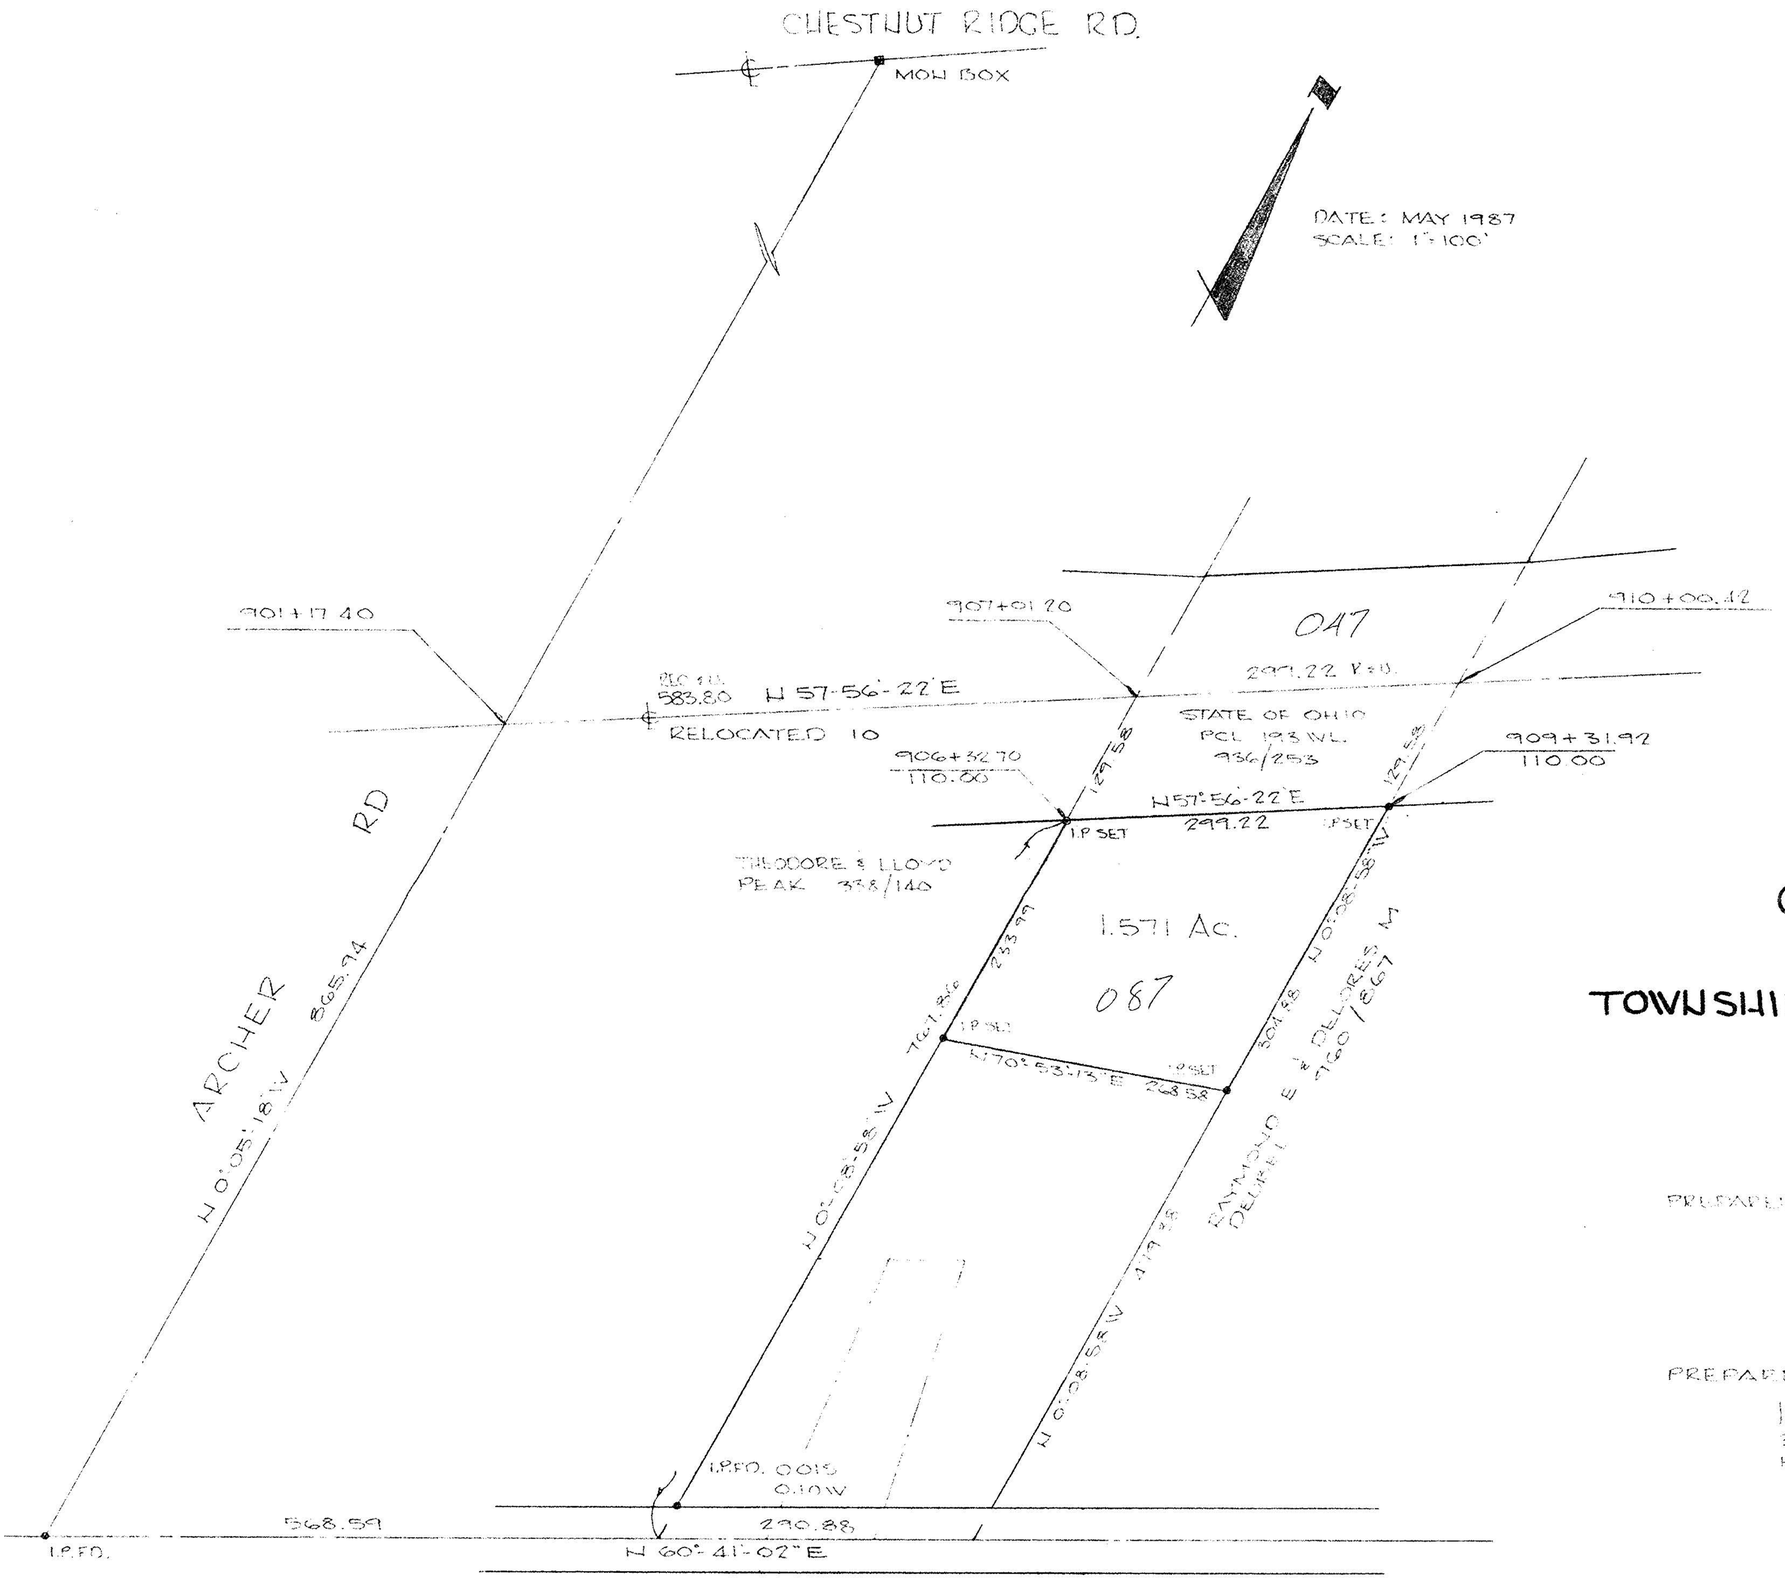

SURVEY
OF PART OF
ORIGINAL EATON TWP.
LOT NO. 70
TOWNSHIP OF EATON COUNTY OF LORAIN
STATE OF OHIO

PREPARED FOR:
RAYMOND DEUBEL
36574 BUTTERNUT RIDGE RD.
ELYRIA, O

PREPARED BY:
HAPONEK AND ASSOC.
34100 CENTER RIDGE RD.
N. RIDGEVILLE, O

11-00-070-000

STATE OF OHIO
DANIEL A. HAPONEK
S-6211
REGISTERED SURVEYOR

#17508

APPROVED
LORAIN CO.
MAP DEPT.
DATE 6-30-87
PAGE 11-00-070-0
BY C. Francis
VOID AFTER 17508

87-13