


PLAT OF SURVEY FOR WALTER C. & RUBY P. FISHBURN
 PART OF O.L. No 66 EATON TOWNSHIP
 LORAIN COUNTY, OHIO

IRON PINS WERE SET OR
 FOUND AT ALL POINTS
 INDICATED BY A "•".
 DIMENSIONS ARE
 EXPRESSED IN FEET
 AND DECIMAL PARTS
 THEREOF, ALL OF WHICH
 I CERTIFY TO BE
 CORRECT.

Raymond W. Hess
 5-5152

JUNE, 1993
 SCALE: 1"=100'

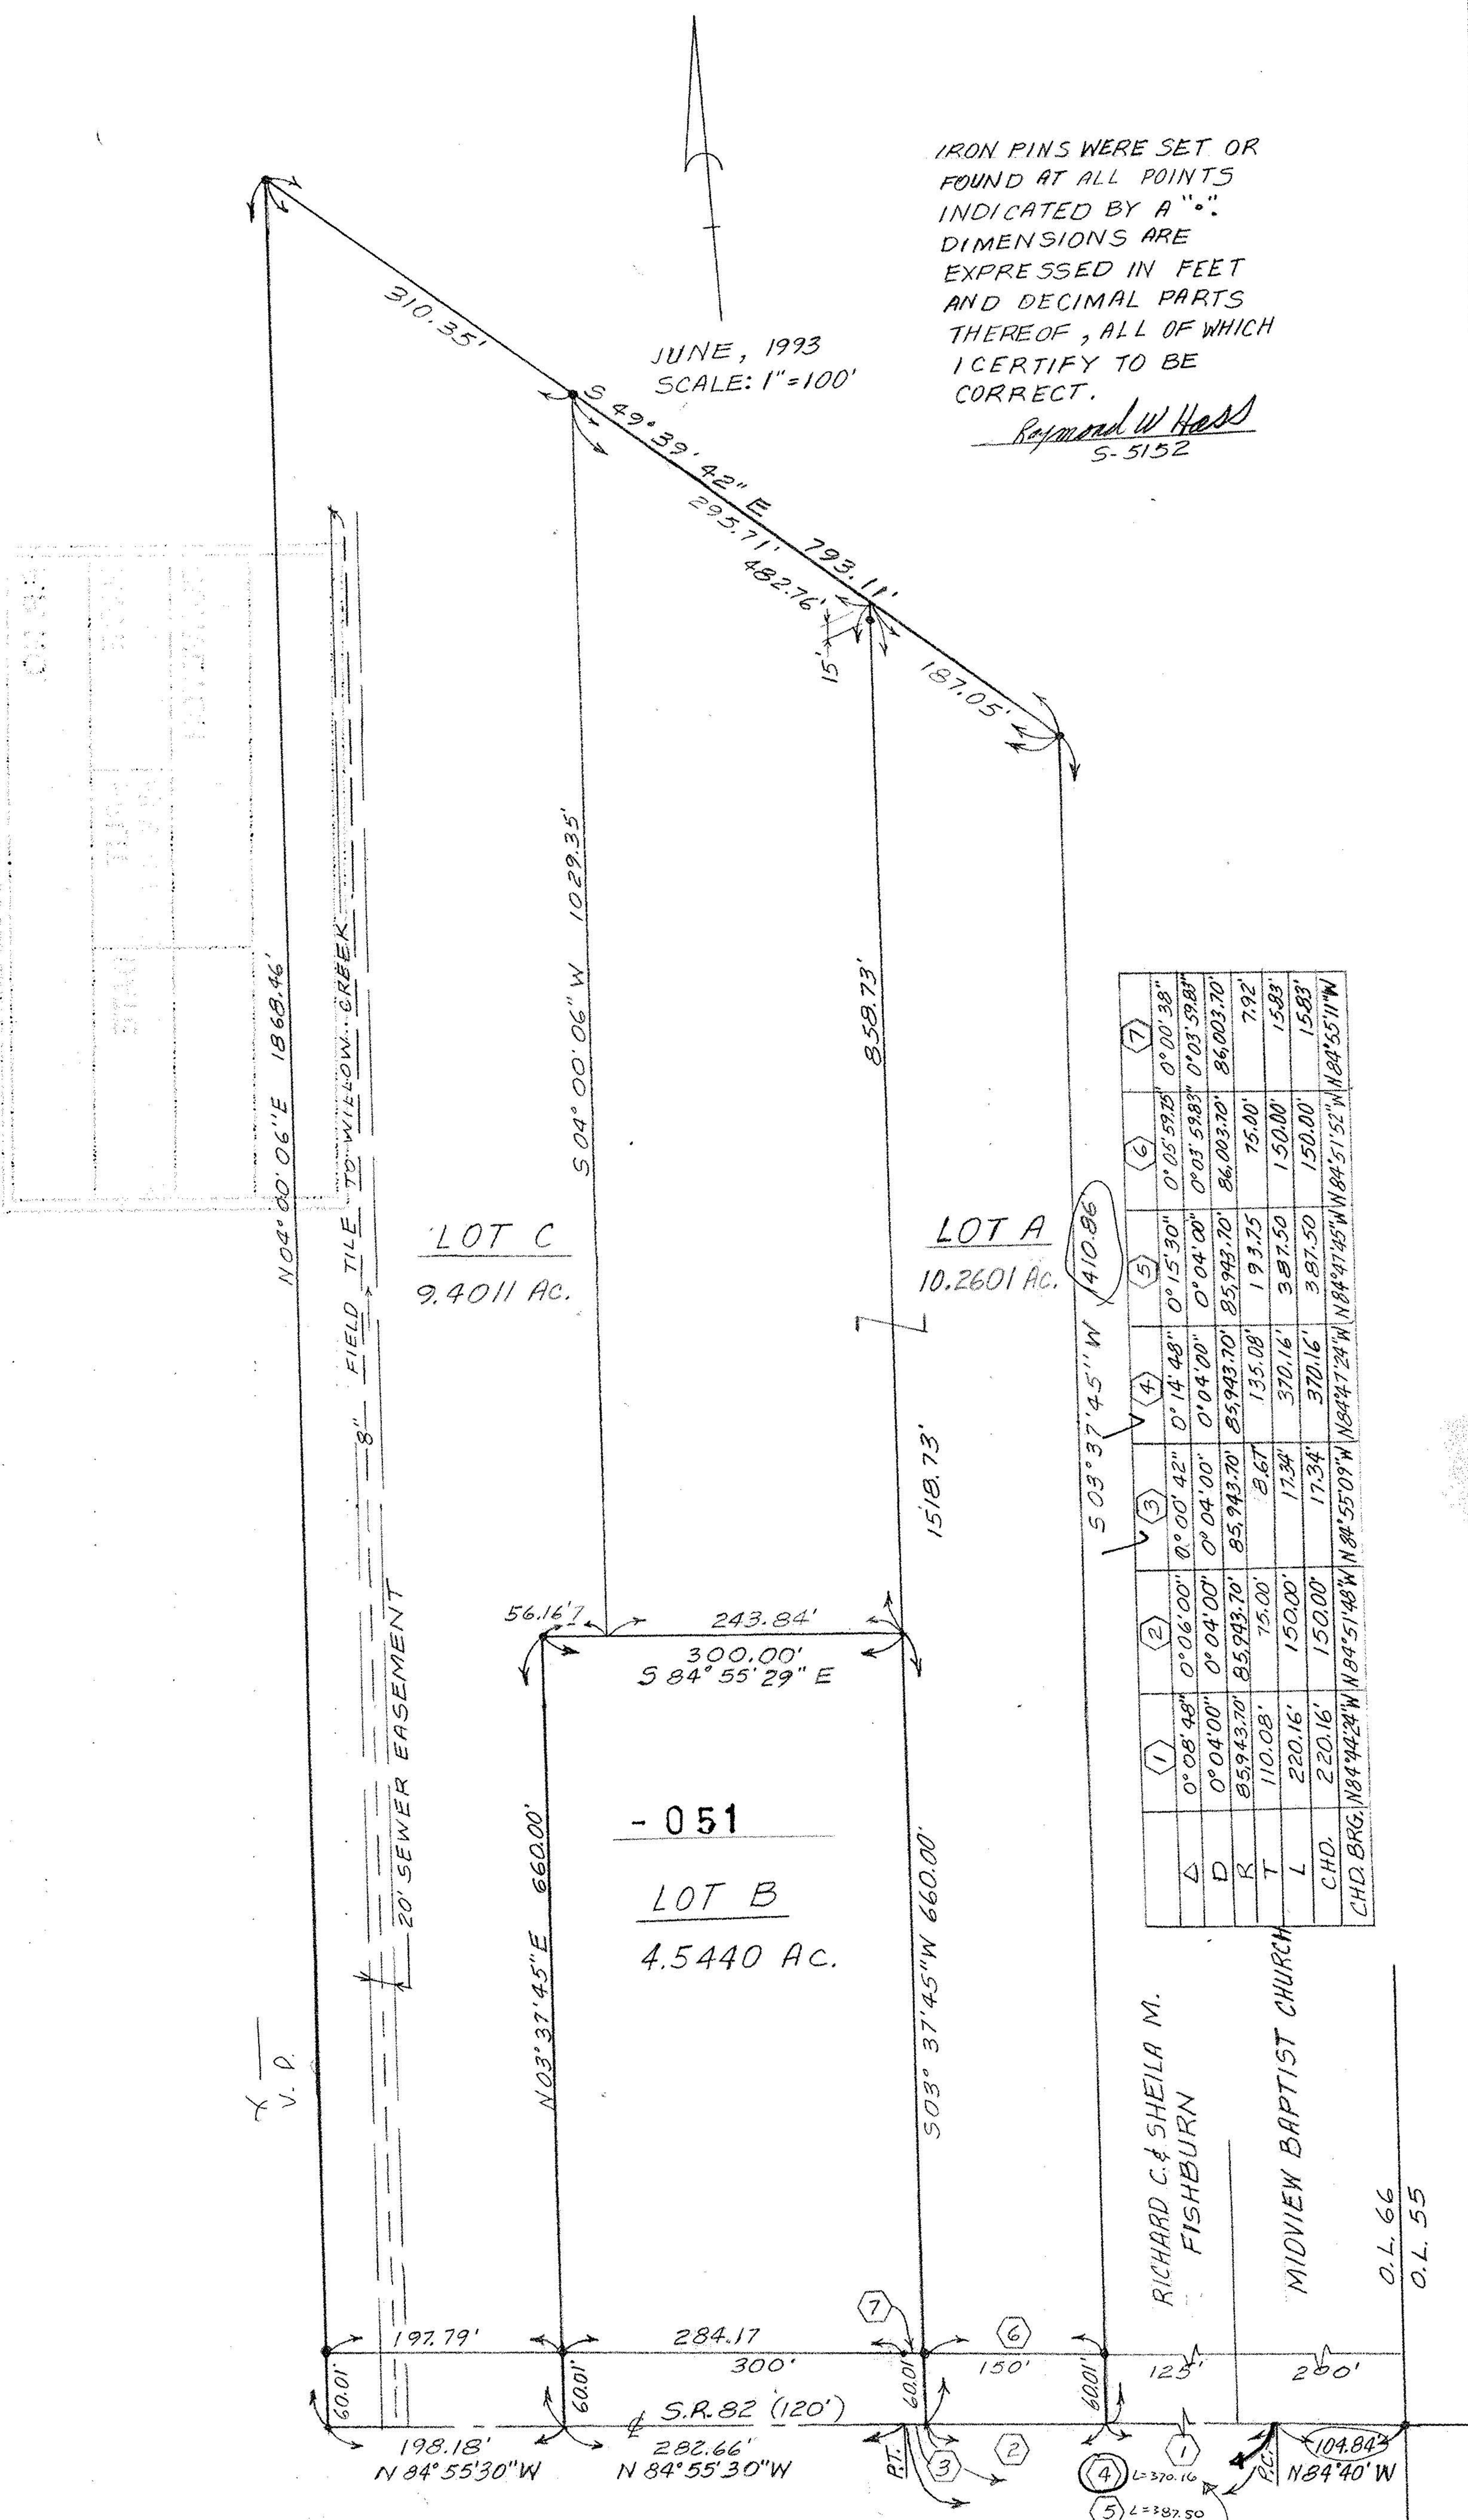


20490
 APPROVED
 LORAIN CO.
 MAP DEPT.
 DATE 9-18-93
 PAGE 11-3
 BY CAROLYN
 FRANKS
 VOID
 AFTER # 20490