
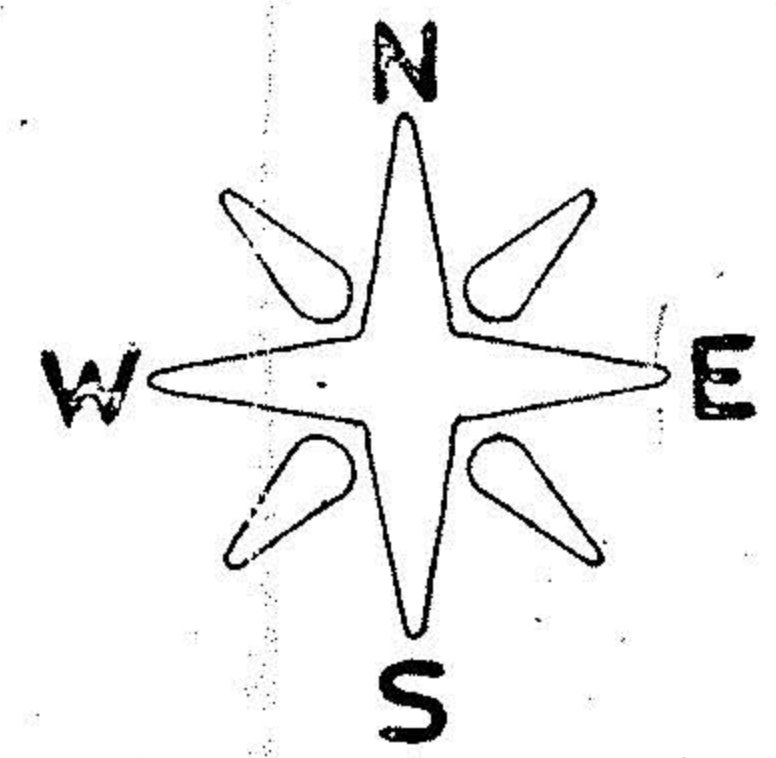


12-00-028  
12-G

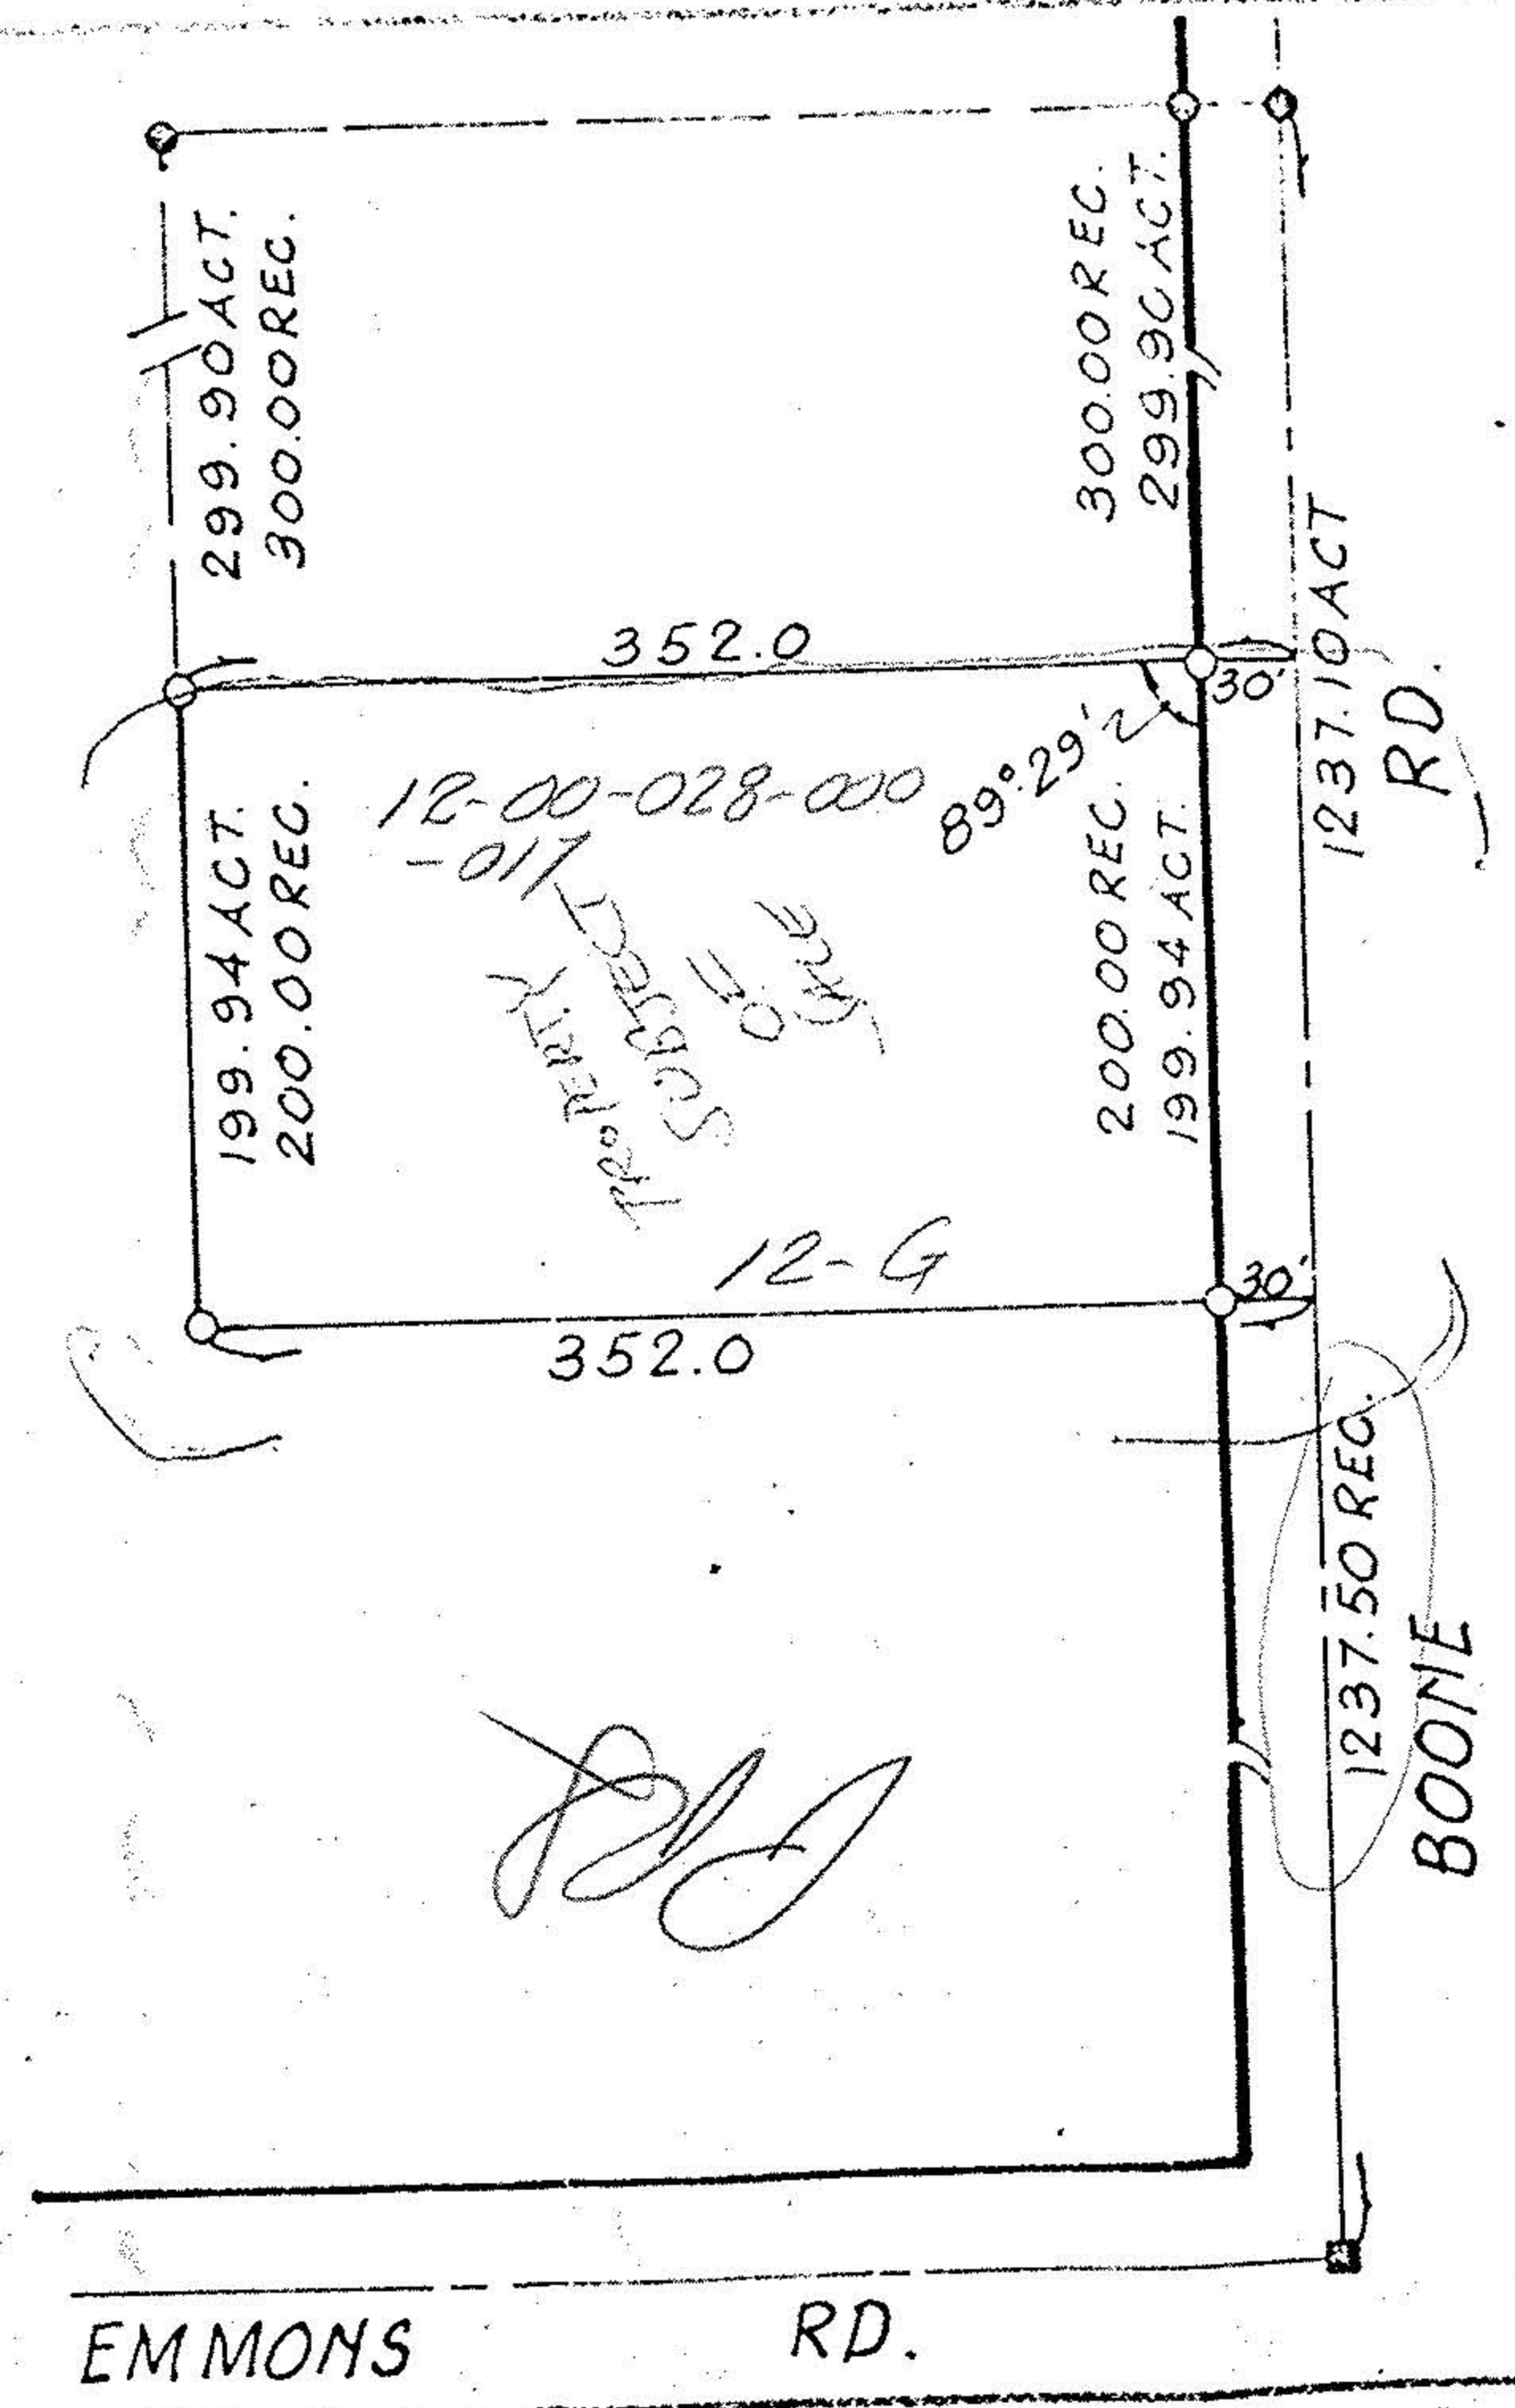

LEGEND:  
 ○ I.P. SET  
 ● I.P. FD.  
 ■ STONE FD.

12-00-028-000-017  
 1.61 AC.

LOT No. 28	Tr. or Sec.:
TOWNSHIP: COLUMBIA	
COUNTY: LORAIN STATE: OHIO	
OWNER: ERNEST J. + LUCILLE A. TOTH	
DATE: DEC. 1973 SCALE: 1"=100'	
JOHN A. BAMBECK, P.S.	
REGISTERED SURVEYOR No. 5141	