


STATE ROUTE 252
 (MALLETT CREEK - DAY VILLAGE RD)
 (COPPOPA - E. RIVER RD)
 N 2° 55' 00" W
 1194.00 COUNTY & MSD.

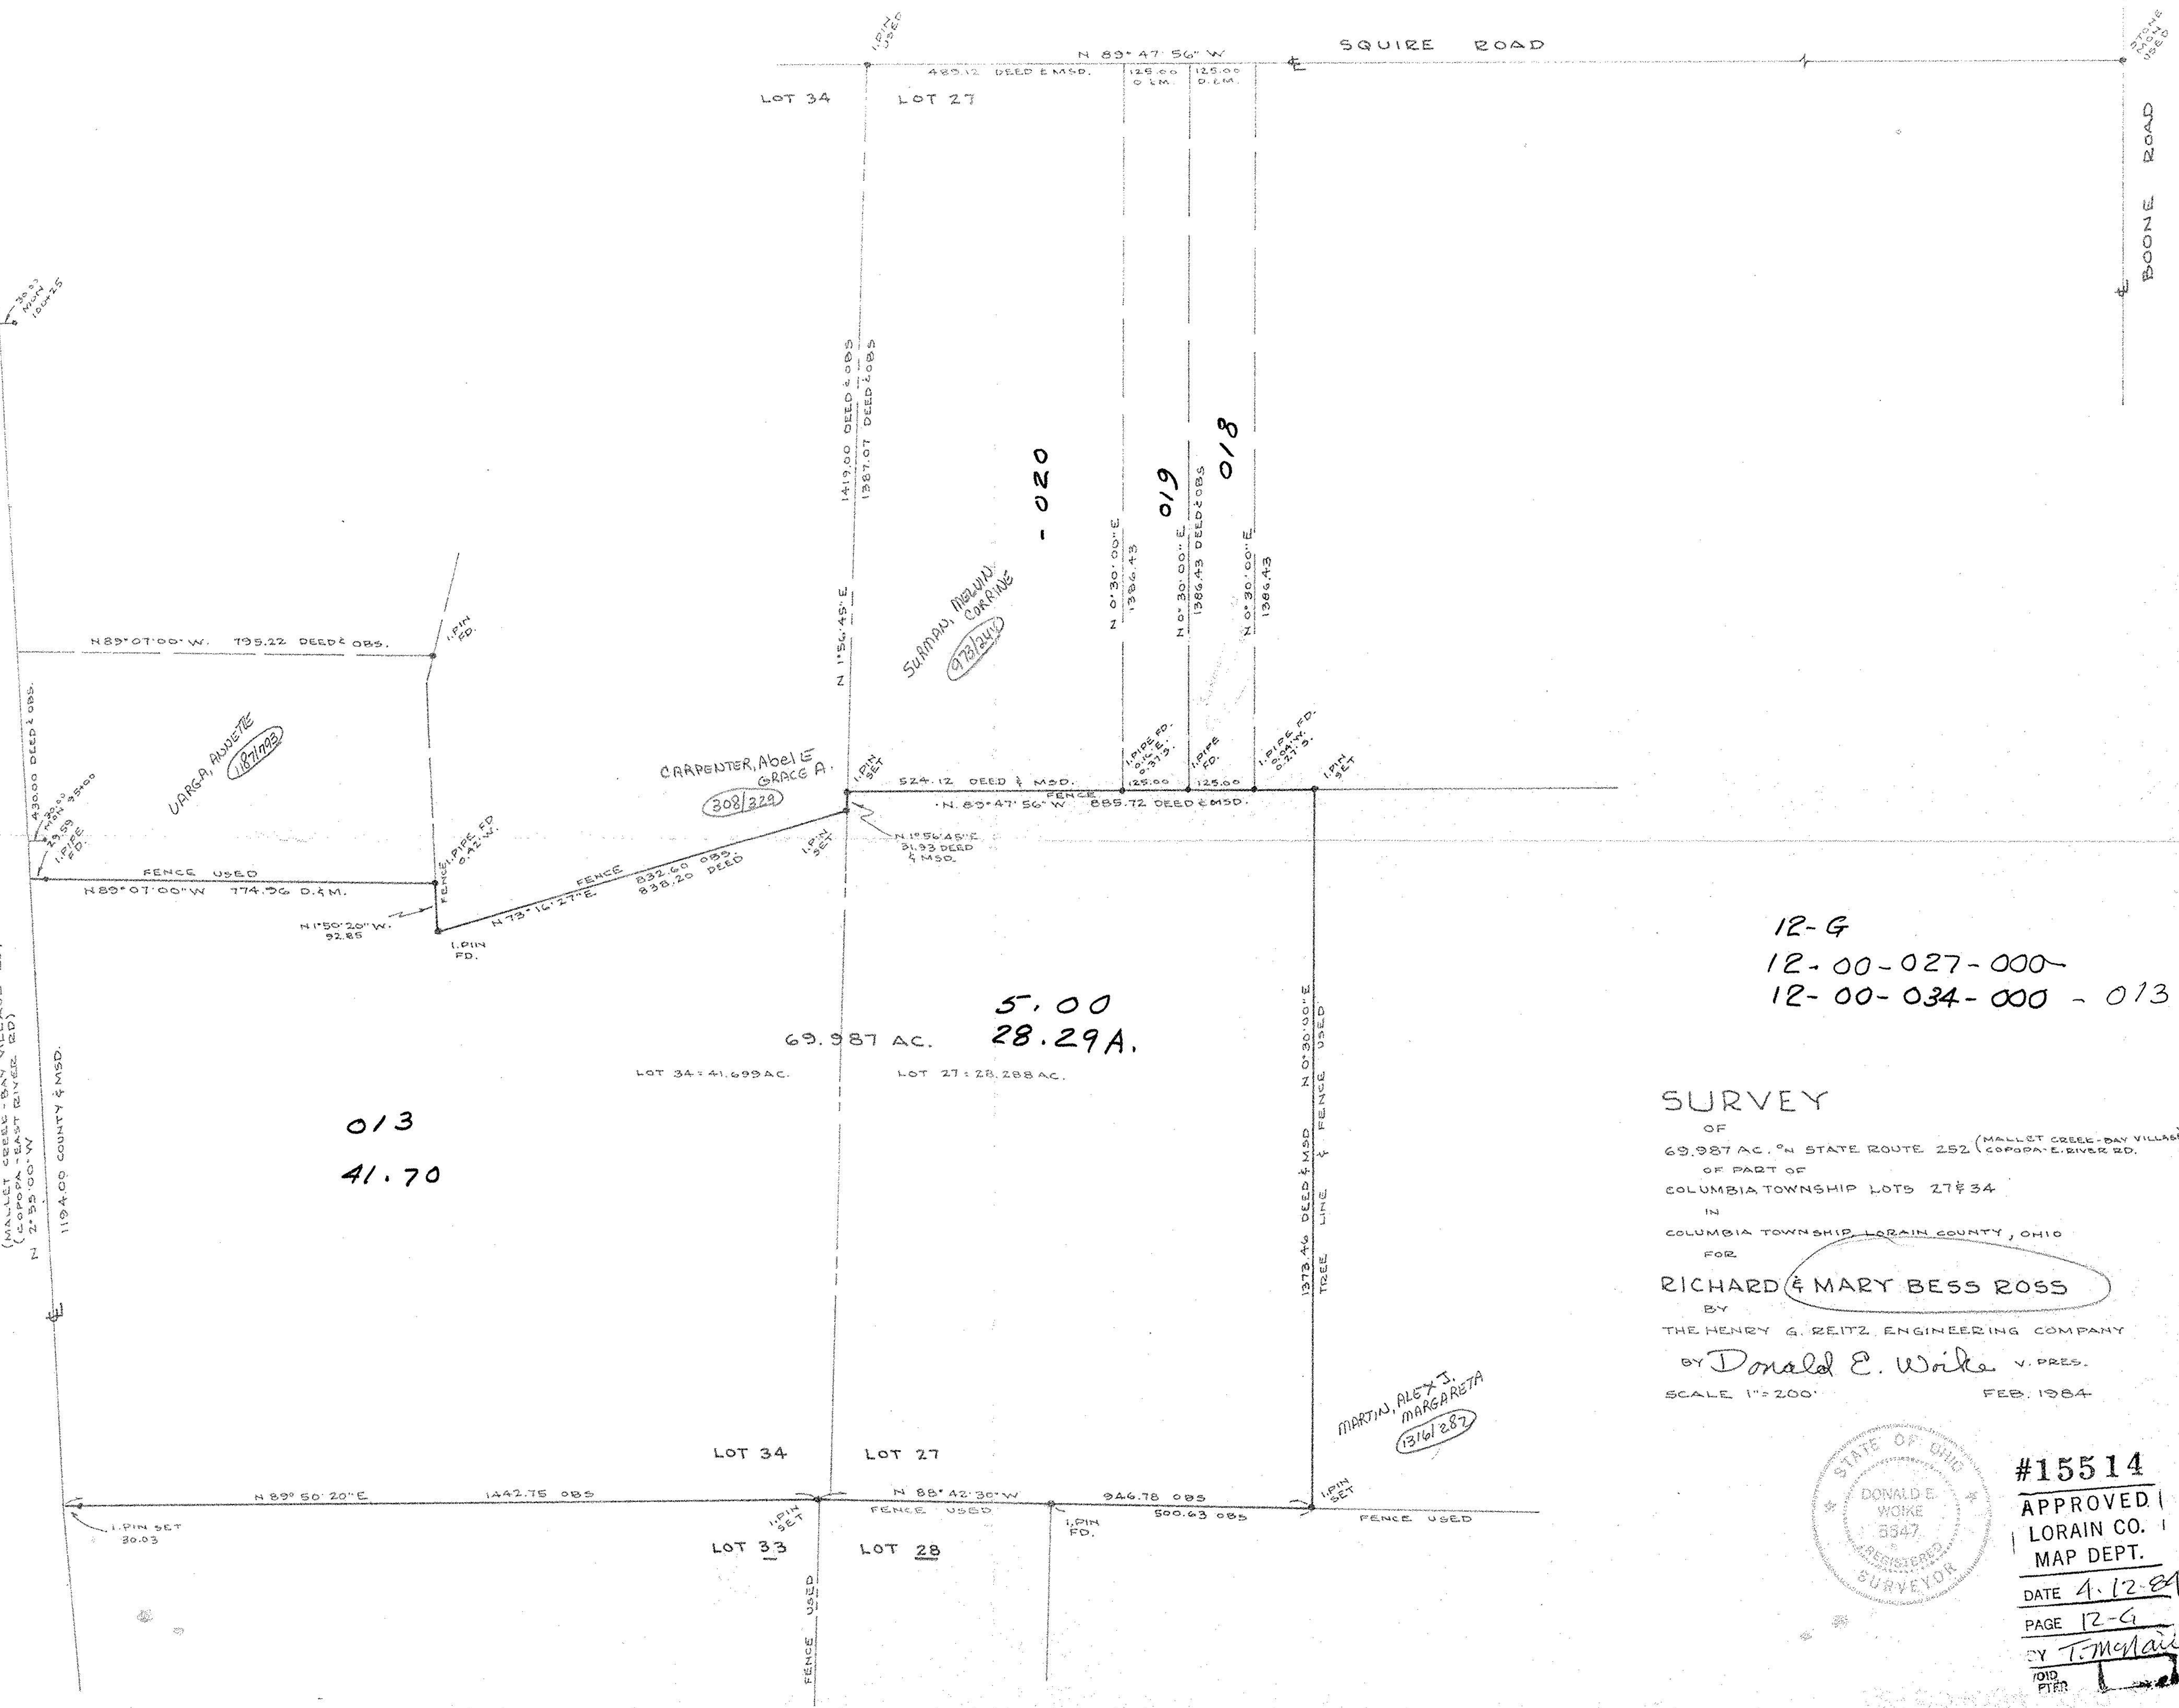


013
 41.70

69.987 AC.
 5.00
 28.29A.

12-G
 12-00-027-000
 12-00-034-000 - 013

SURVEY
 OF
 69.987 AC. IN STATE ROUTE 252 (MALLETT CREEK - DAY VILLAGE RD)
 OF PART OF
 COLUMBIA TOWNSHIP LOTS 27 & 34
 IN
 COLUMBIA TOWNSHIP, LORAIN COUNTY, OHIO
 FOR
RICHARD & MARY BESS ROSS
 BY
 THE HENRY G. ZEITZ ENGINEERING COMPANY
 BY *Donald E. Woike* V. PRES.
 SCALE 1"=200' FEB. 1984

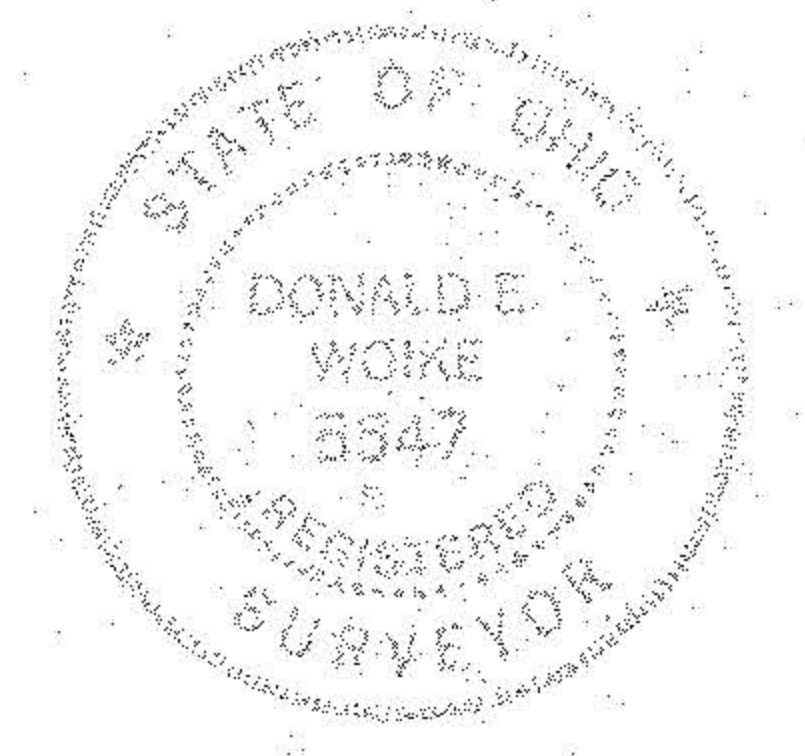

#15514
 APPROVED
 LORAIN CO. MAP DEPT.
 DATE 4.12.84
 PAGE 12-G
 BY T. McNeil
 1019 PIER

MARTIN, ALEX J.
 MARGARETA
 (3161287)

 CORRINE
 (9732416)

 (1871928)

CARPENTER, ABEL E.
 GRACE A.
 (3082229)