COPY

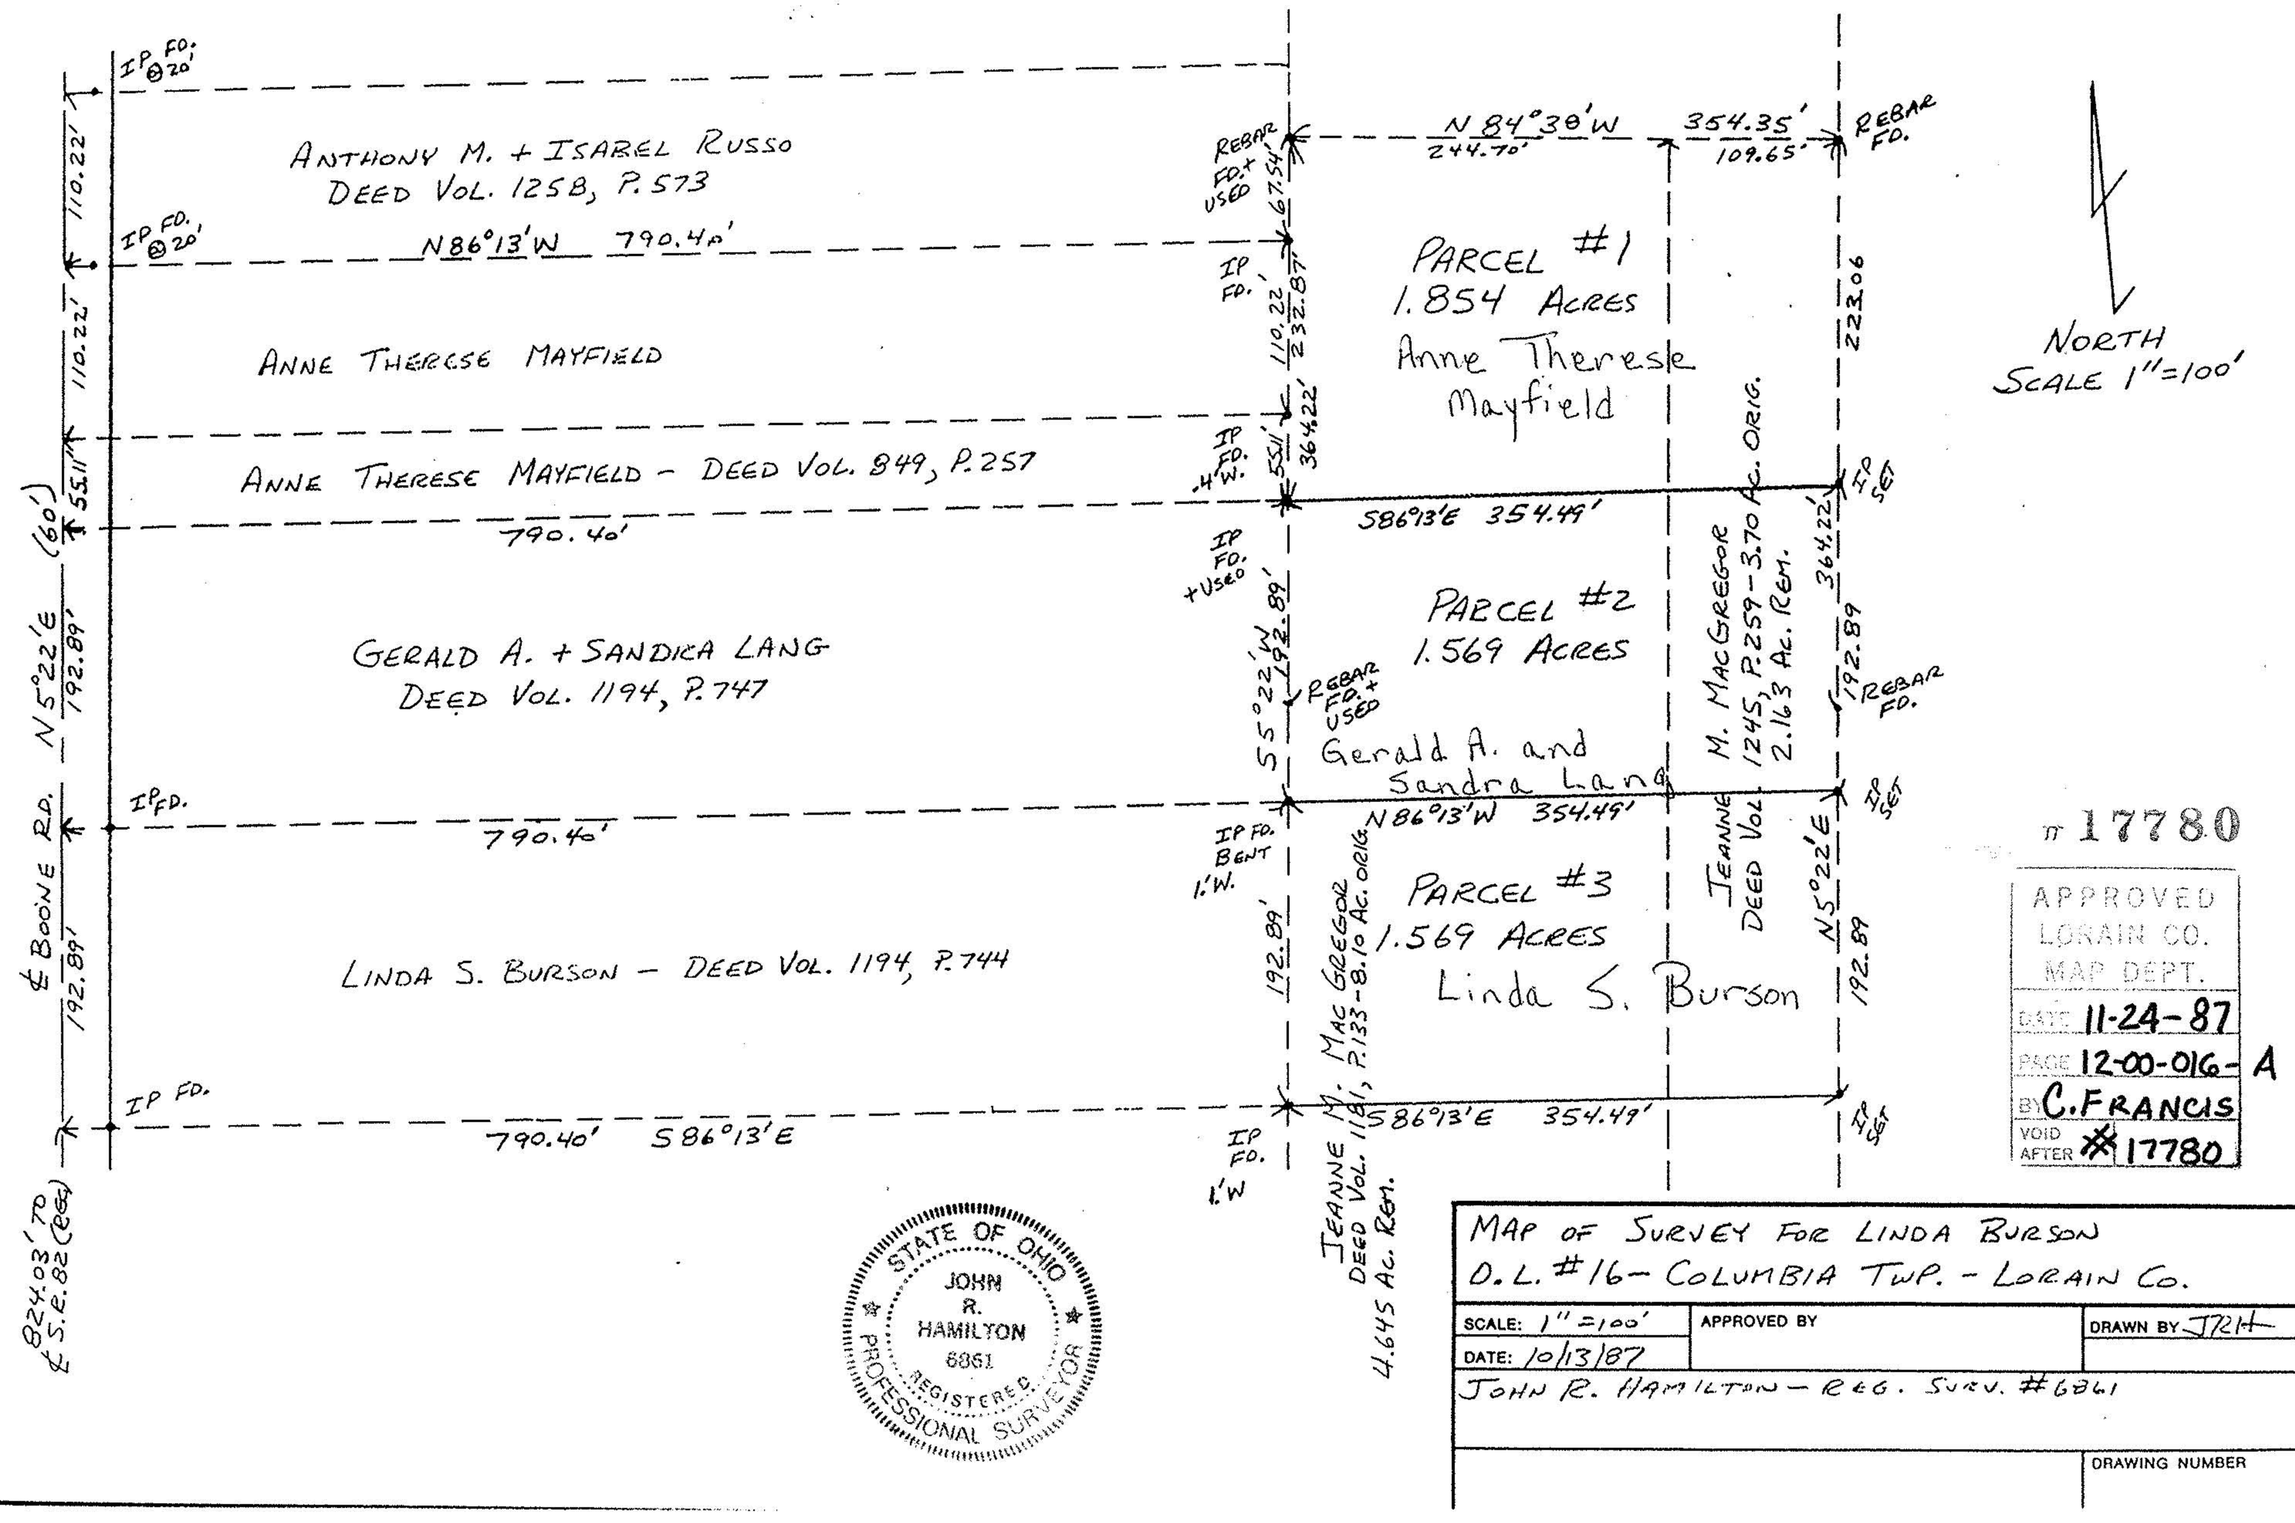

STATE OF OHIO
JOHN R. HAMILTON
6861
REGISTERED PROFESSIONAL SURVEYOR

17780

APPROVED
LORAIN CO.
MAP DEPT.
DATE 11-24-87
PAGE 12-00-016-A
BY C. FRANCIS
VOID AFTER # 17780

MAP OF SURVEY FOR LINDA BURSON
O.L. #16 - COLUMBIA TWP. - LORAIN CO.

SCALE: 1" = 100'	APPROVED BY	DRAWN BY JRH
DATE: 10/13/87		

JOHN R. HAMILTON - REG. SURV. #6861

DRAWING NUMBER