MAP OF SURVEY & LOT SPLIT MADE FOR

AUDREY & RICHARD McCLAIN

PERMANENT PARCEL NO. 12-00-017-000-002

PART OF ORIGINAL COLUMBIA TOWNSHIP LOT NO. 17, NOW IN THE TOWNSHIP OF COLUMBIA, COUNTY OF LORAIN AND STATE OF OHIO

DISTANCES ARE GIVEN IN FEET AND DECIMAL PARTS ALL OF WHICH I CERTIFY TO BE CORRECT.

WARREN J. ROOT, JR. REG. SURVEYOR 4009

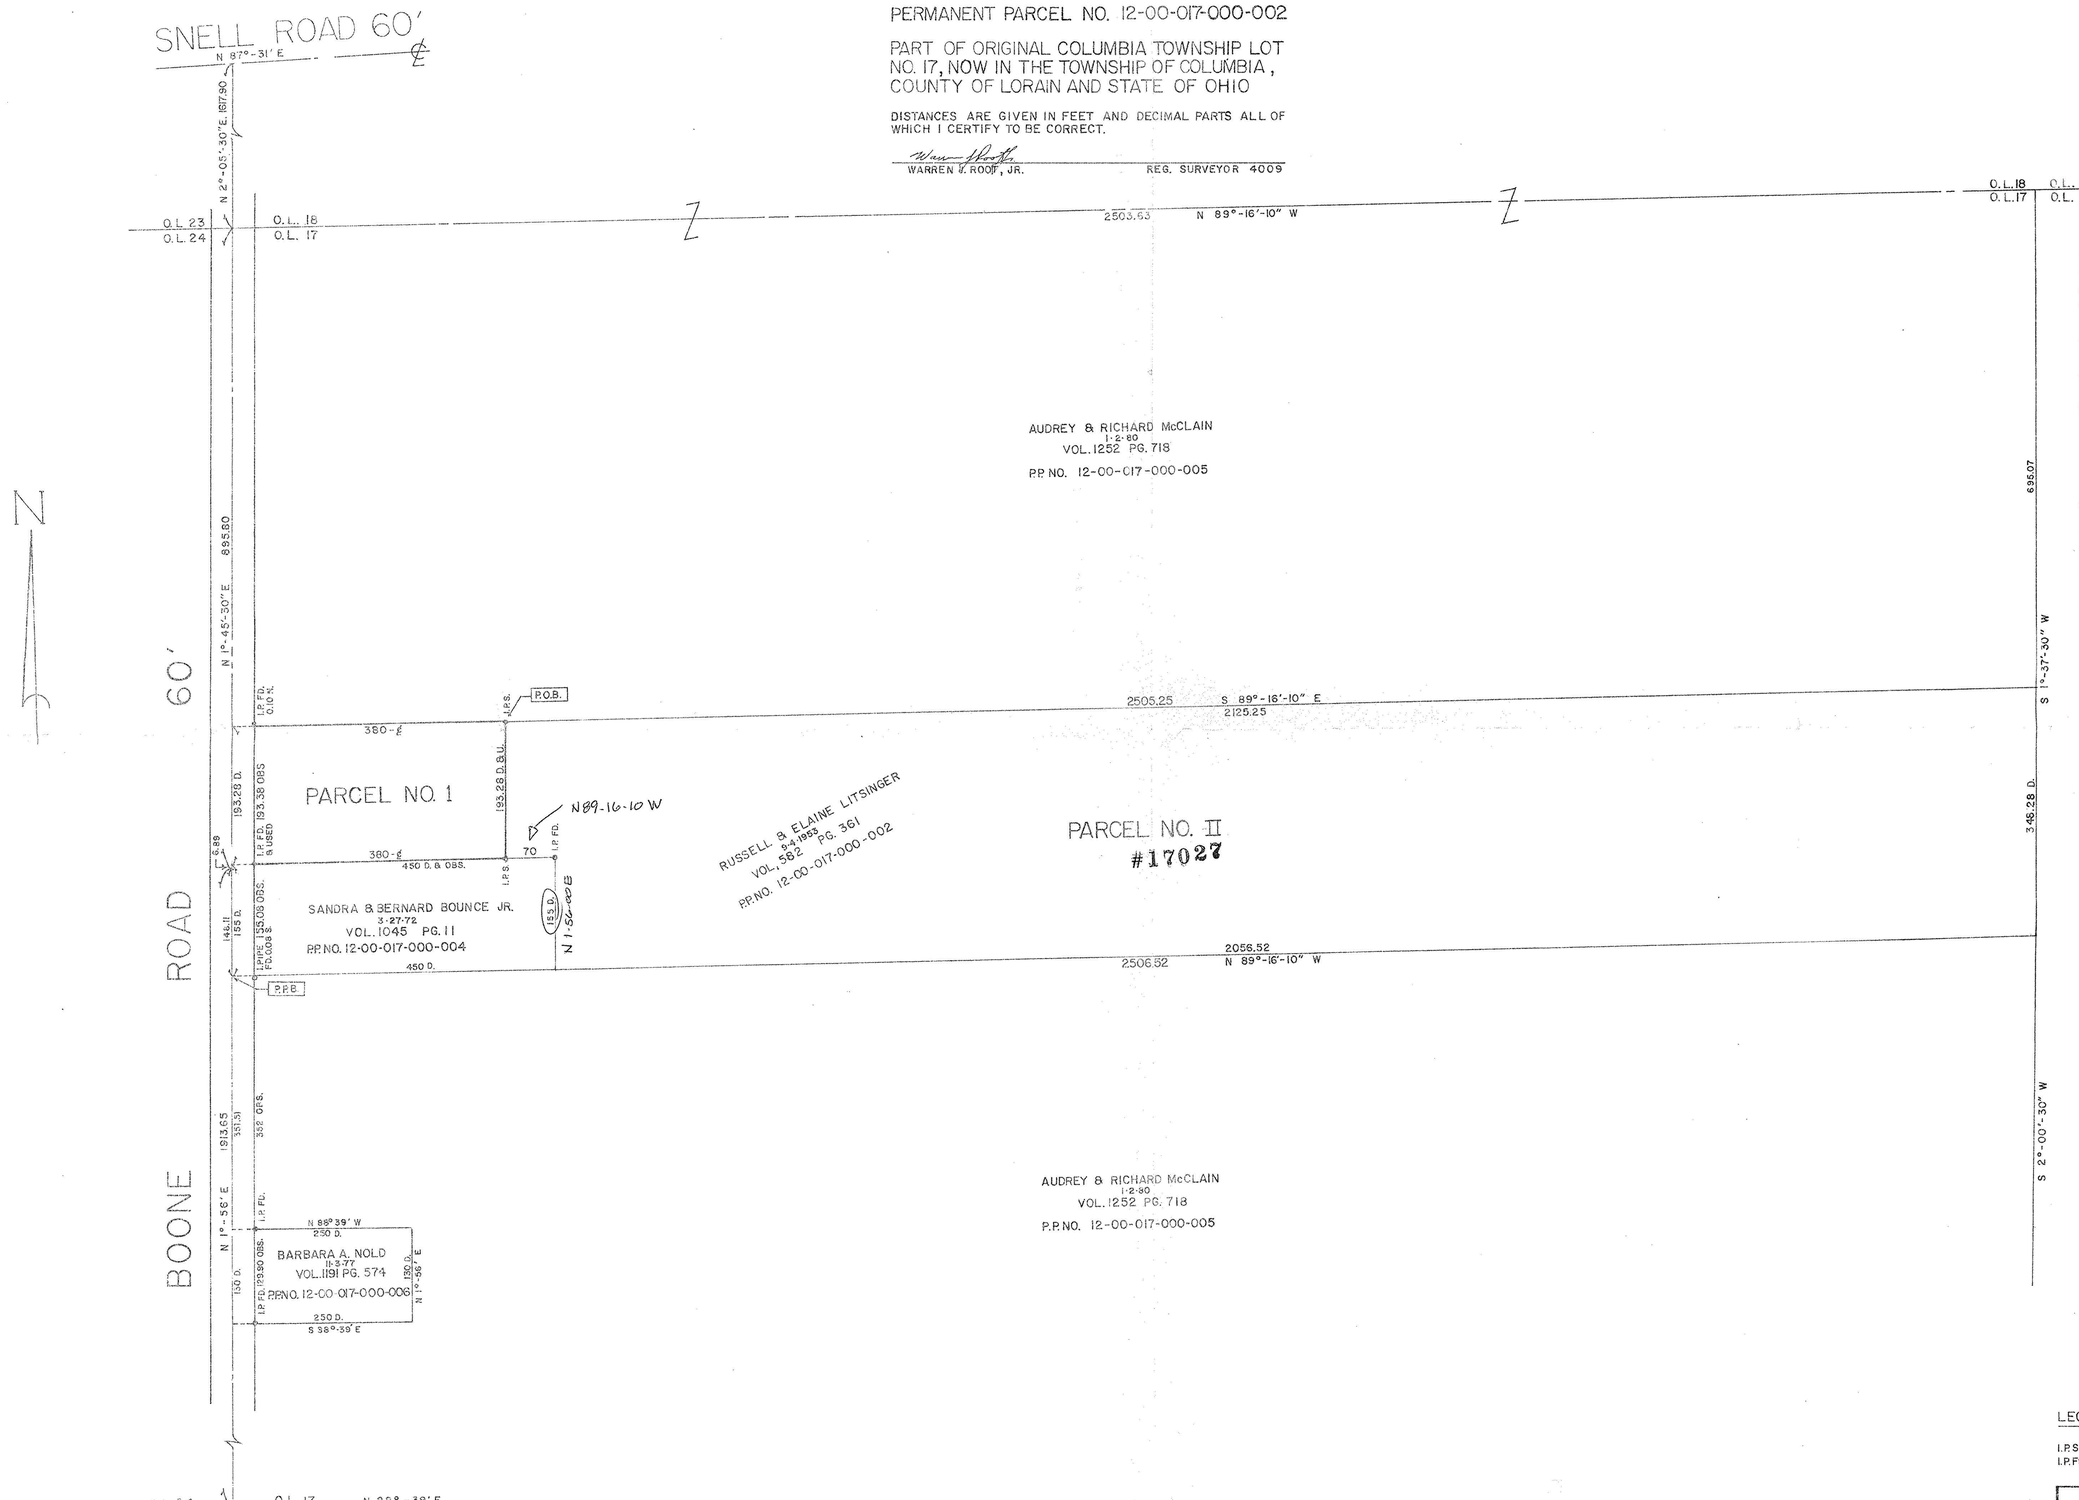

ACCEPTANCE:

THE UNDERSIGNED, OWNERS OF THE LAND SHOWN ON THIS PLAT, HEREBY ACCEPT THIS MAP AND SUBDIVISION OF SAME.

AUDREY McCLAIN

RICHARD McCLAIN

ELAINE LITSINGER

APPROVALS:

THIS PLAT IS APPROVED BY THE LORAIN COUNTY PLANNING COMMISSION THIS _____ DAY OF _____ 1986.

CHAIRMAN SECRETARY

#17027

APPROVED
LORAIN CO.
MAP DEPT.
DATE 10-1-86
PAGE 12-00-017-A, B
BY C. FRANCIS
VOID AFTER 17027

STATE OF OHIO
WARREN J. ROOT, JR.
4009
REGISTERED SURVEYOR

LEGEND

I.P.S - IRON PIN SET
I.P.FD - IRON PIN FOUND

WARREN J. ROOT, JR. & ASSOCIATES
CIVIL ENGINEERS AND SURVEYORS
21330 CENTER RIDGE ROAD (216) 356-1818 ROCKY RIVER, OHIO 44116

DWN. BY RRR	SCALE 1" = 100'	FB. P.	SHEET 1 OF 1
CHK'D. BY WR	DATE 3-13-86	ORD. NO.	