


SEE 12-00-008-A

50% REDUCED

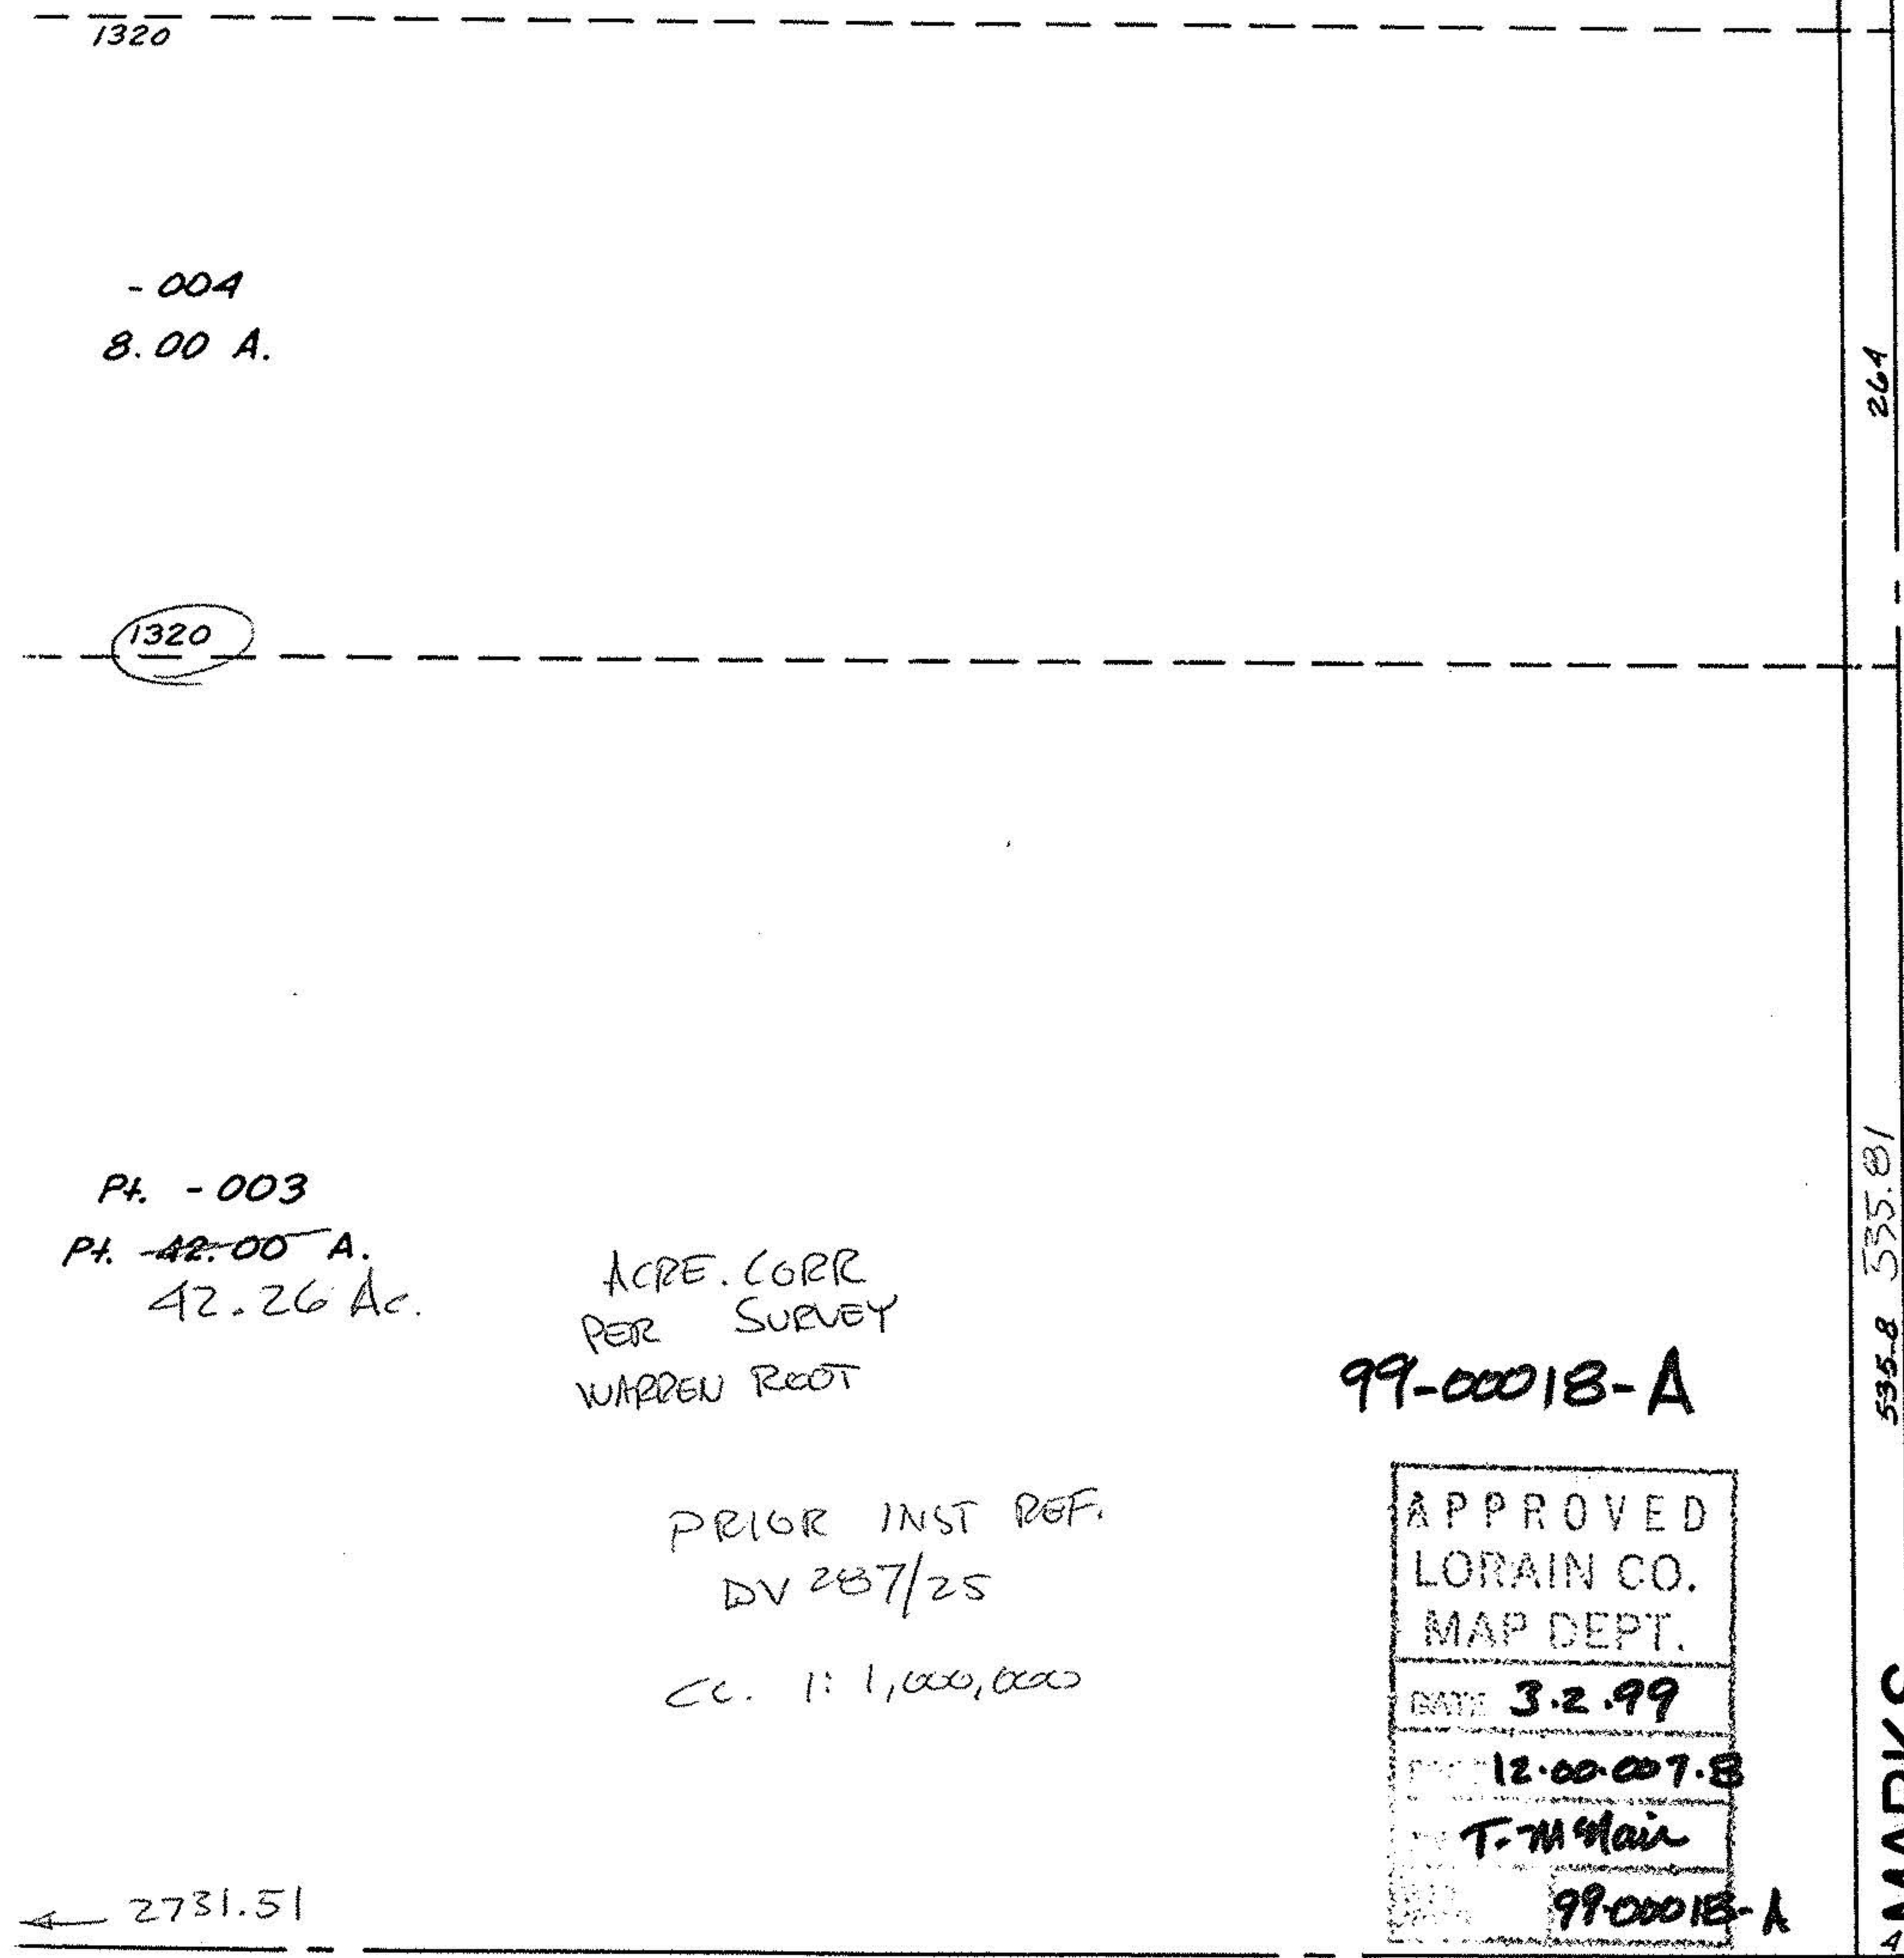

00-008-B

007-B

MARKS