PLAT OF SURVEY - PARCEL SPLIT

SITUATED IN THE STATE OF OHIO, COUNTY OF LORAIN, TOWNSHIP OF COLUMBIA, LOT Nº 3

MADE FOR: HELEN E. COOK
VOLUME 1310 PAGE 308

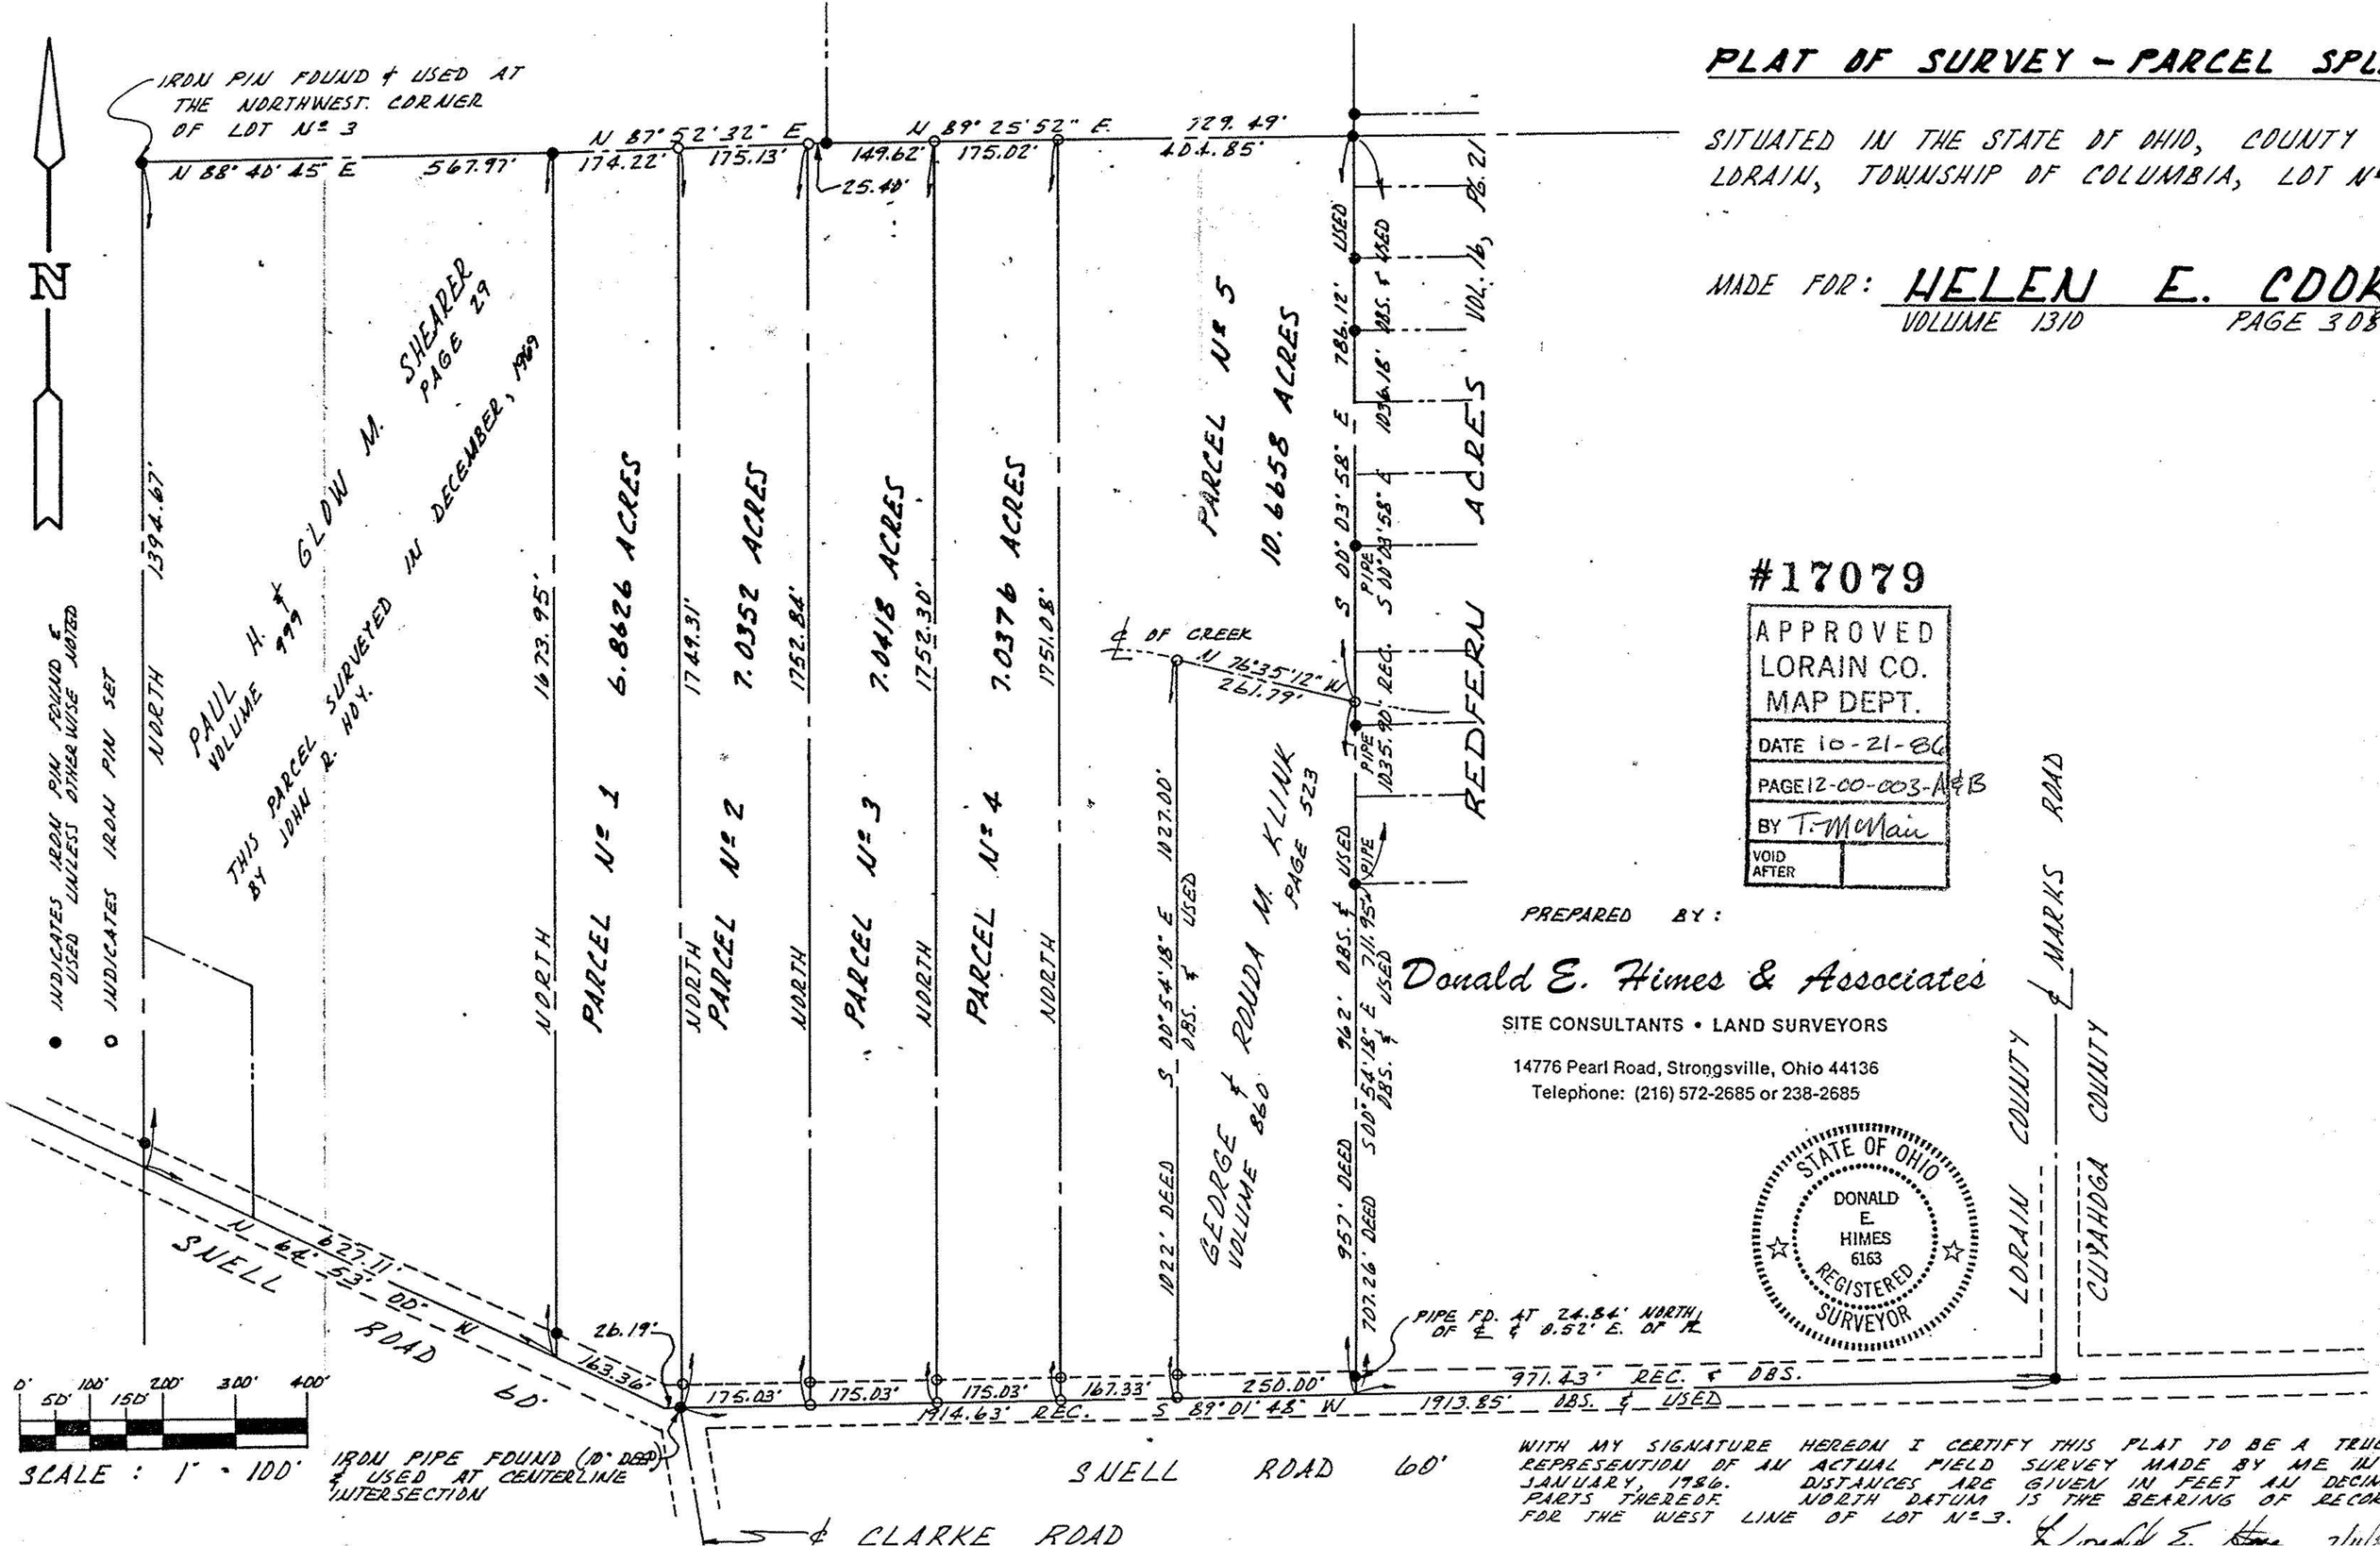

#17079

APPROVED
LORAIN CO.
MAP DEPT.
DATE 10-21-86
PAGE 12-00-003-A&B
BY T. McMain
VOID AFTER

PREPARED BY:

Donald E. Himes & Associates

SITE CONSULTANTS • LAND SURVEYORS

14776 Pearl Road, Strongsville, Ohio 44136
Telephone: (216) 572-2685 or 238-2685

STATE OF OHIO
DONALD E. HIMES
6163
REGISTERED SURVEYOR

WITH MY SIGNATURE HEREON I CERTIFY THIS PLAT TO BE A TRUE REPRESENTION OF AN ACTUAL FIELD SURVEY MADE BY ME IN JANUARY, 1986. DISTANCES ARE GIVEN IN FEET AN DECIMAL PARTS THEREOF. NORTH DATUM IS THE BEARING OF RECORD FOR THE WEST LINE OF LOT Nº 3.

Donald E. Himes 7/11/86