LAUNDON • SIMON • CAHL & ASSOC., INC.
CONSULTING ENGINEERS & SURVEYORS
110 MIDDLE AVE., ELYRIA, O. 44035

SURVEY FOR:

ROBERT PECK

Orig. Lot 47	City of LORAIN	Date AUG. '96 Scale 1"= 40'
Orig. Sec	Village of	Dwn. by R.G.S. Chkd. by R.C.
Tract	County of LORAIN	Job No. 96-2889 F.B. 239/52
Township of SHEFFIELD	State of OHIO	Printed
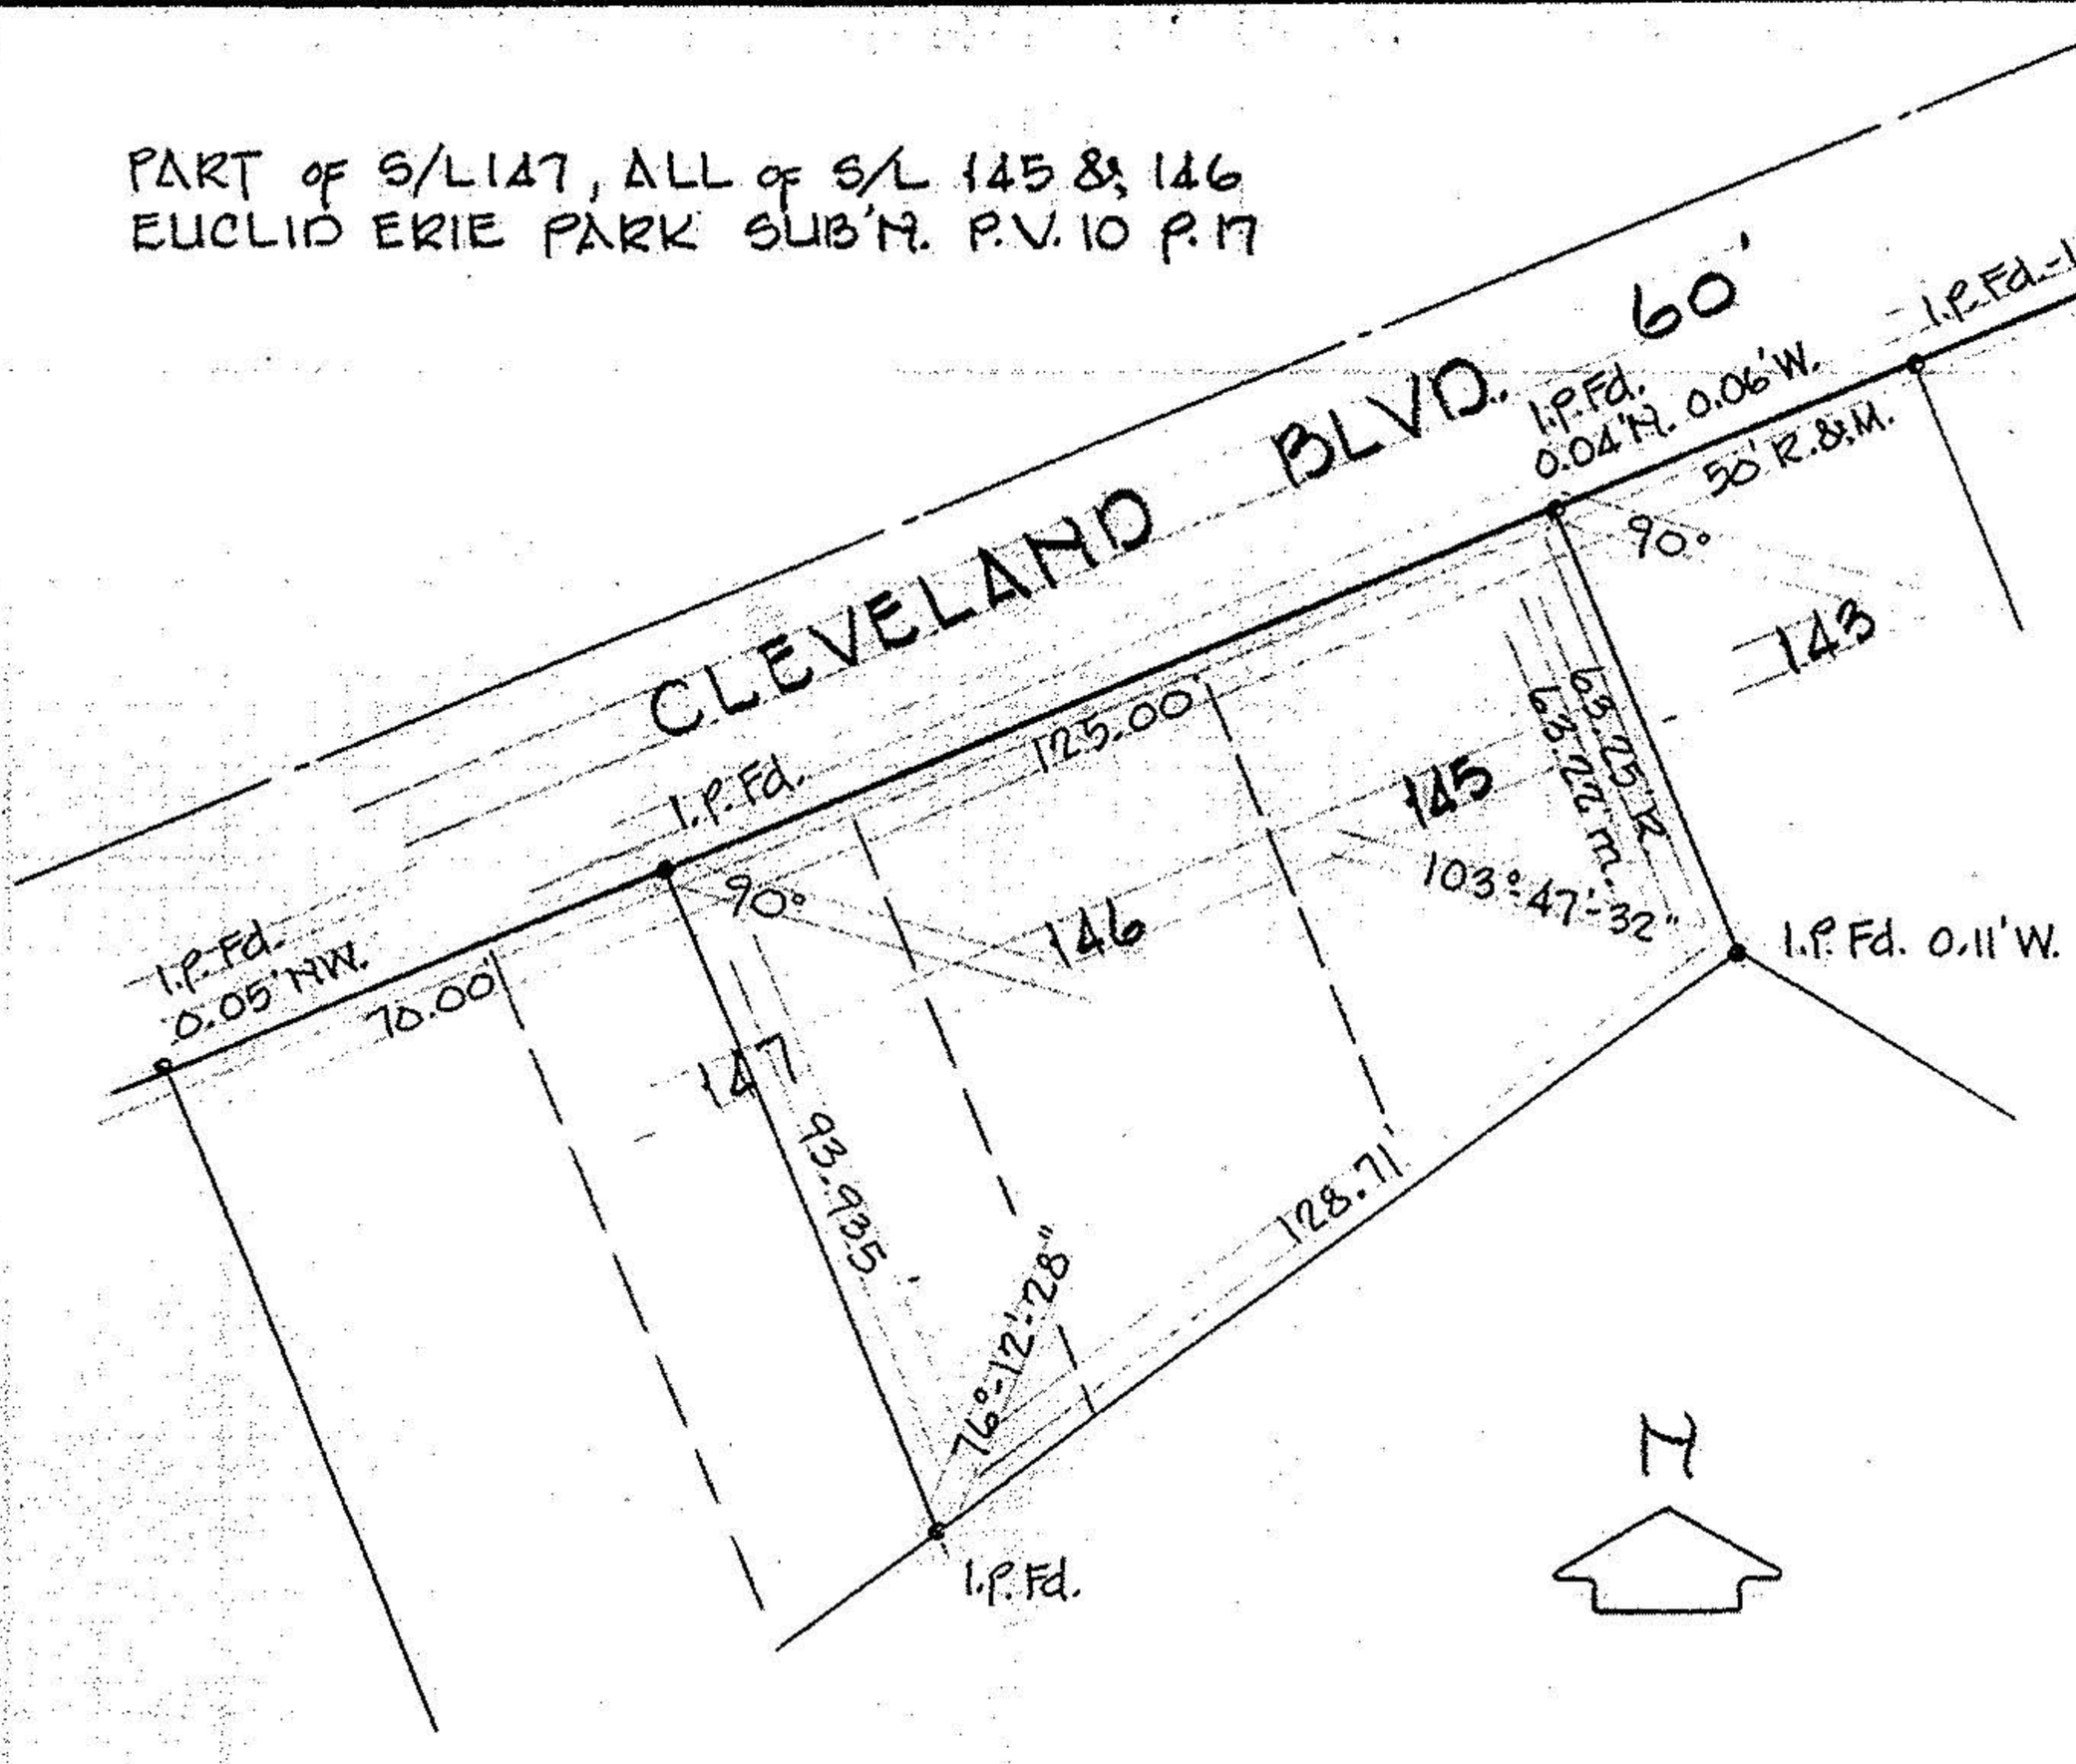
PART of S/L 147, ALL of S/L 145 & 146
EUCLID ERIE PARK SUB'N. P.V. 10 P. 17