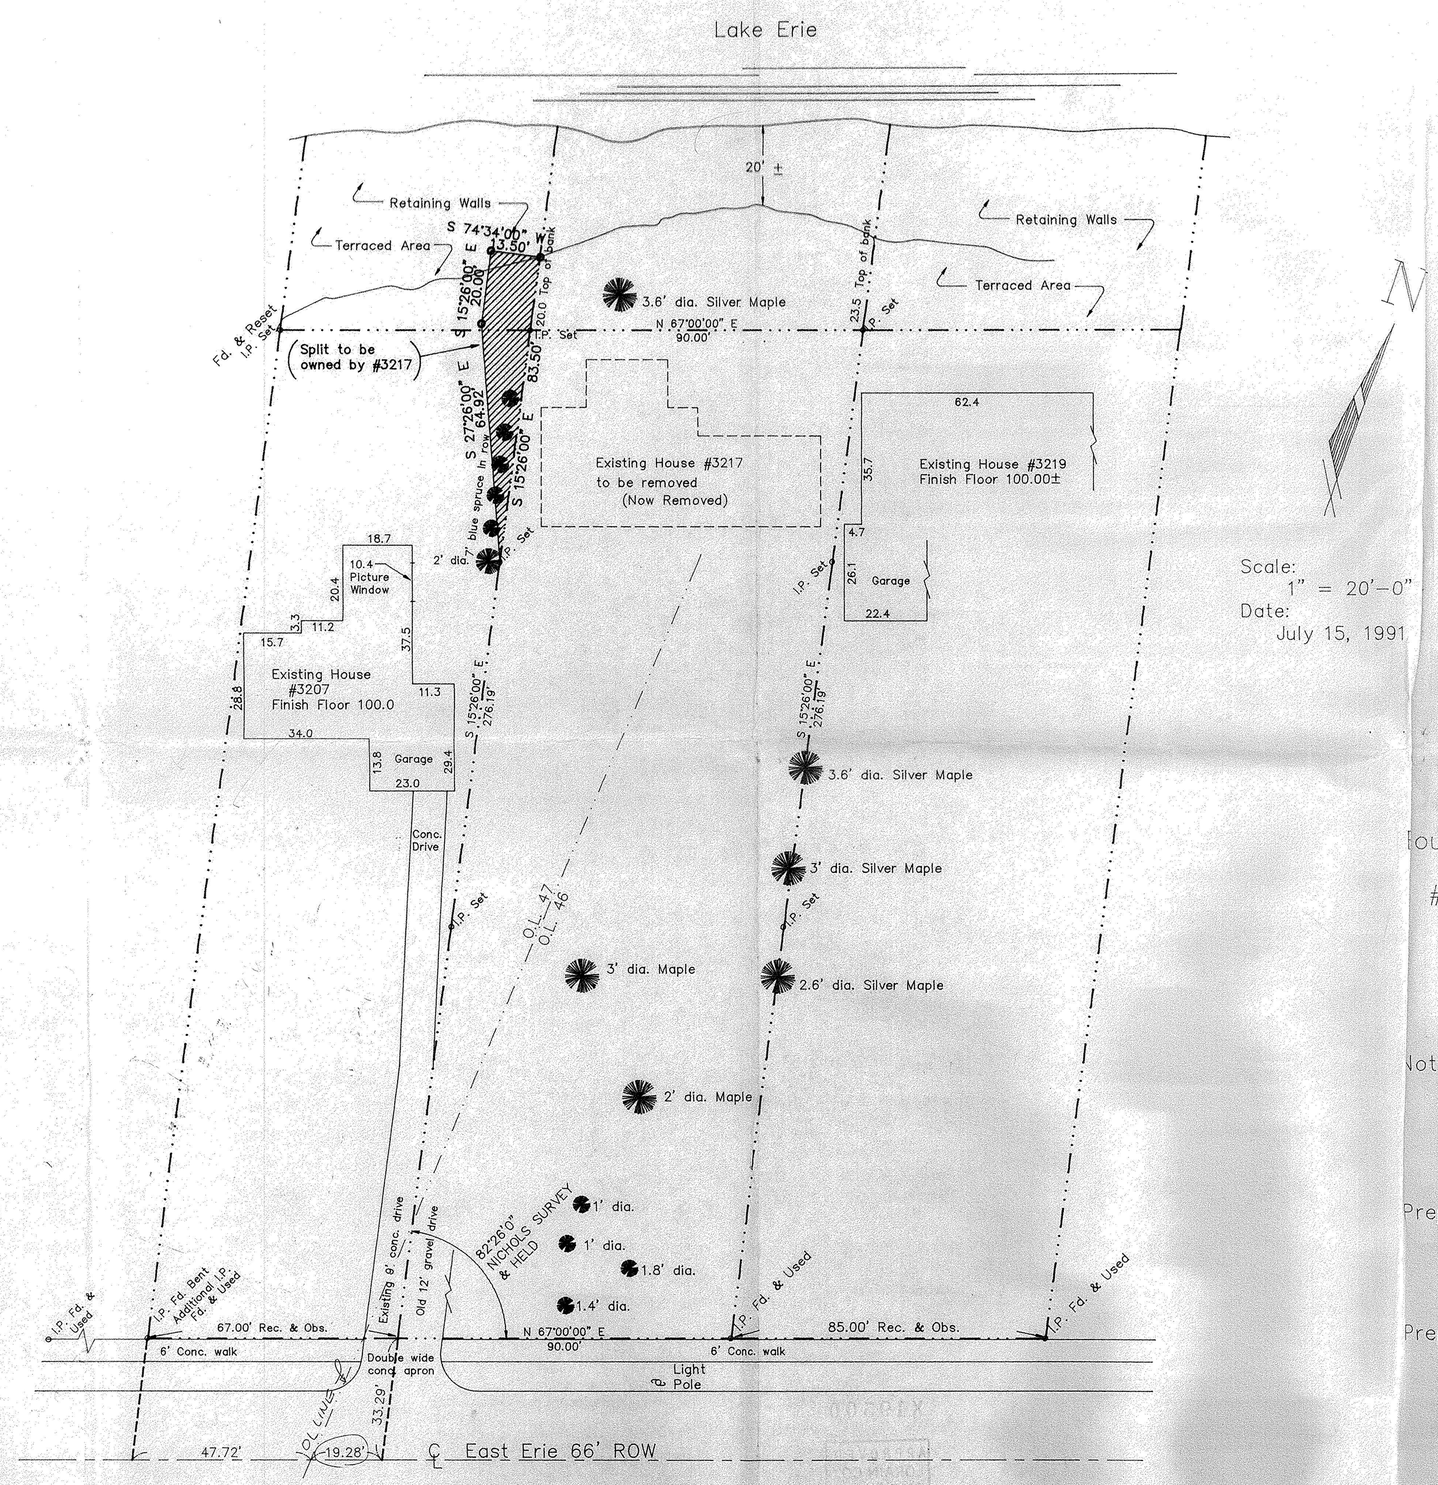

Scale:
1" = 20'-0"
Date:
July 15, 1991

Boundary & Location
Survey
3207 & # 3217
East Erie Avenue

Note:
Survey Reconstructed from J.B. Nichols survey dated June 24, 1952

Prepared for:
Dr. Carlos Pena
3207 East Erie
Lorain, Ohio 44052

Prepared by:
J.R. Foor & Associates
Registered Surveyors
35888 Center Ridge Rd.
N. Ridgeville, Ohio 44039

APPROVED
AS TO DESCRIPTION ONLY
Date 7-31-91
City of Lorain
Per Lowell A. Kuenzel
Engineering Dept.

APPROVED BY THE LORAIN CITY PLANNING COMMISSION 7-31-91 NO PLAT REQUIRED
SECRETARY LORAIN CITY PLANNING COMMISSION