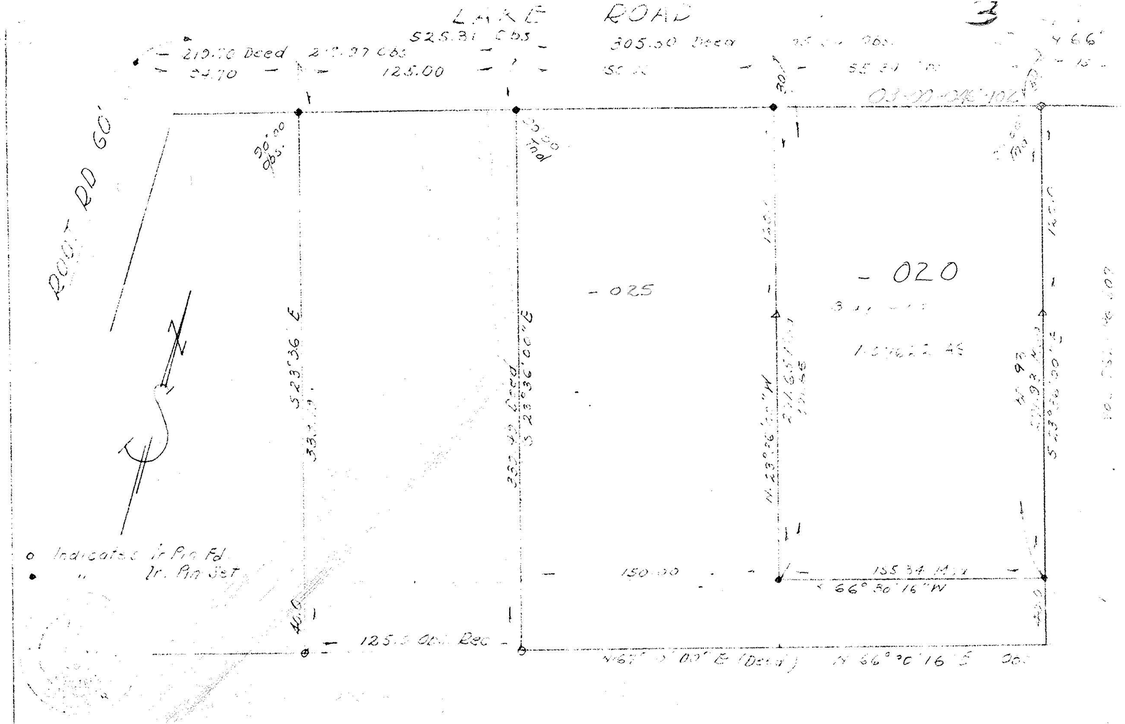

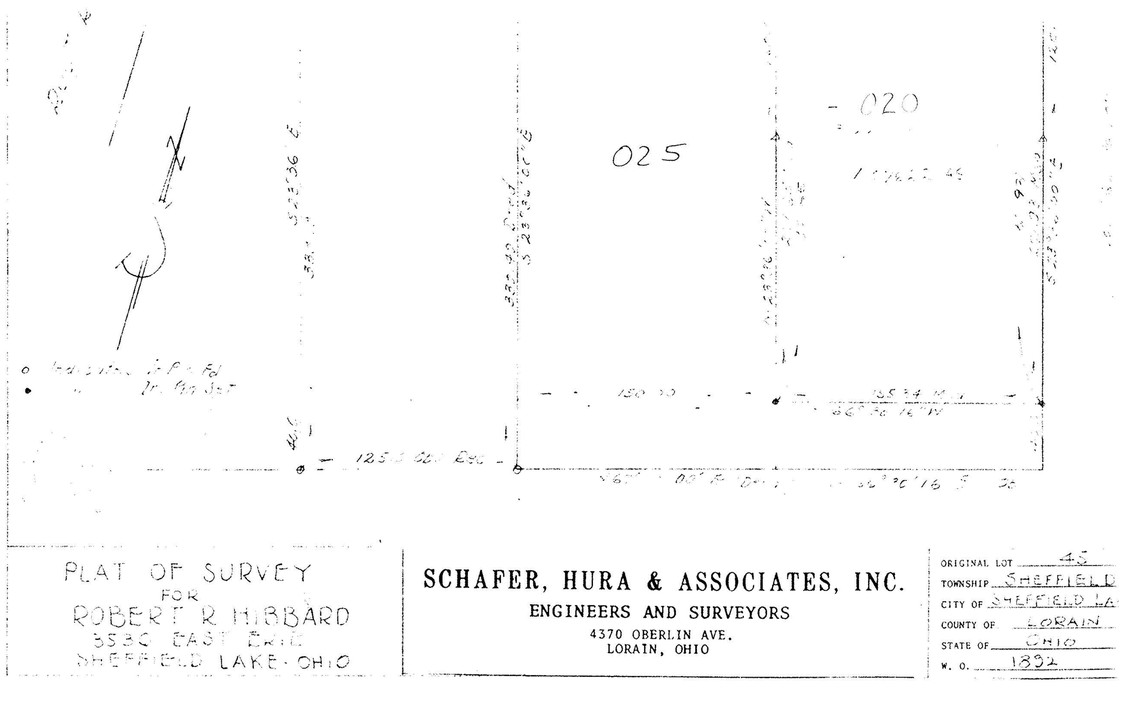

PLAT OF SURVEY
FOR
ROBERT R HIBBARD
3580 EAST ERIE
SHEFFIELD LAKE, OHIO

SCHAFER, HURA & ASSOCIATES, INC.
ENGINEERS AND SURVEYORS
4370 OBERLIN AVE.
LORAIN, OHIO

ORIGINAL LOT 45
TOWNSHIP SHEFFIELD
CITY OF SHEFFIELD LA
COUNTY OF LORAIN
STATE OF OHIO
W. O. 1892