LAUNDON • SIMON • CAHL & ASSOC., INC.
CONSULTING ENGINEERS & SURVEYORS
110 MIDDLE AVE., ELYRIA, O. 44035

SURVEY FOR:
JOHN K. & TAMARA K. PERRY
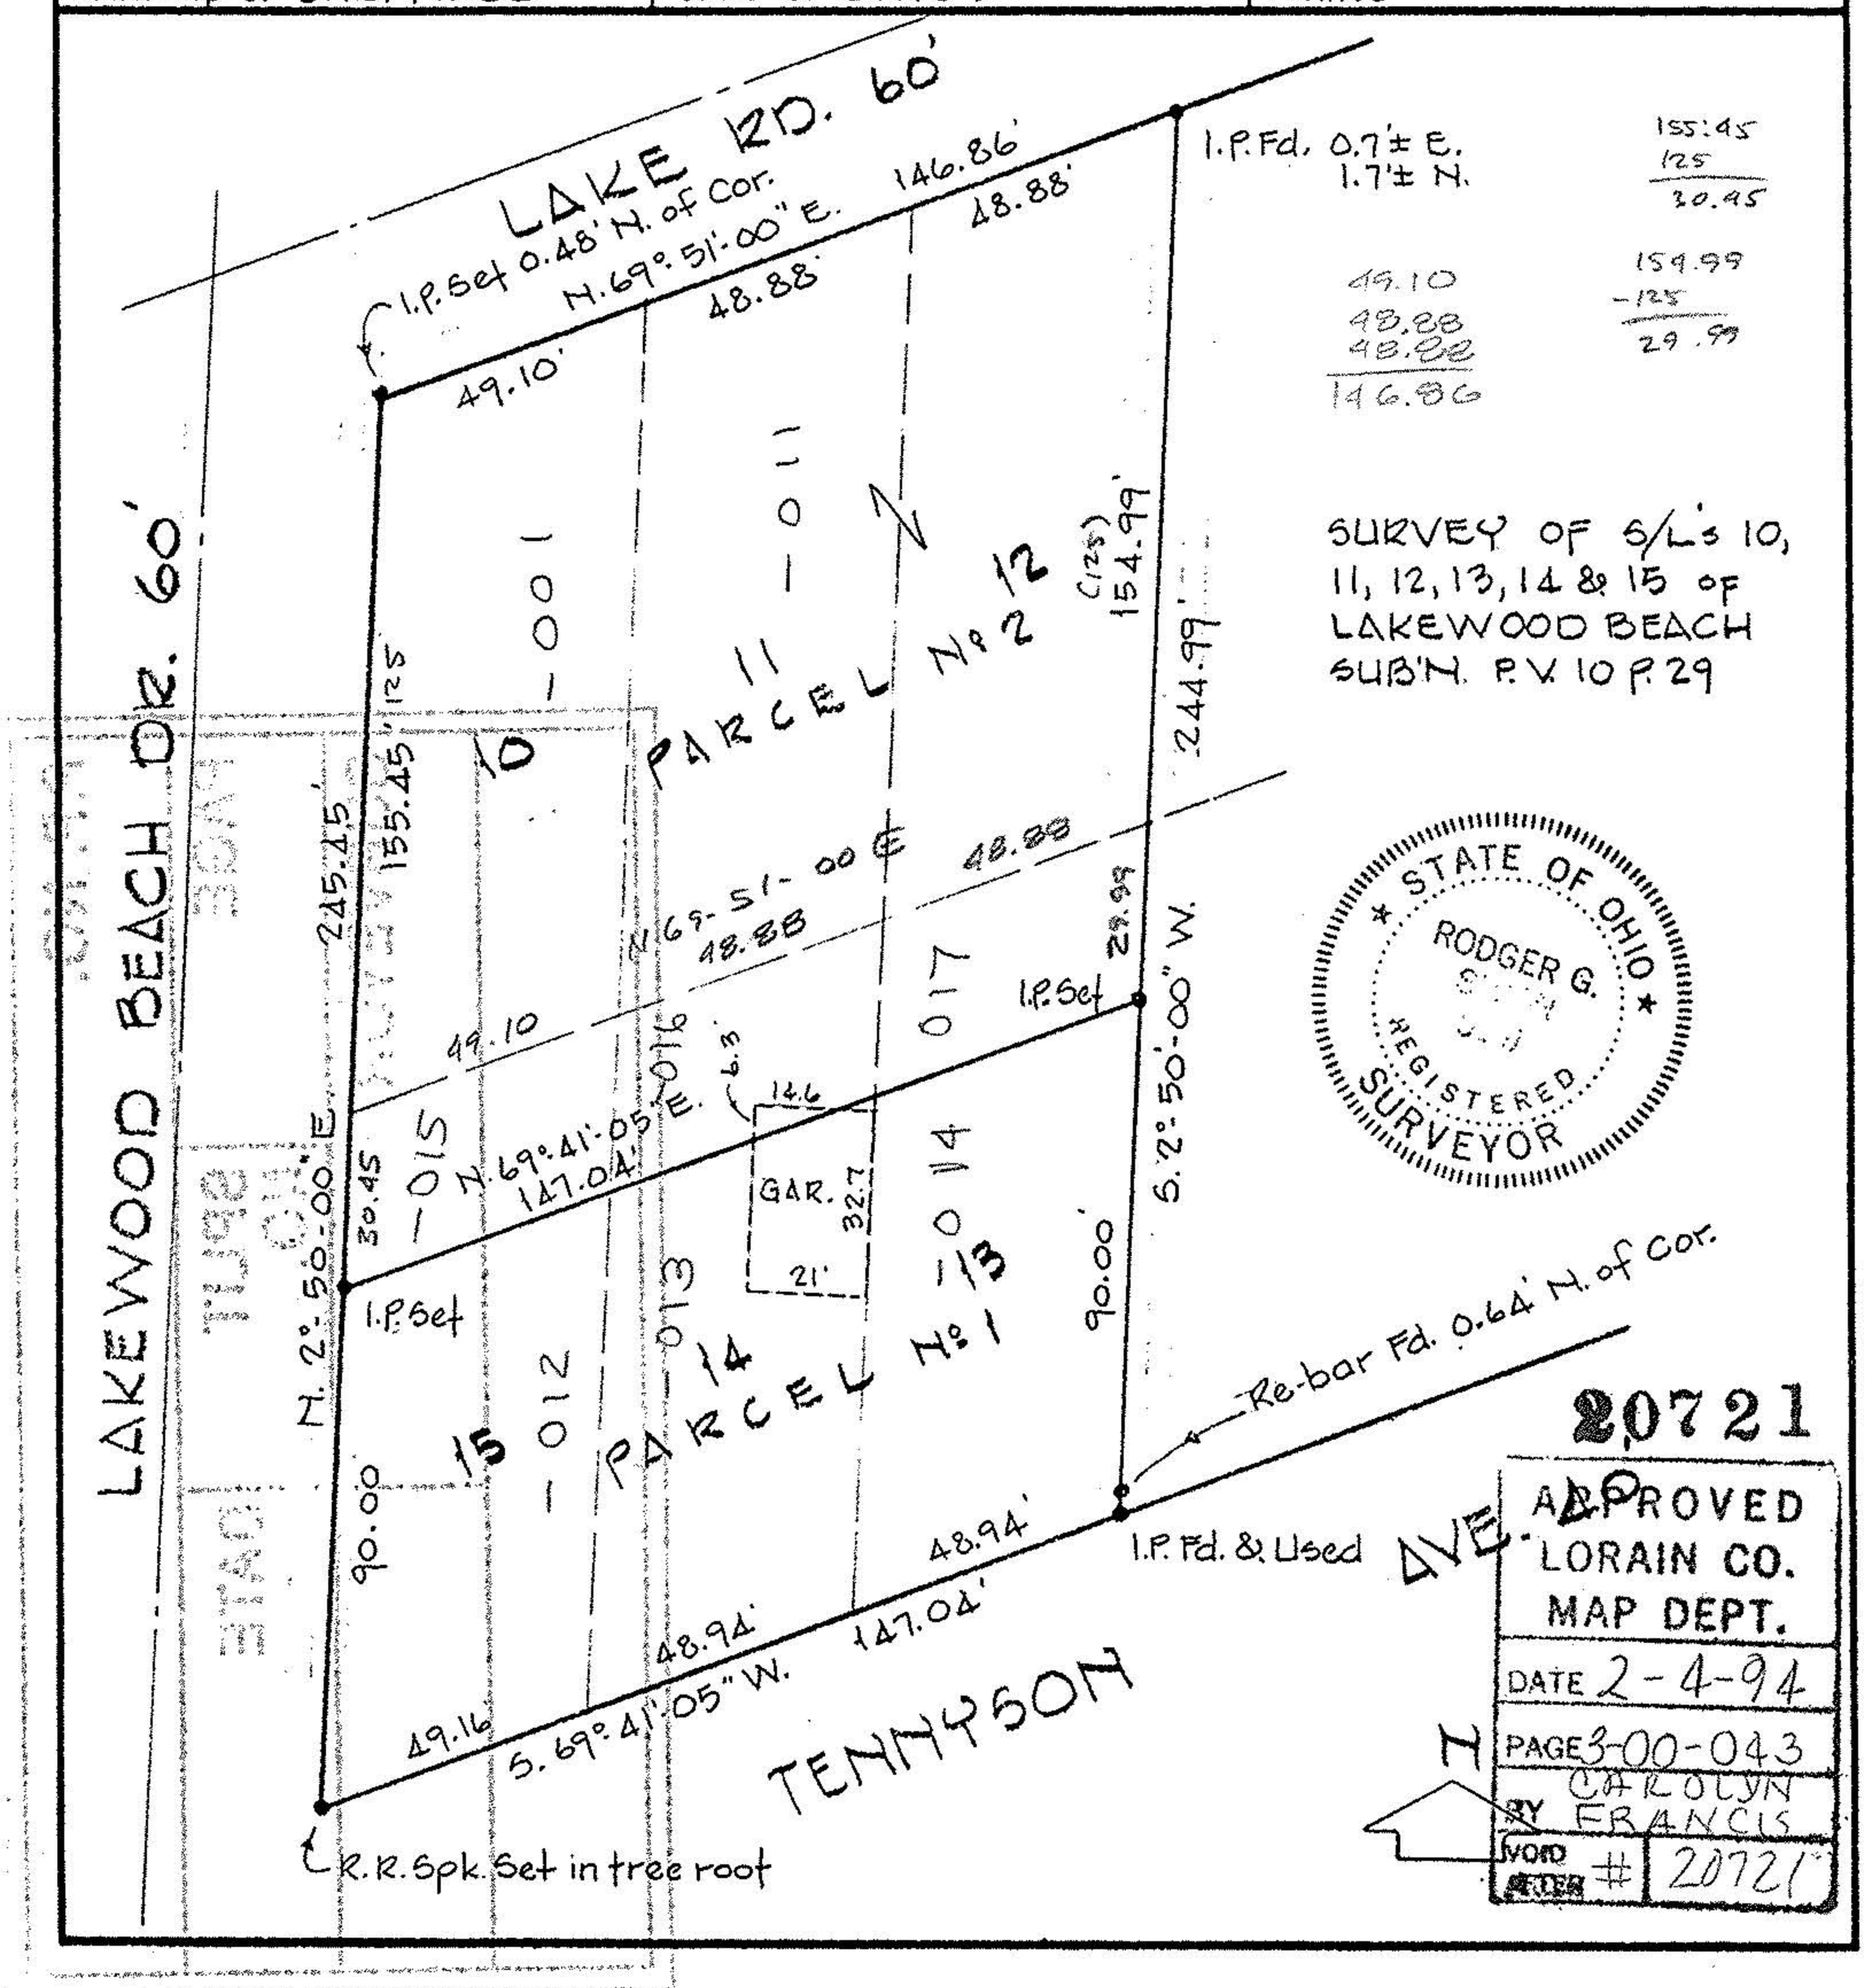
Orig. Lot 43	City of SHEFFIELD LAKE	Date 3-11-93 Scale 1"=40'
Orig. Sec	Village of	Dwn. by R.G.S. Chkd. by R.C.
Tract	County of LORAIN	Job No. 93-2304 F.B. 229/10-11
Township of SHEFFIELD	State of OHIO	Printed