20813

APPROVED
LORAIN CO.
MAP DEPT.
DATE 5-10-94
PAGE 15-00-098-A
BY CAROLYN FRANCIS
VOID AFTER # 20813

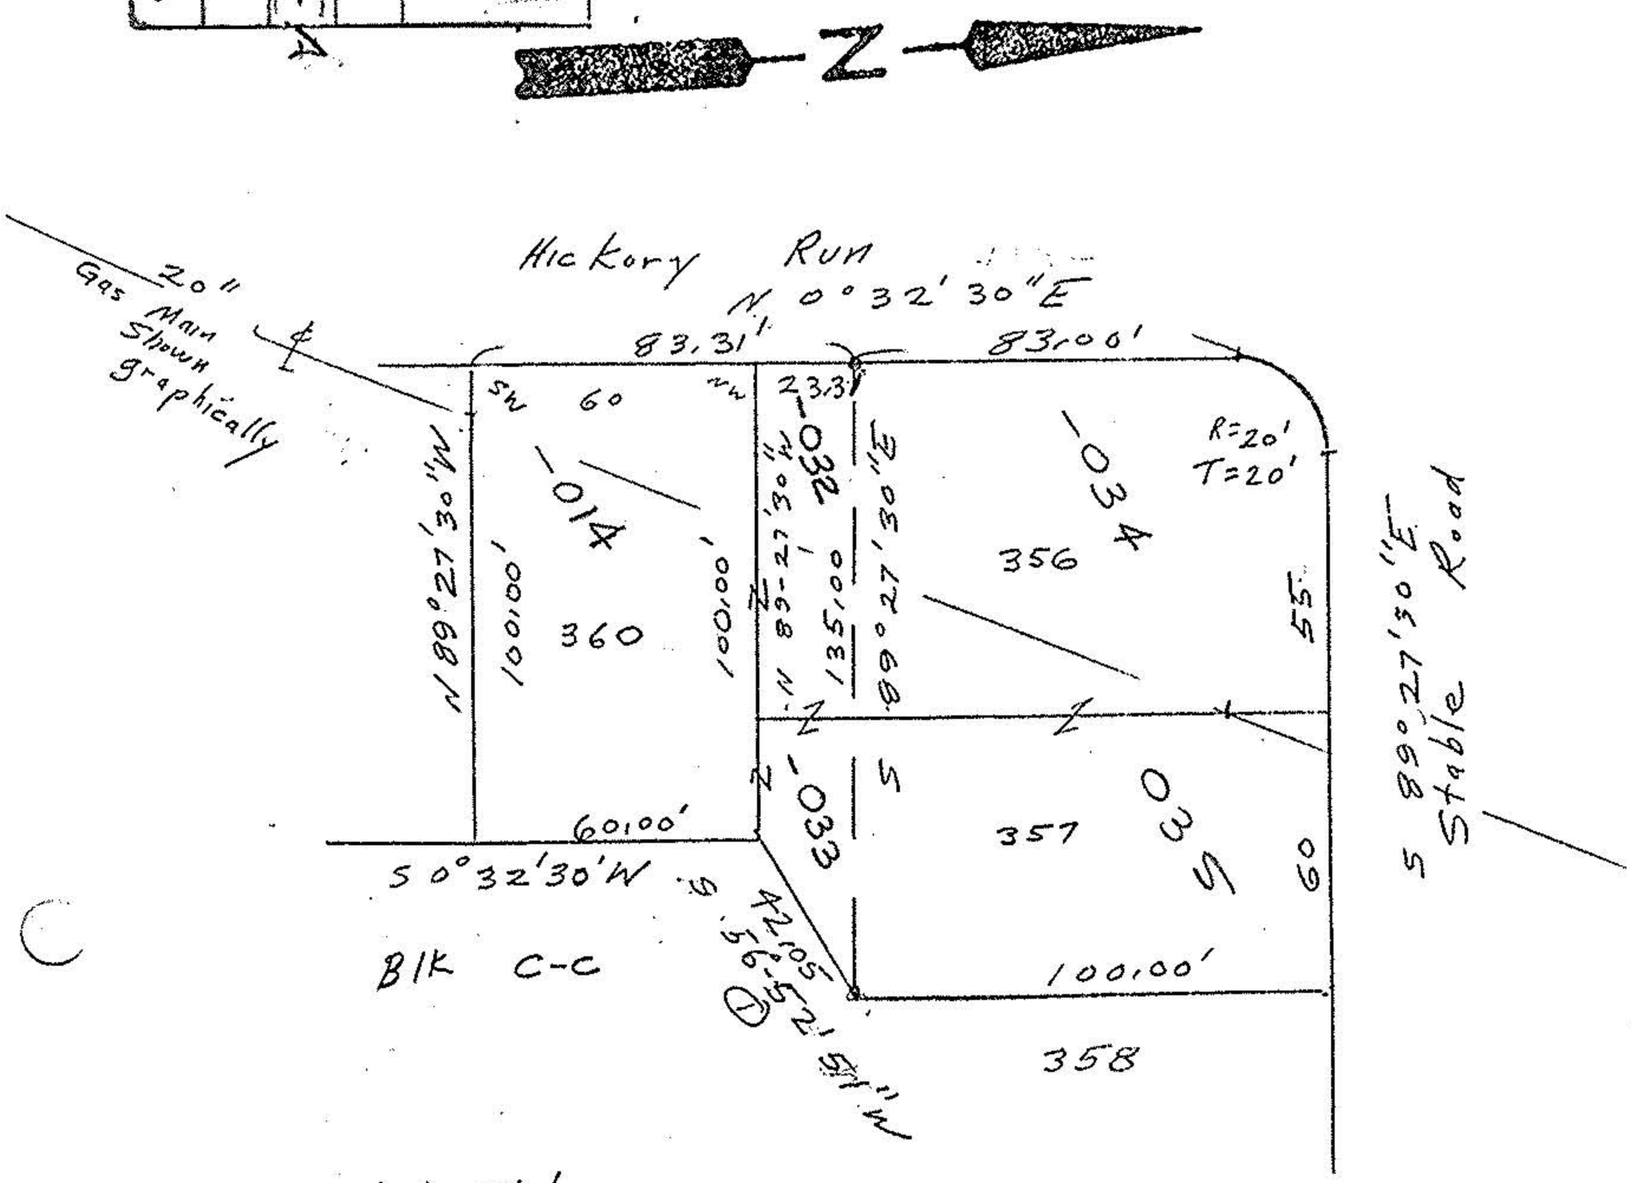

① Recorded Plat Bearing S 56°47'41"W

o iron pipes fd
• iron pipes set

Parcel Split of sublots 356 & 357
Pheasant Run Village Phase 1
Plat Volume 27 pages 16-19
Original Lot 98 La Grange Township

Lorain County Ohio
Scale 1"=50 April 1994
May 5, 1994

Bernard J. Loyer II

John Pozywak
Reg Surveyor
5292

STATE OF OHIO
JOHN POZYWAK
5292
REGISTERED
SURVEYOR