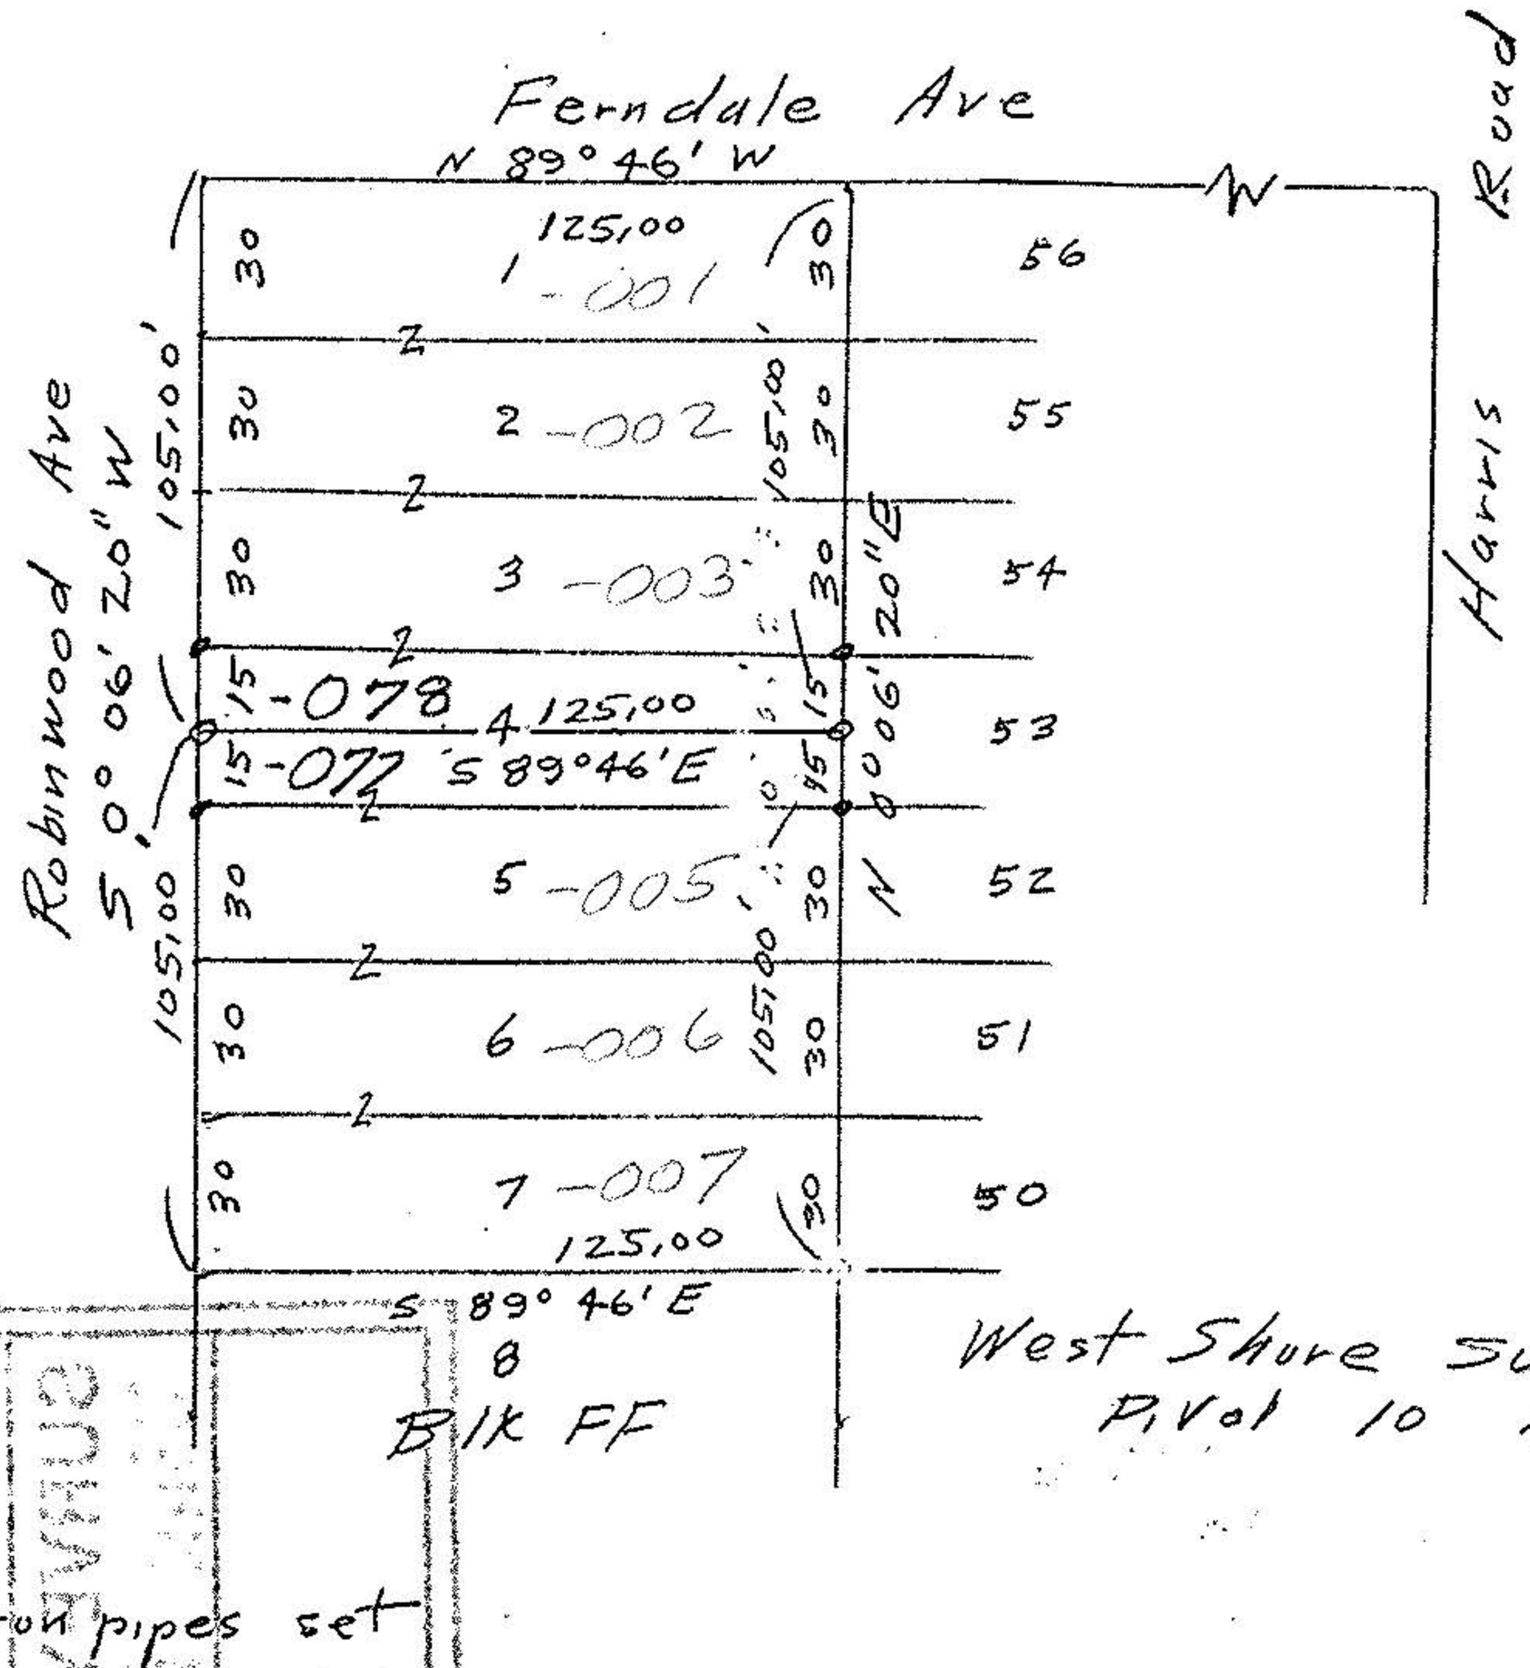

o iron pipes set

● iron pipes fd

Survey for Russell Halstead

sublots 1, 2, 3 and north half of 4
subots 5, 6, 7 and south half of 4

ORIGINAL LOT 38	DATE July 1993
TOWNSHIP Sheffield	SCALE 1"=60'
CITY OF Sheffield Lake	FIELD BOOK N/A
COUNTY OF Lorain	DRAWN BY J.Poz
STATE OF Ohio	CHECKED BY
W. O.	FILE NO.