LAKEWOOD SURVEYS
LAND SURVEYING
14567 Madison Ave. #601
Lakewood, Ohio 44107
216-521-6960

#21923

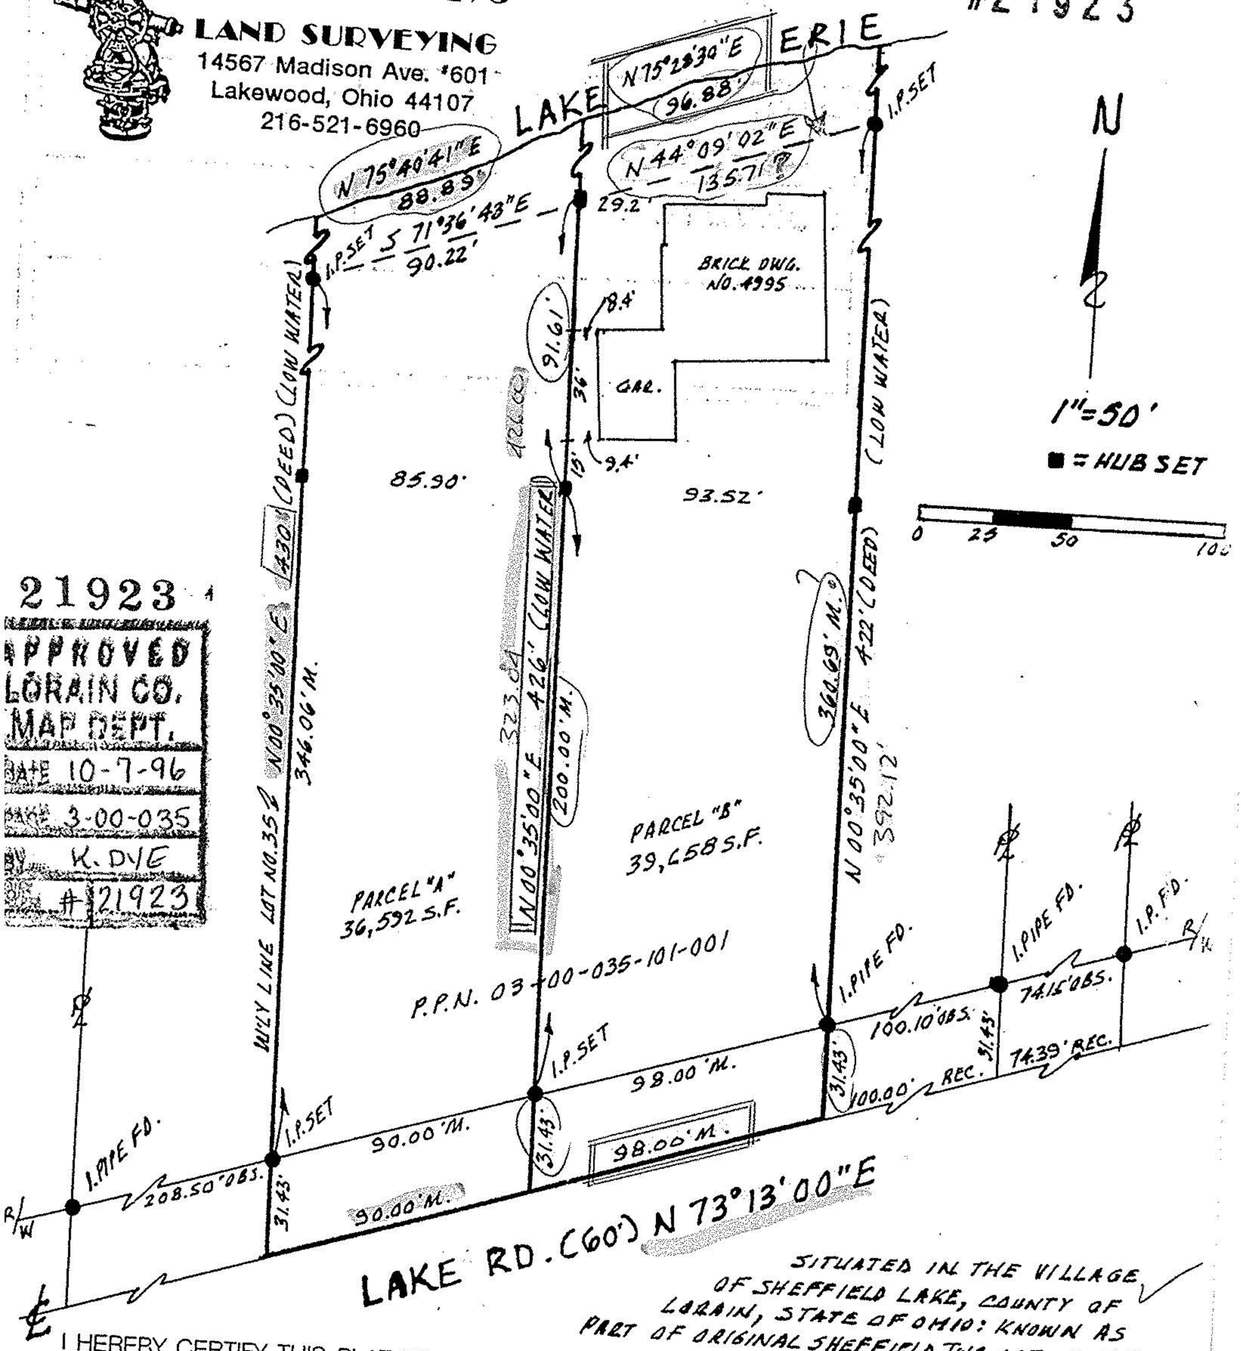

21923
APPROVED
LORAIN CO.
MAP DEPT.
DATE 10-7-96
PAGE 3-00-035
BY K. DYE
21923

SITUATED IN THE VILLAGE OF SHEFFIELD LAKE, COUNTY OF LORAIN, STATE OF OHIO: KNOWN AS PART OF ORIGINAL SHEFFIELD TWP. LOT NO. 35

I HEREBY CERTIFY THIS PLAT TO BE THE CORRECT RETURN OF THE FIELD NOTES OF A SURVEY MADE ON SEPTEMBER 27, 1995. DISTANCES ARE IN FEET AND DECIMAL PARTS THEREOF. BEARINGS ARE TO AN ASSUMED MERIDIAN AND USED TO DETERMINE ANGLES ONLY.

RVEY MADE FOR: S. DELANEY

John K. Sinatra, P.S.
John K. Sinatra, Professional Surveyor #4903

REVISED 09/15/96 [illegible]

LAKEWOOD SURVEYS
LAND SURVEYING
14567 Madison Ave. #601
Lakewood, Ohio 44107
216-521-6960

ADD BEARING & DISTANCE TO BOTH COURSES IN DESCRIPTION, ALSO SHOW THESE COURSES ON YOUR MAP SO DESCRIPTION OF YOUR SURVEY CAN BE CHECKED

ADD STATEMENT TO SAY WHOM SURVEY WAS DONE FOR AND COUNTY OF LORAIN PT. OF ORIGINAL LOT 35 SHEFFIELD TOWNSHIP, CITY OF SHEFFIELD LAKE, TO THIS MAP.

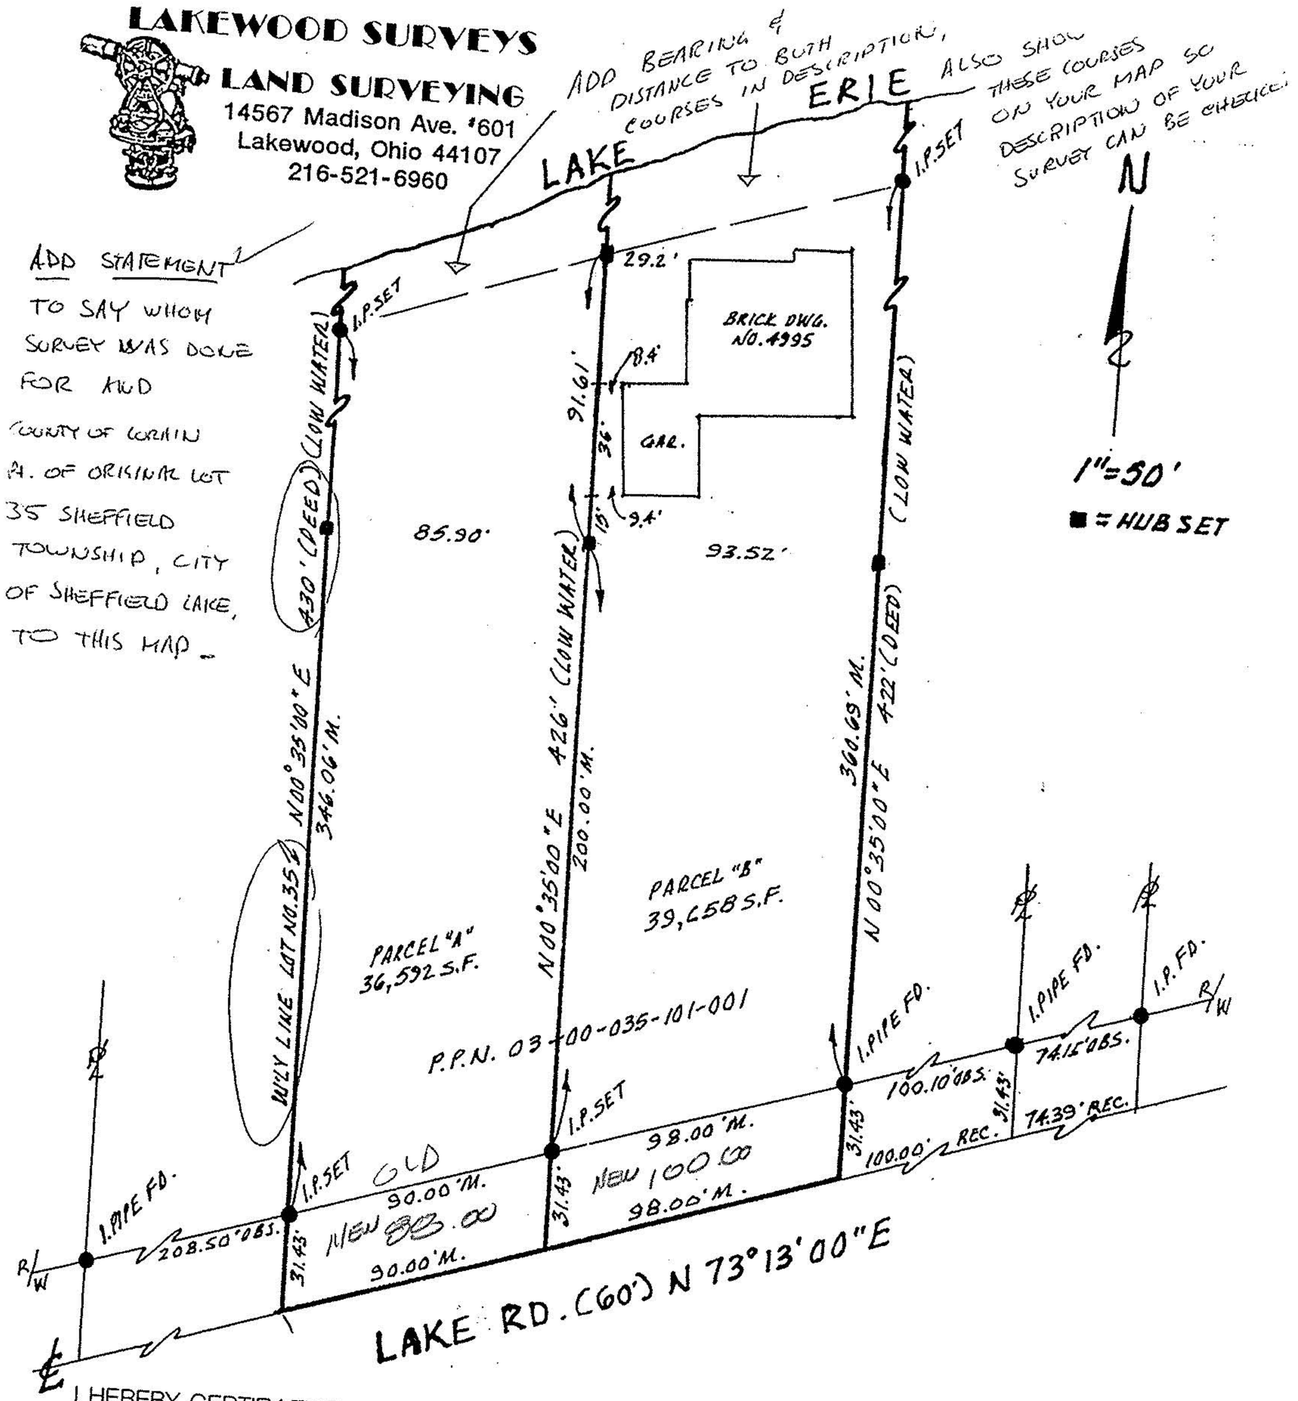

I HEREBY CERTIFY THIS PLAT TO BE THE CORRECT RETURN OF THE FIELD NOTES OF A SURVEY MADE ON SEPTEMBER 27, 1995. DISTANCES ARE IN FEET AND DECIMAL PARTS THEREOF. BEARINGS ARE TO AN ASSUMED MERIDIAN AND USED TO DETERMINE ANGLES ONLY.

John K. Sinatra, P.S.
John K. Sinatra, Professional Surveyor #4903