CITY OF SHEFFIELD LAKE, OHIO
PLANNING COMMISSION
Plans Reviewed 3/6/91
Approved
Disapproved

SURVEY OF SUB LOTS

½ 9, 10, 11
OF BORDER CITIES COMPANY
SHORE SUBDIVISION
IN SHEFFIELD LAKE

SCALE 1" = 20'

DEC. 1990

BY JOHN S PARDOE
REC. SURV. NO. 5656

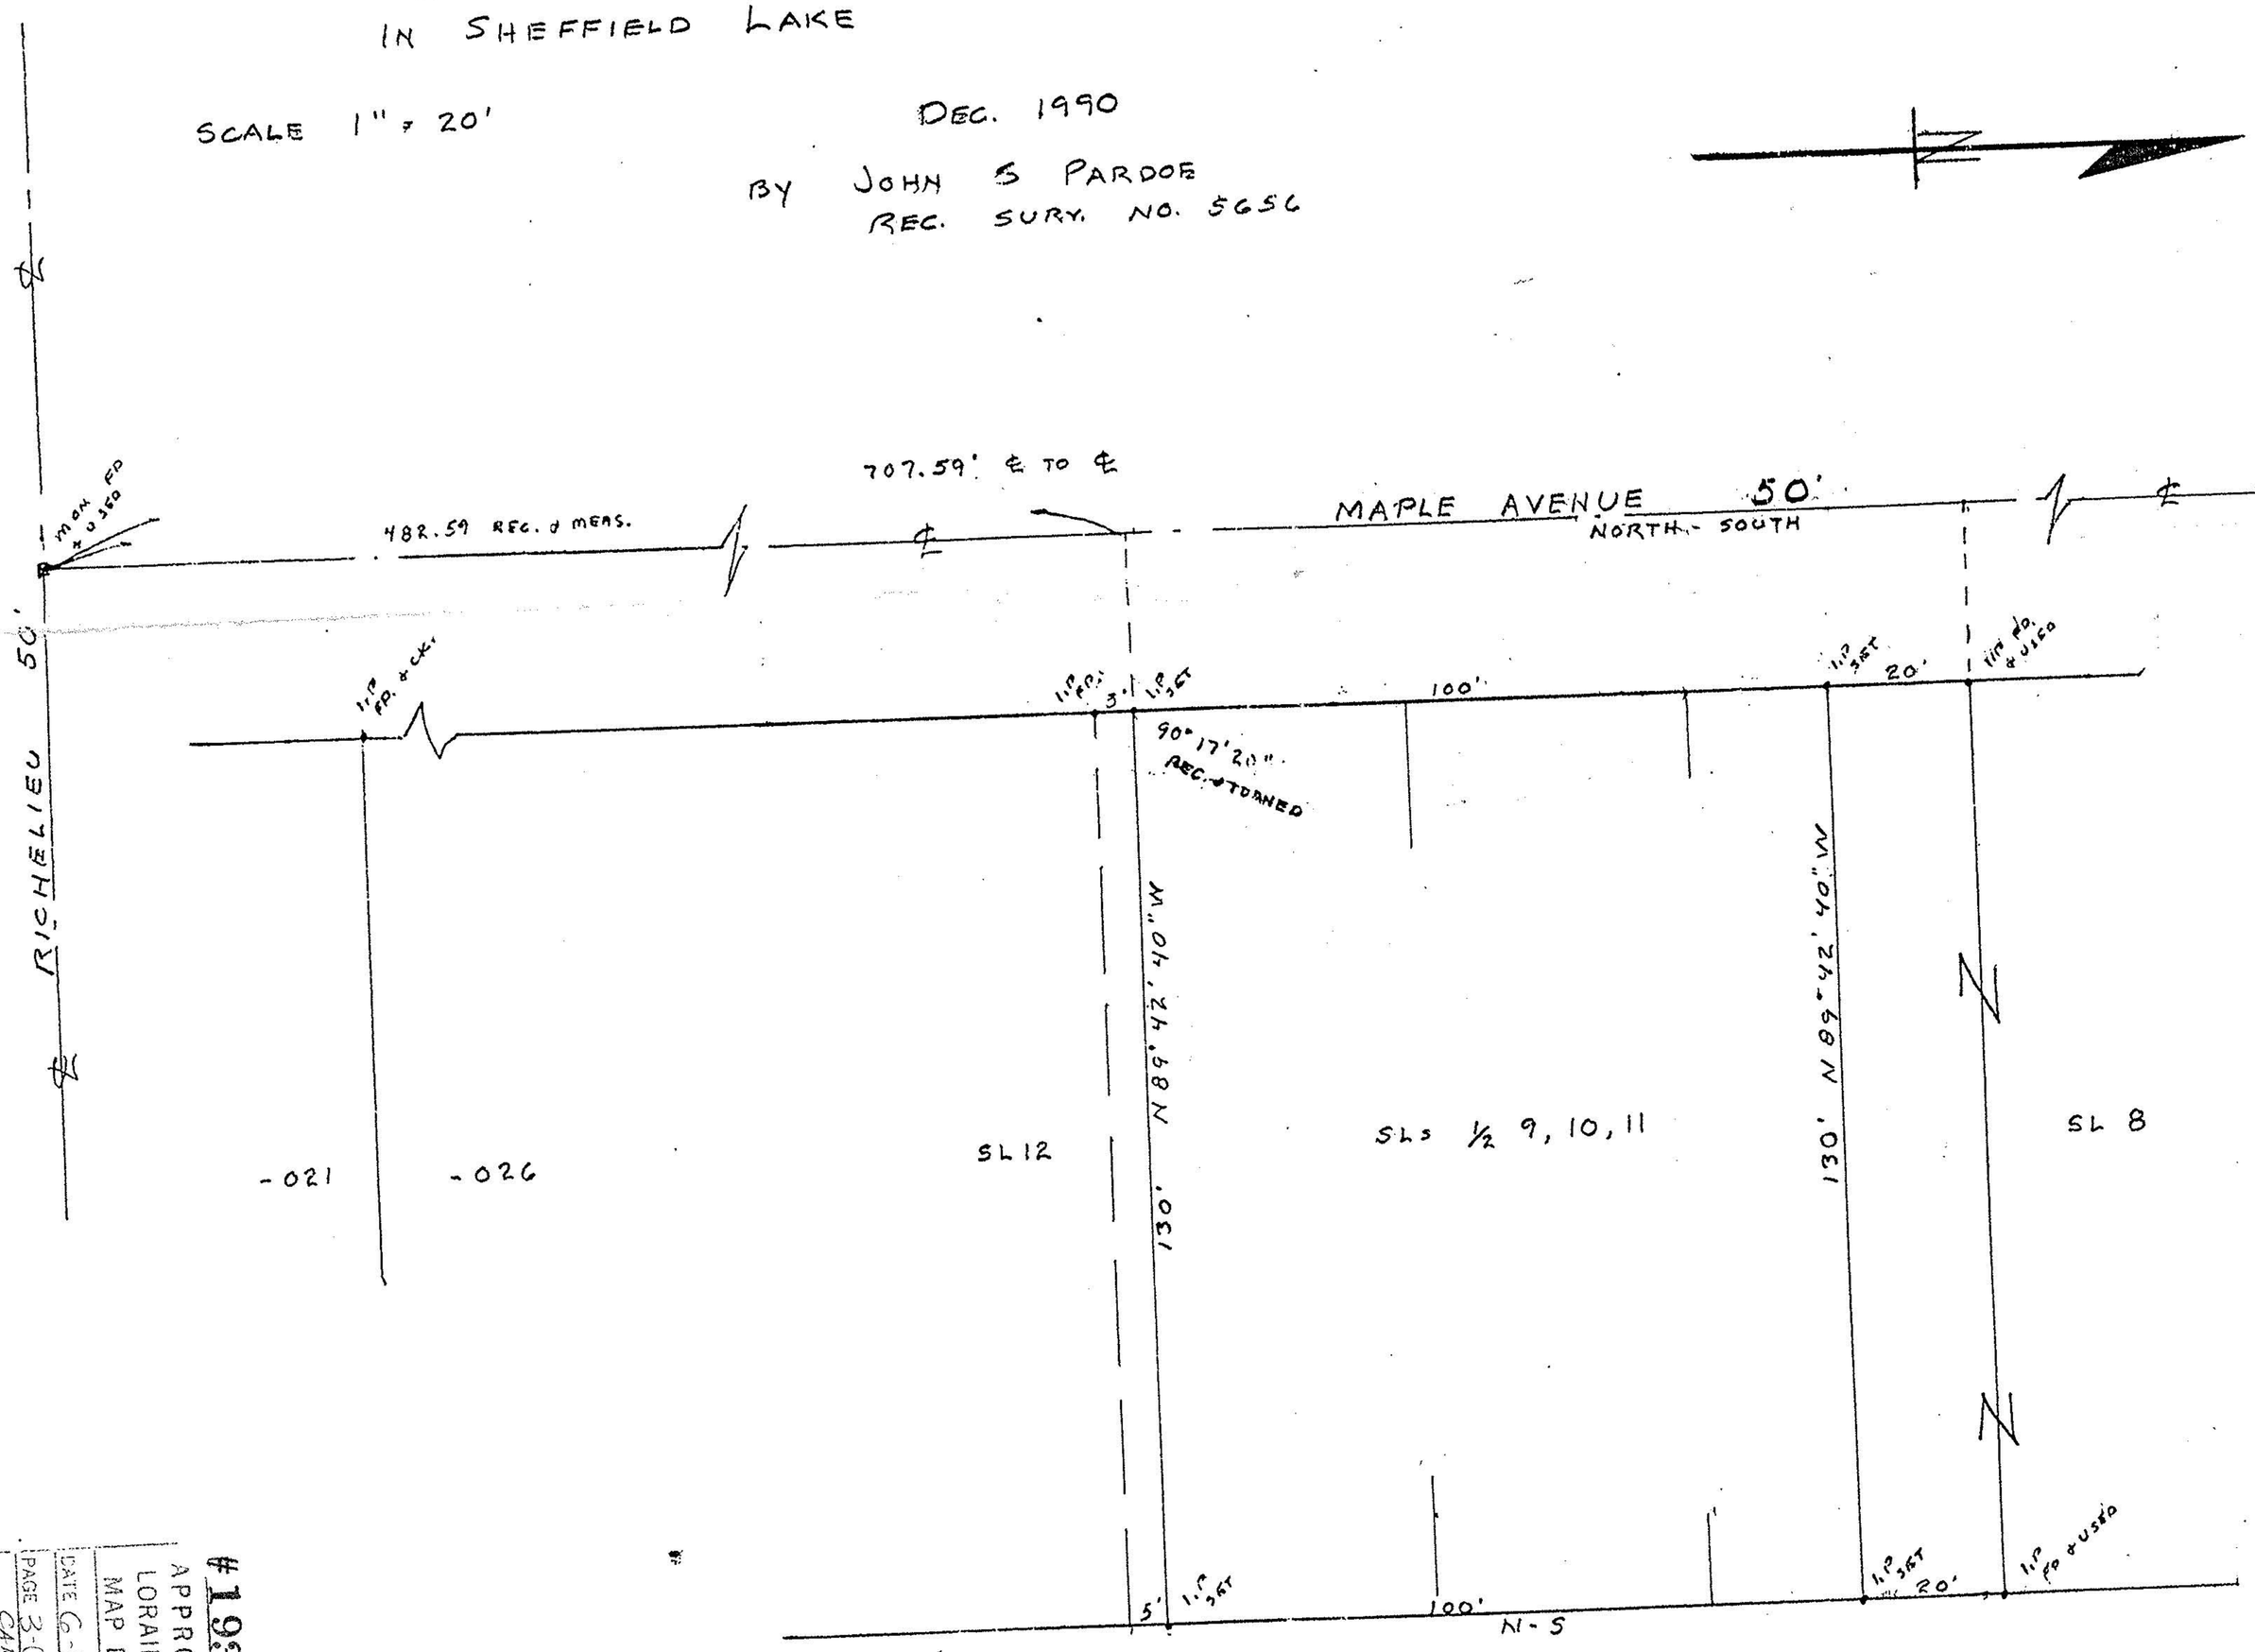

03-00-035-117-

#193662
APPROVED
LORAIN CO.
MAP DEPT.
DATE 6-10-91
PAGE 3-00-035
BY CAROLYN FRANCIS
VOID AFTER 11 / 19362