OL. 36

IRVING PARK BLVD.

03-00-036-118 3

.OL. 36

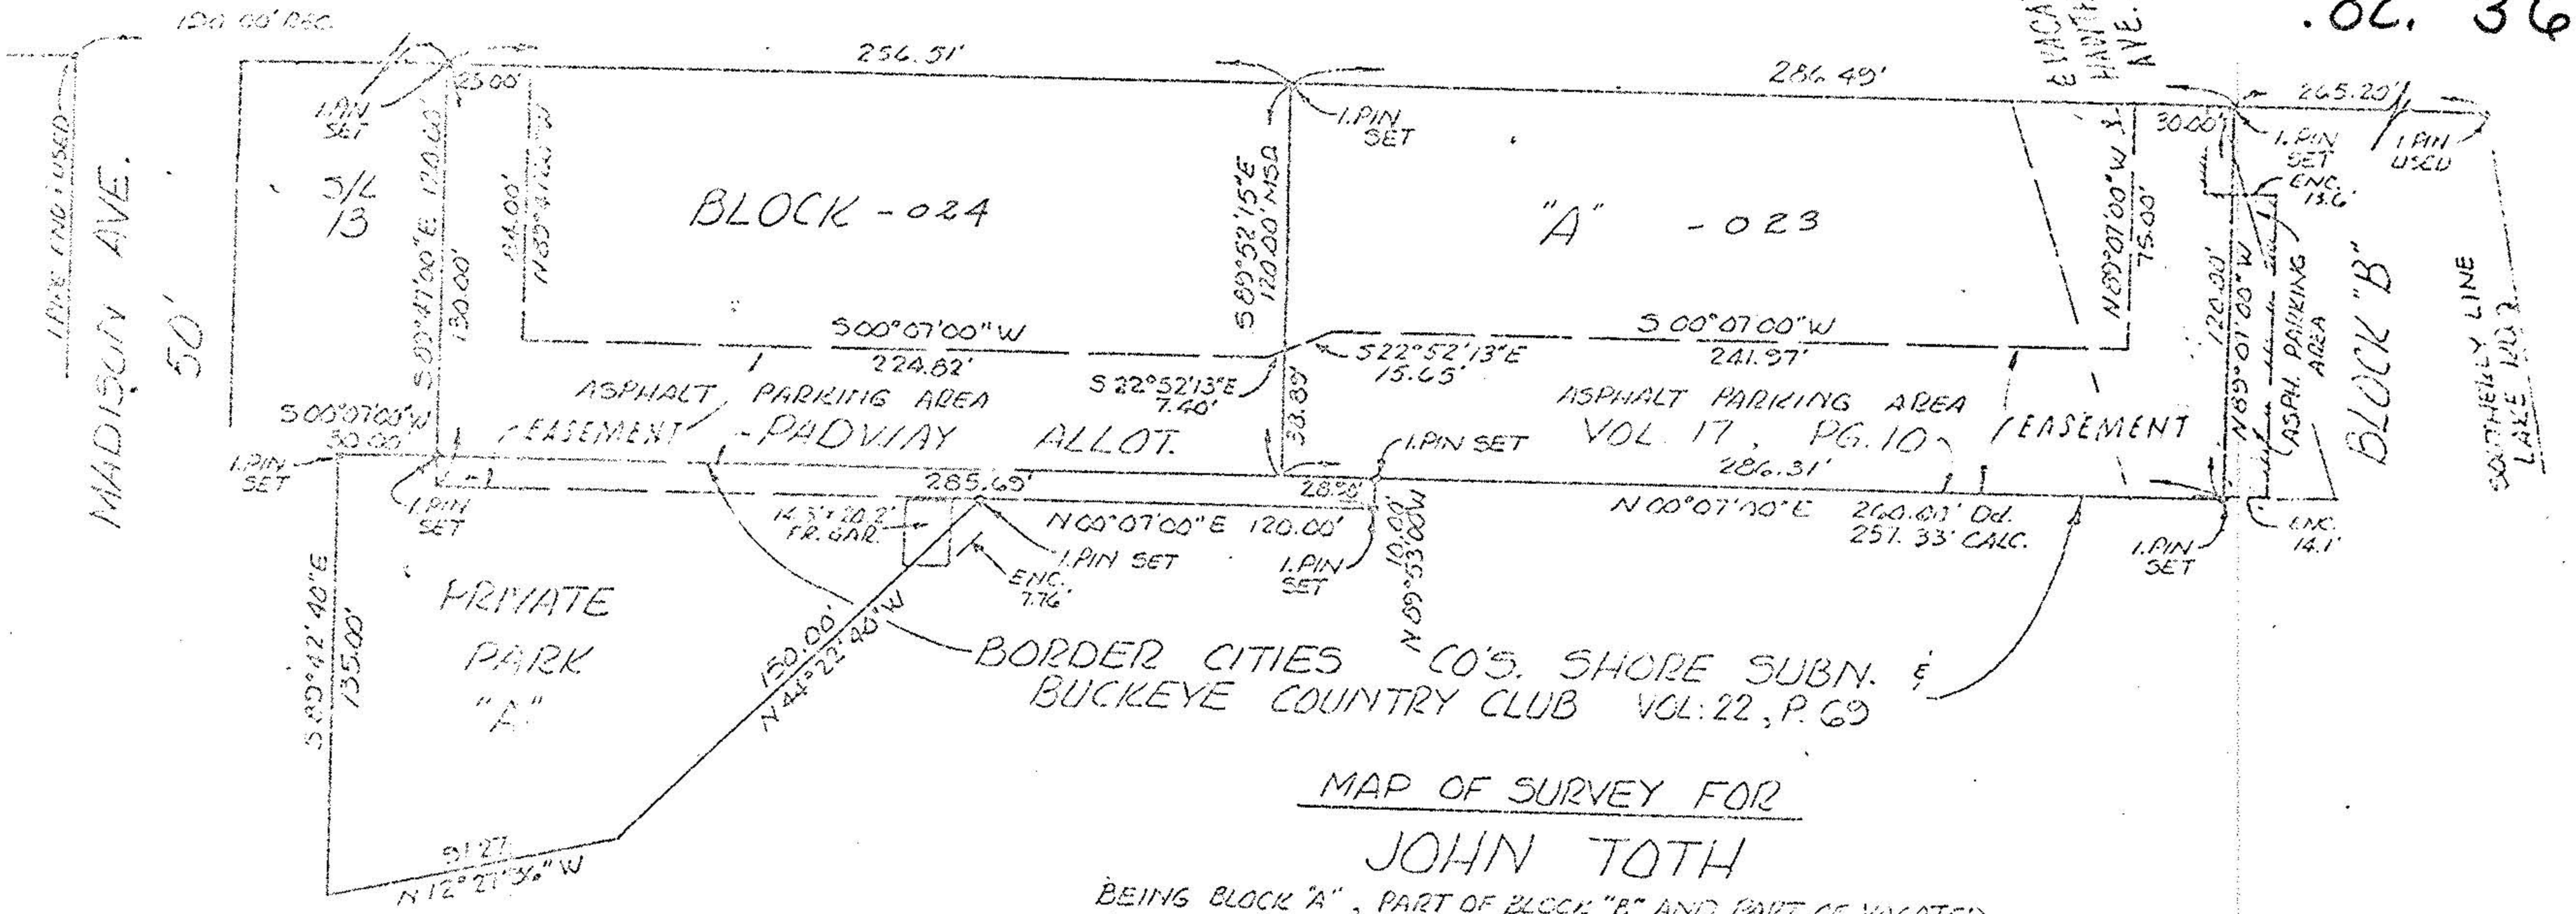

MAP OF SURVEY FOR

JOHN TOTH

BEING BLOCK "A", PART OF BLOCK "B" AND PART OF VACATED HAWTHORNE AVE. IN PADWAY ALLOTMENT OF PART OF ORIGINAL SHEFFIELD TOWNSHIP LOT NO. 36 (RECORDED IN VOL. 17, PG. 10 OF THE L.C.M.R.) AND ALSO A PARCEL DESIGNATED AS PRIVATE PARK "A" IN THE BORDER CITIES COMPANY'S SHORE SUBDIVISION AND BUCKEYE COUNTRY CLUB (RECORDED IN VOL. 11, PG. 13 AND RESUBDIVIDED IN VOL. 22, PG. 69 OF THE L.C.M.R.), NOW IN THE CITY OF SHEFFIELD LAKE, COUNTY OF LORAIN, OHIO.

REGISTERED SURVEYOR
WILLIAM J. DEMPSEY
4492
OHIO

REGISTERED OHIO SURVEY NO. 4492

Dempsey & Associates, Inc.
Professional Land Surveyors
3657 West 117th St. 216 252-1800
CLEVELAND, OHIO 44111

DATE: JULY 13, 1976
SCALE: 1"=60'

JOB NO.

9818
300-036A