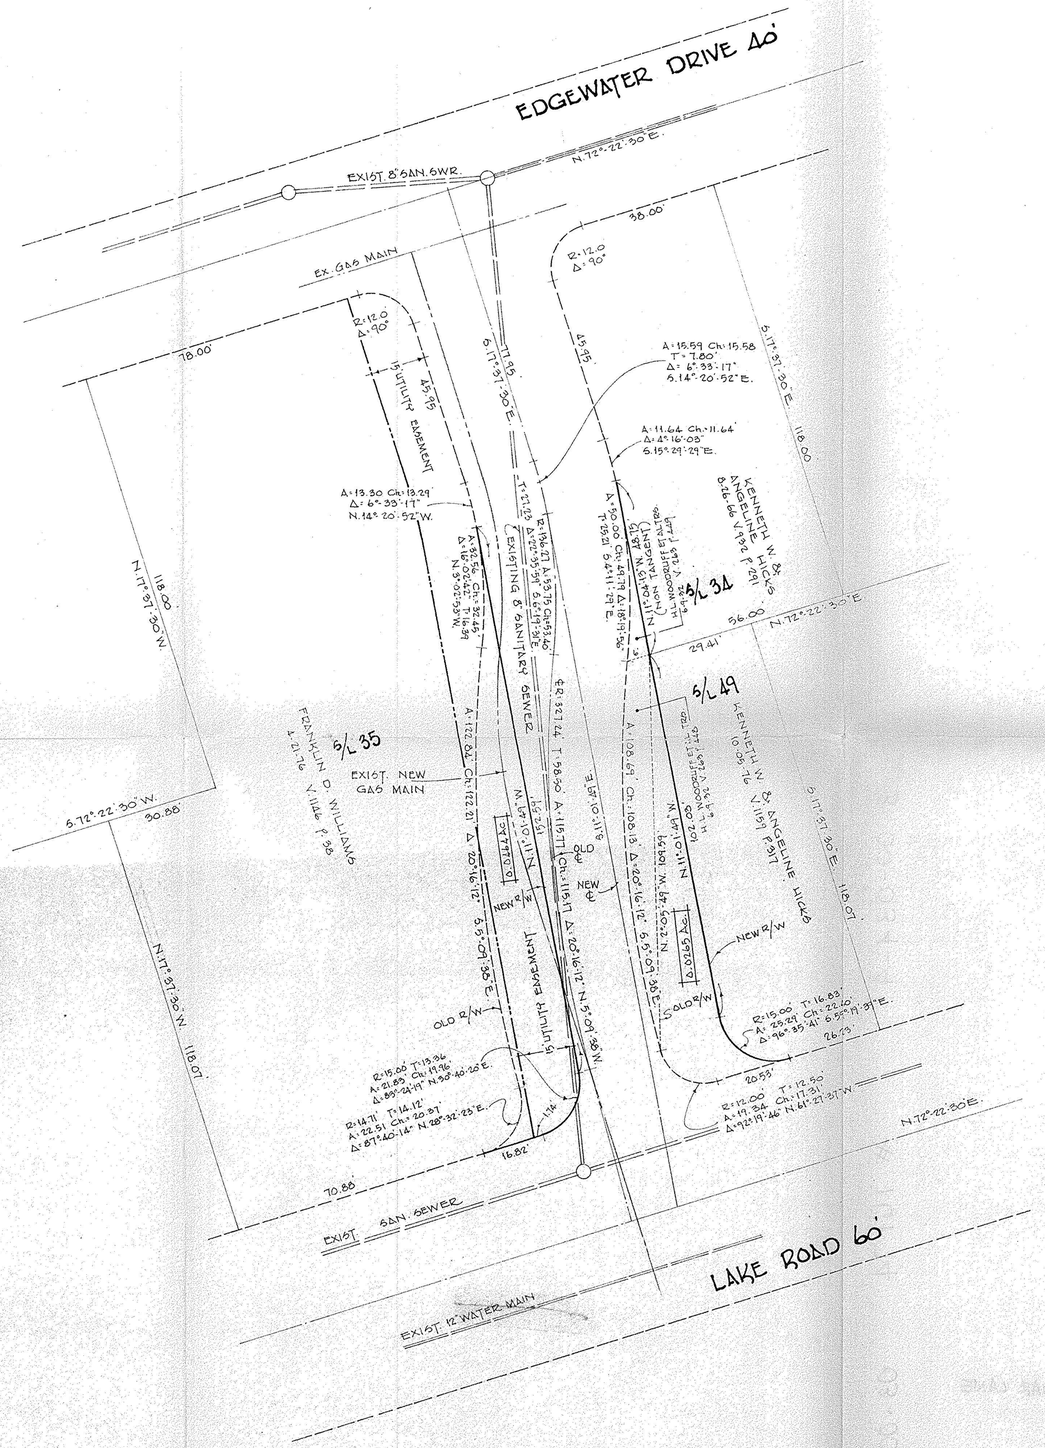

JOHN TRUBACH
(BUILDING DEPT.)
949-7141 (949-5767)

MARCIE WALTON
949-6259 (SERVICE DIRECTOR)

OLD NAME
NORTH SHEFFIELD DR.

RIGHT - OF - WAY RELOCATION

CEDAR LANE

PART OF BORDER CITIES CO'S. SHEFFIELD ON THE LAKE ALLOTMENT
PLAT VOL. 11 PG. 7

O.L. 34 SHEFFIELD TWP.
COUNTY OF LORAIN
JANUARY 21, 1985

CITY OF SHEFFIELD LAKE
STATE OF OHIO
SCALE 1"=20'

LAUNDON · SIMON · CAHL & ASSOC.
ENGINEERS SURVEYORS
JOB Nº 84-1334

#16174
APPROVED
LORAIN CO.
MAP DEPT.
DATE 5-10-85
PAGE 3.00.034.A
BY T. McMain
VOL. 1

REVISED AND RE-DRAWN JAN. 21, '85 & SUPERSEDES PREVIOUS DWG. DATED NOV. 5, '84