



3-00-024-A

*17735

03-00-024-000

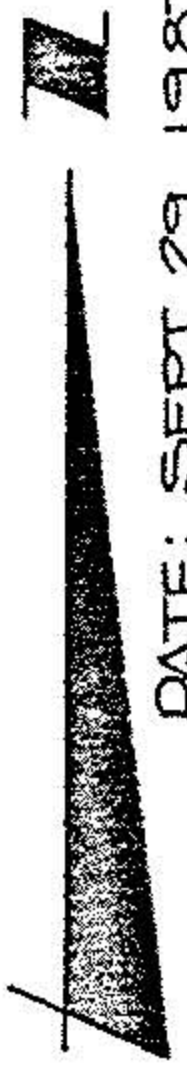


DATE: SEPT 29, 1987
SCALE: 1"=100'

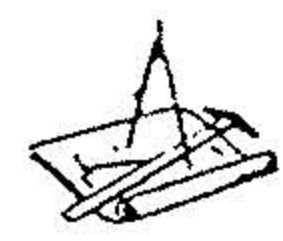


HAPONEK & ASSOCIATES, INC

Engineers & Surveyors
34100 Center Ridge Road
NORTH RIDGEVILLE, OHIO 44039
(216) 327-4776

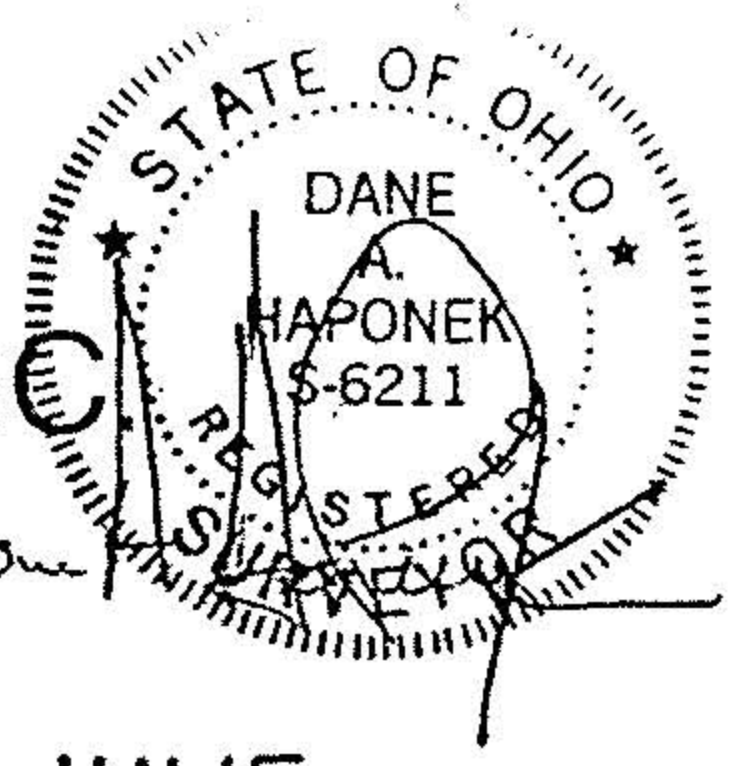

PREPARED FOR
WALTER AND JUNE RAUSCHER
959 HARRIS RD.
SHEFFIELD VILLAGE, O.

HARRIS RD. 60'

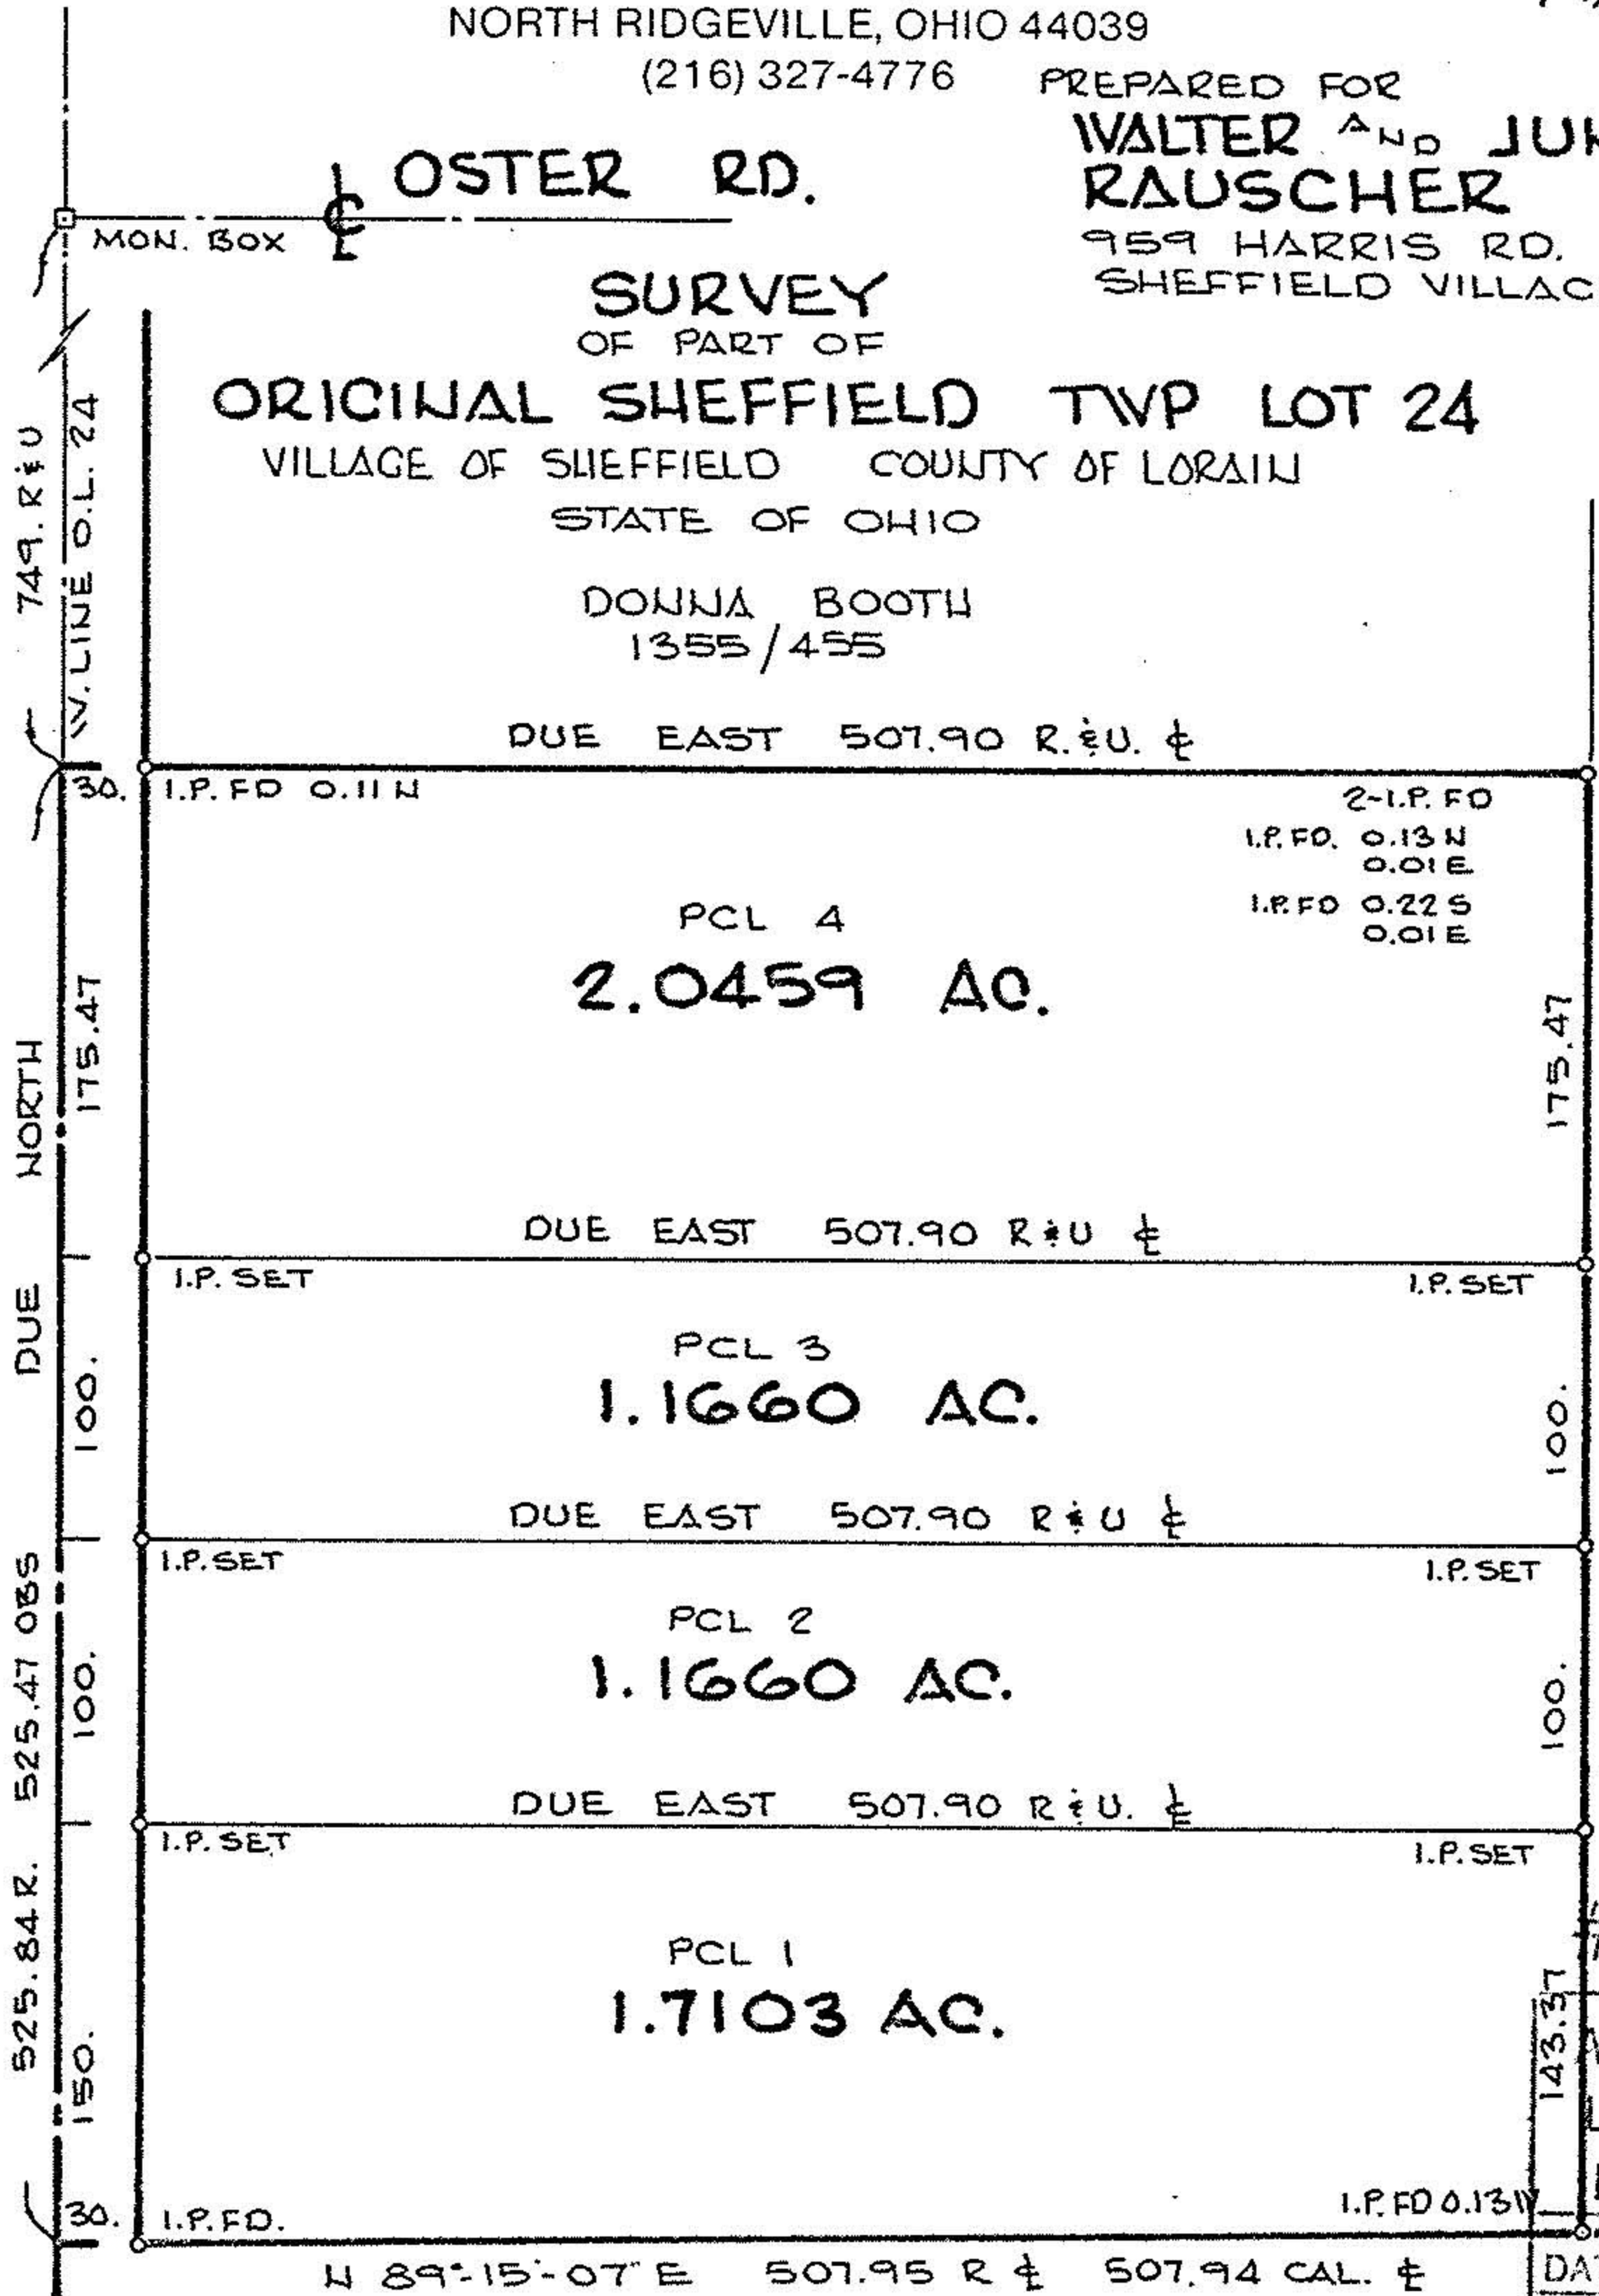

NORFOLK AND WESTERN RAILWAY CO.

GILBERTE A. & JOHN P SHAW
1340/919

#17735

APPROVED
LORAIN CO.
MAP DEPT.
DATE 10-26-87
PAGE 3-00-024-A
BY Carolyn Francis
VOID AFTER 17735