SURVEY FOR:
H. A. KEYSE GREENHOUSE CO. INC.
O.L. 70 & 51 COLUMBIA TOWNSHIP
LORAIN COUNTY
SCALE 1" = 100' JUNE 8, 1977
LAUNDON · SIMON · CLUL
ENGINEERS SURVEYORS
JOB # 77-618 R.S. 125/875

TOTAL ACREAGE 60.0819 Ac.
O.L. 70 22.88 Ac.
O.L. 51 37.20 Ac.
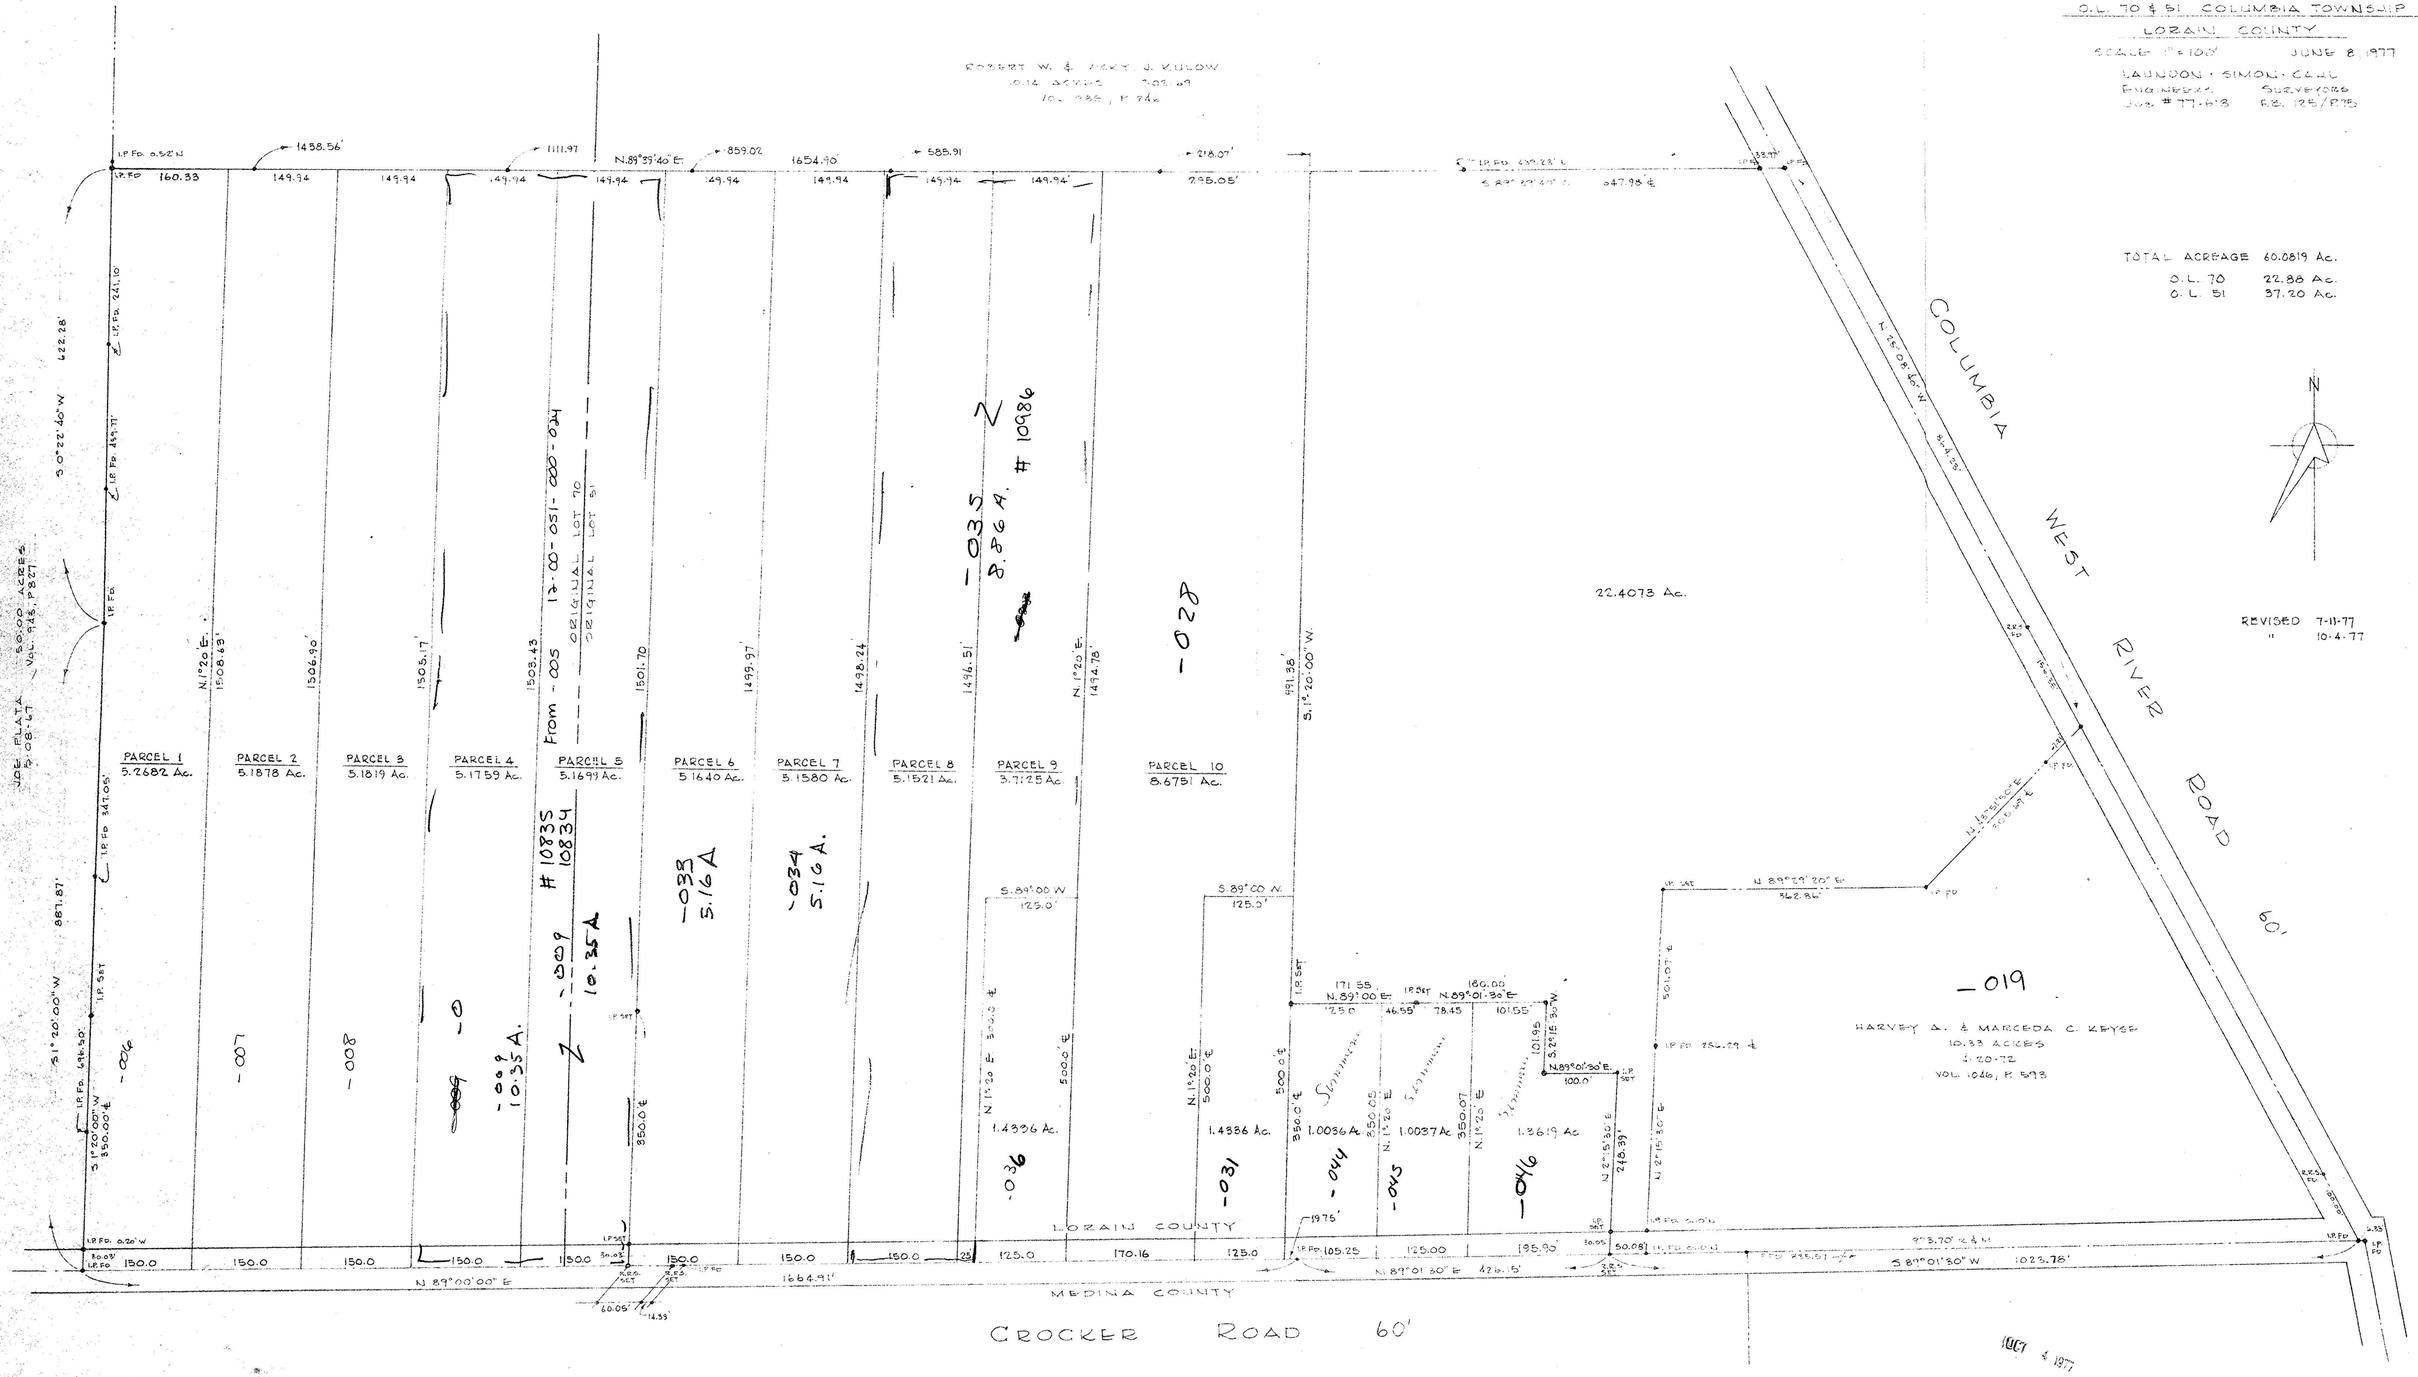
REVISED 7-11-77
" 10-4-77