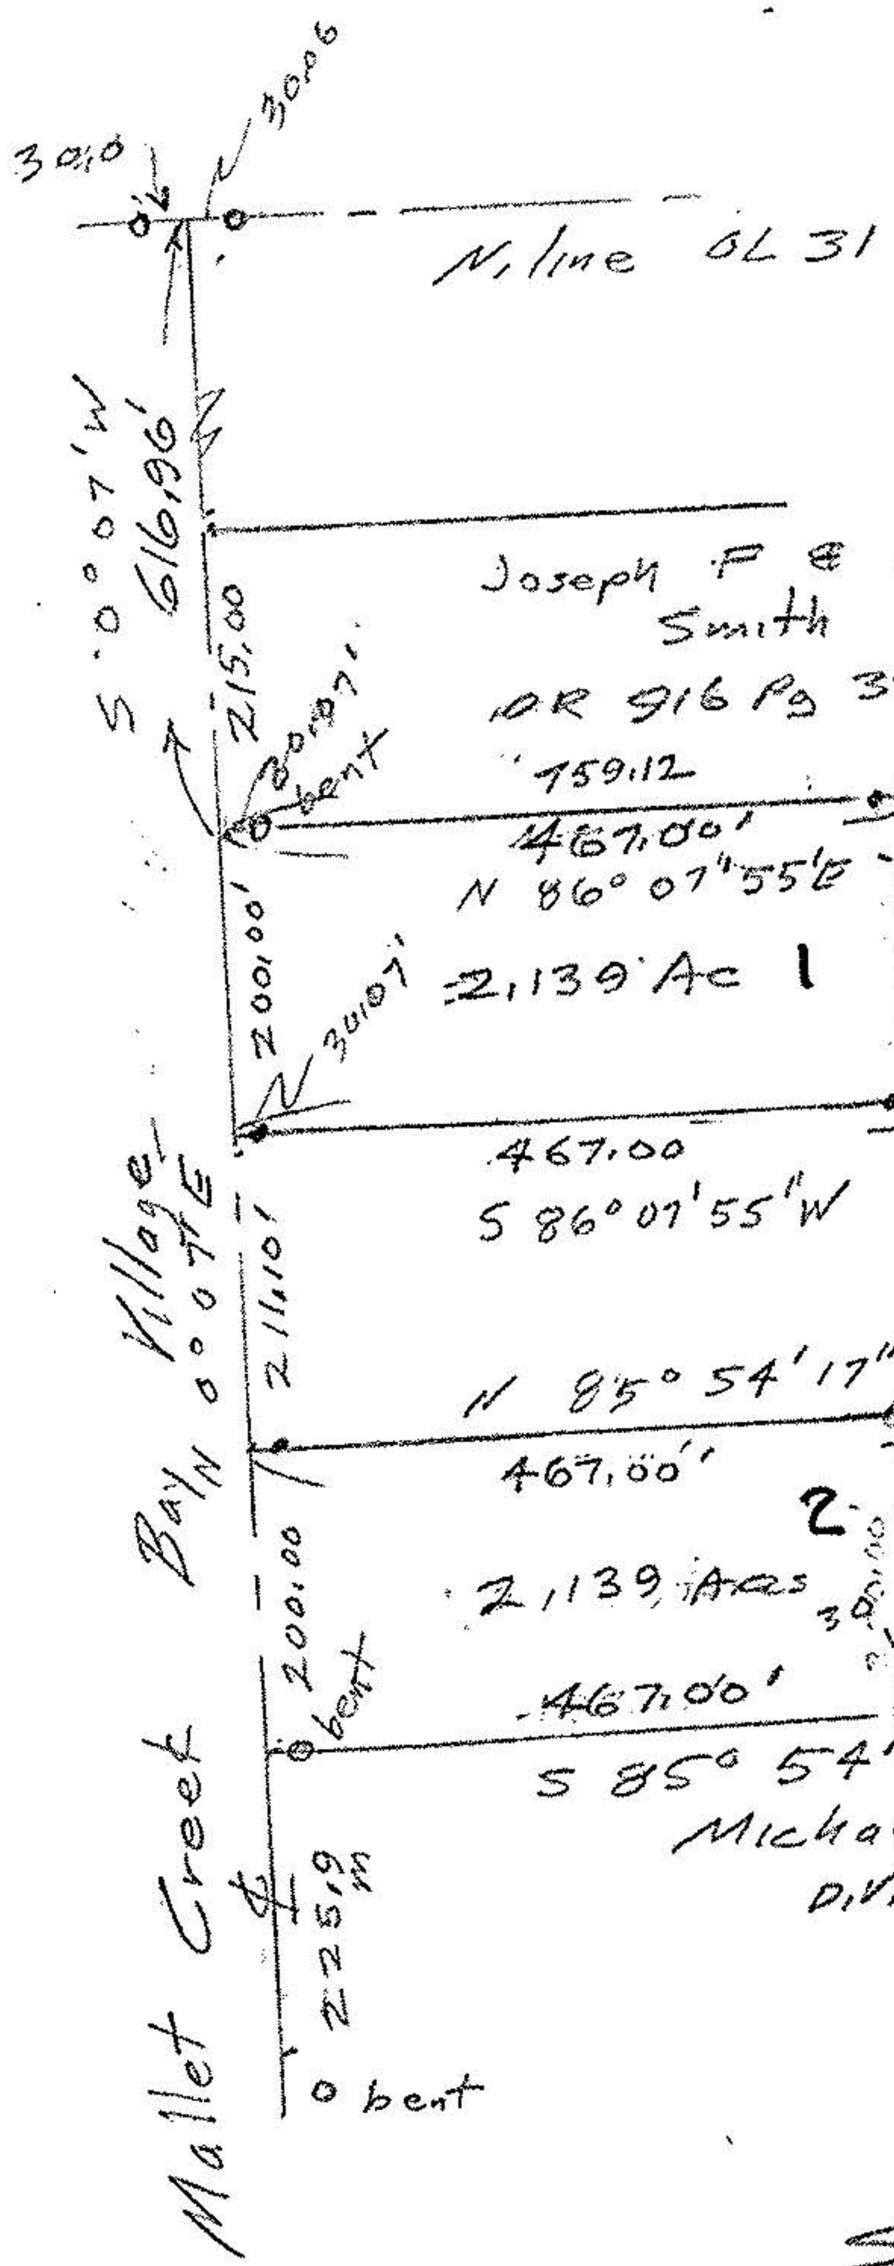

o iron pipes fd
● iron pins set

STATE OF OHIO
JOHN POZYWAK
5292
REGISTERED SURVEYOR

Survey of two parcel splits
Original Lot 31, Columbia Township
Lorain County, Ohio
Scale 1" = 200' June 1996

John Pozywak
Reg Surveyor 5292

Scott Schulke

21861
APPROVED
LORAIN CO.
M.A. DEPT.
DATE 7-29-96
PAGE 12-G
BY K. DYE
VOID AFTER #21861