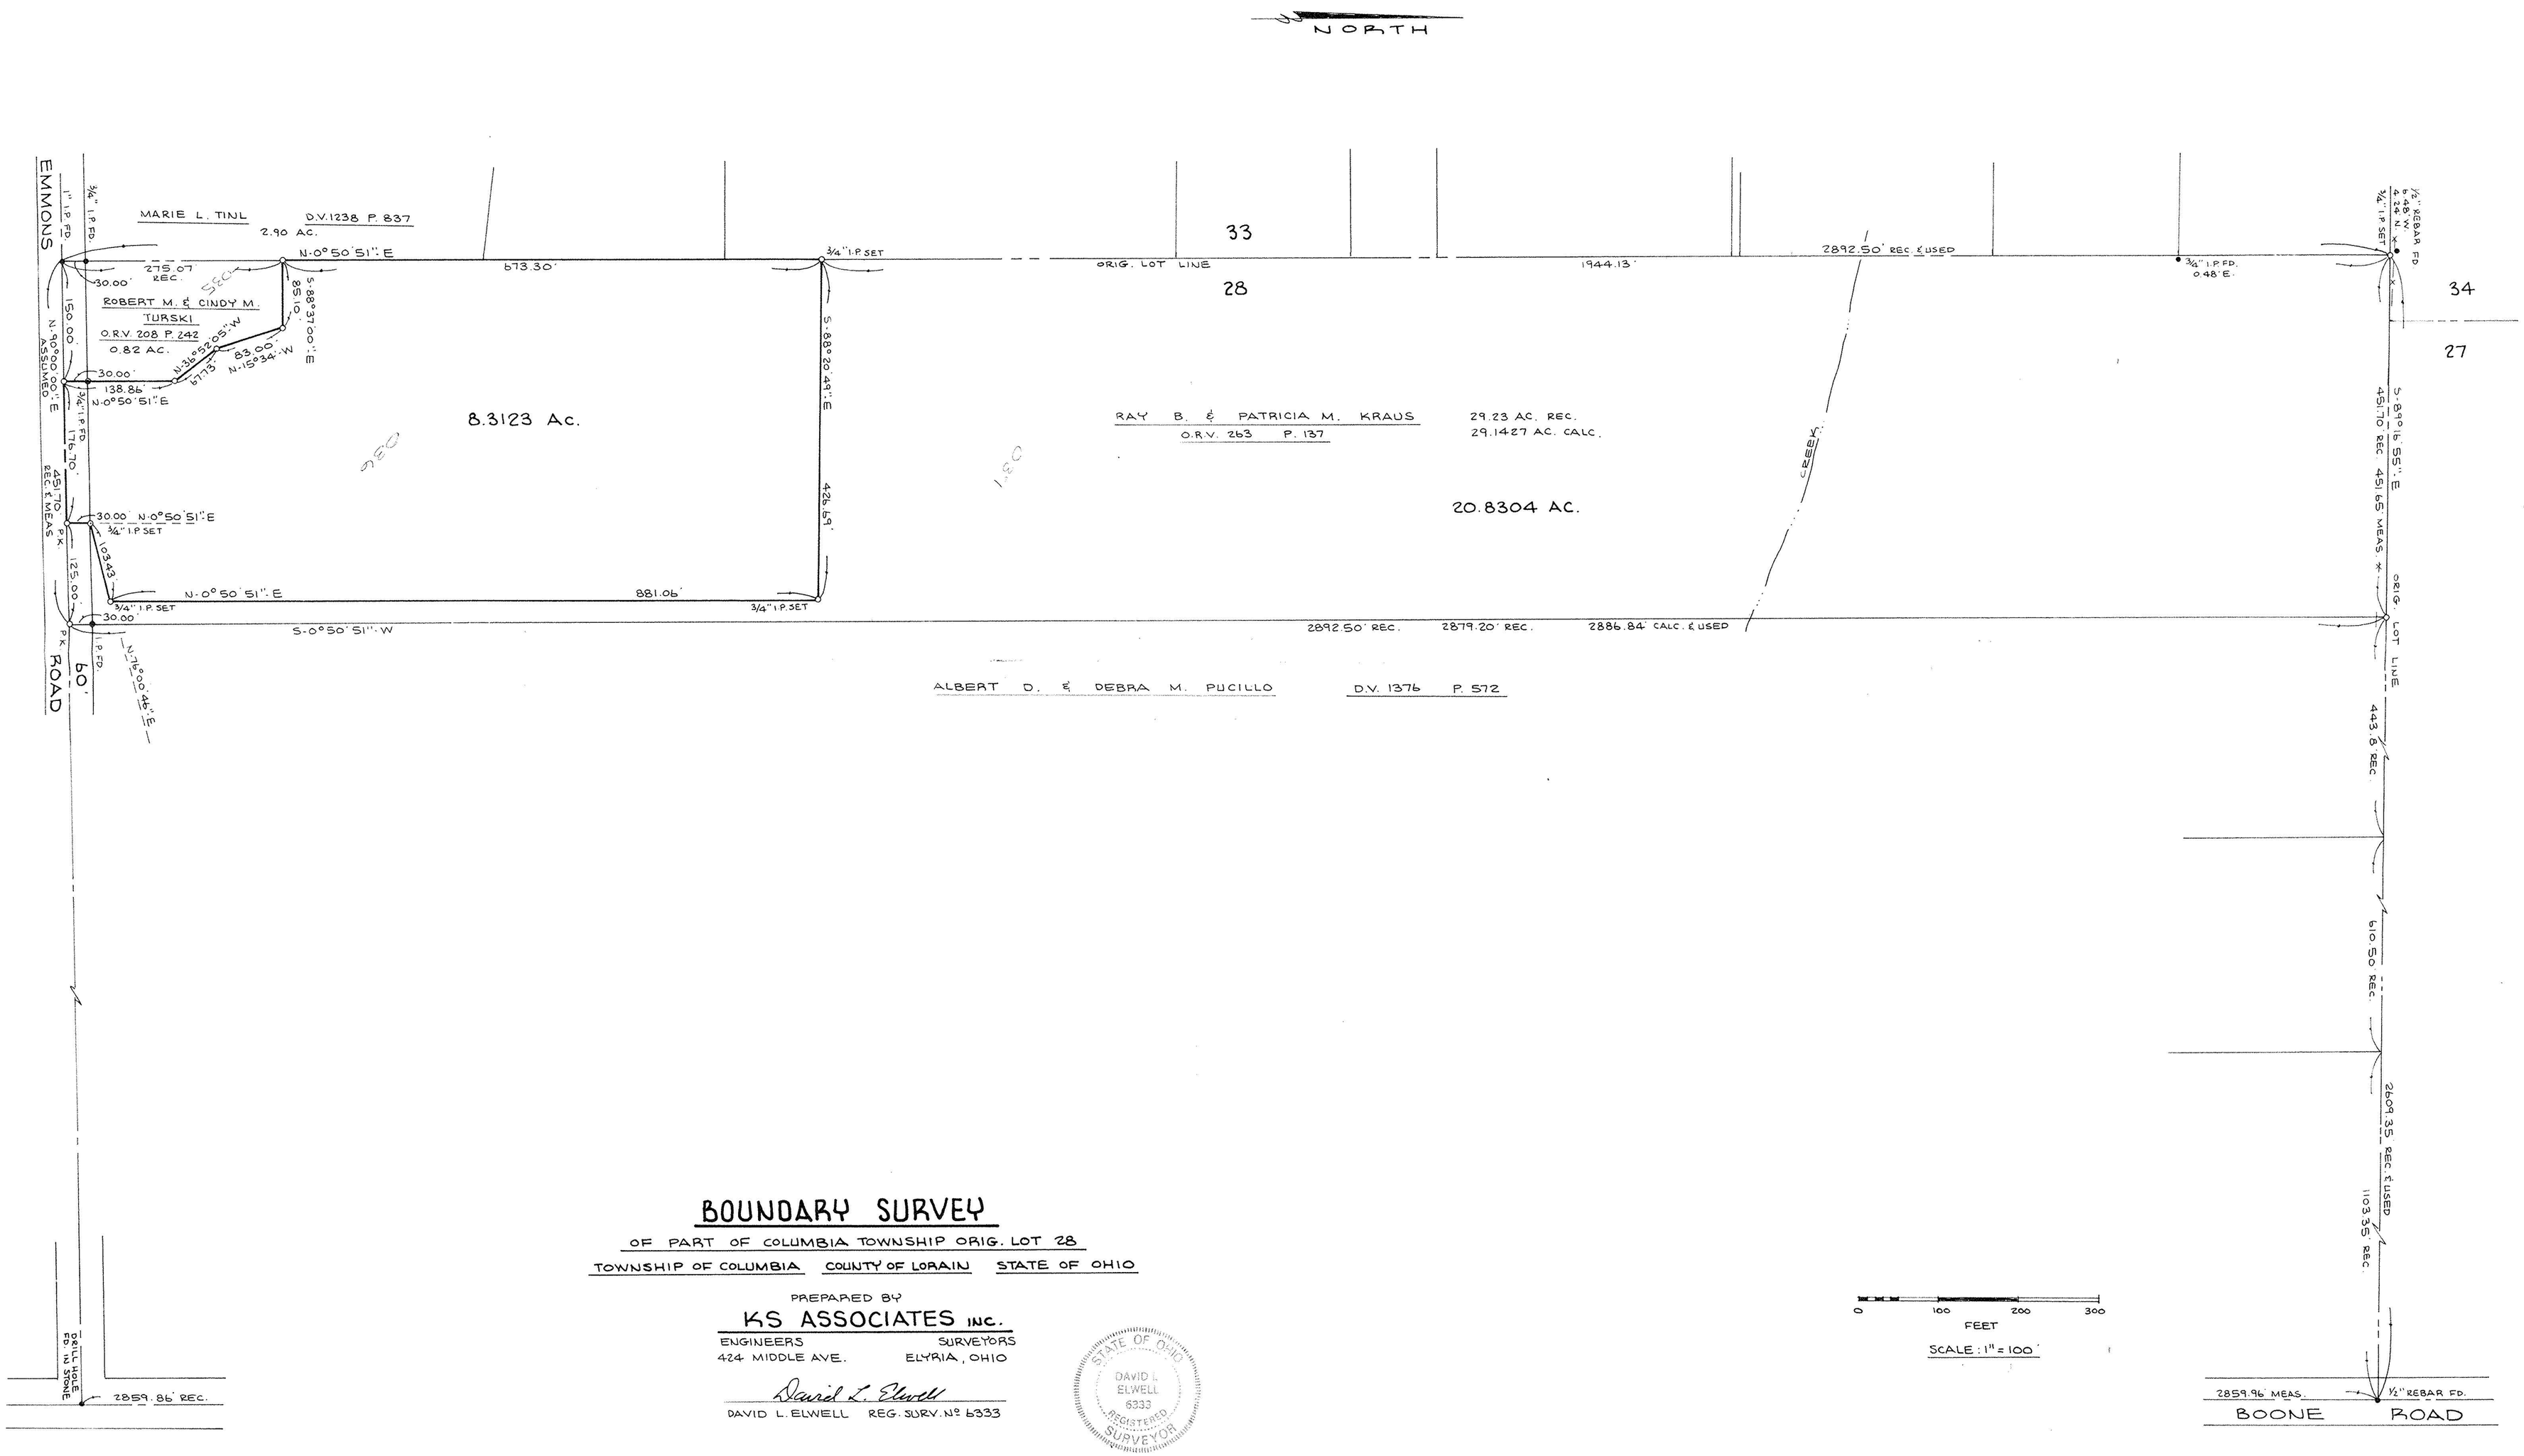

BOUNDARY SURVEY

OF PART OF COLUMBIA TOWNSHIP ORIG. LOT 28

TOWNSHIP OF COLUMBIA COUNTY OF LORAIN STATE OF OHIO

PREPARED BY

KS ASSOCIATES INC.

ENGINEERS SURVEYORS

424 MIDDLE AVE. ELYRIA, OHIO

David L. Elwell

DAVID L. ELWELL REG. SURV. Nº 6333

STATE OF OHIO DAVID L. ELWELL 6333 REGISTERED SURVEYOR

91-199