


12-00-022-000
-023
038
039

CONC.
R/W MARKER
FO. 233+70.6

19838

12-00-022-A, -023-A)
-038-B -039-B

E MALLETT CREEK - BAY VILLAGE RD. (S.R. 252)
N 7°57'55" E 174.61' 65.34' 197.78'

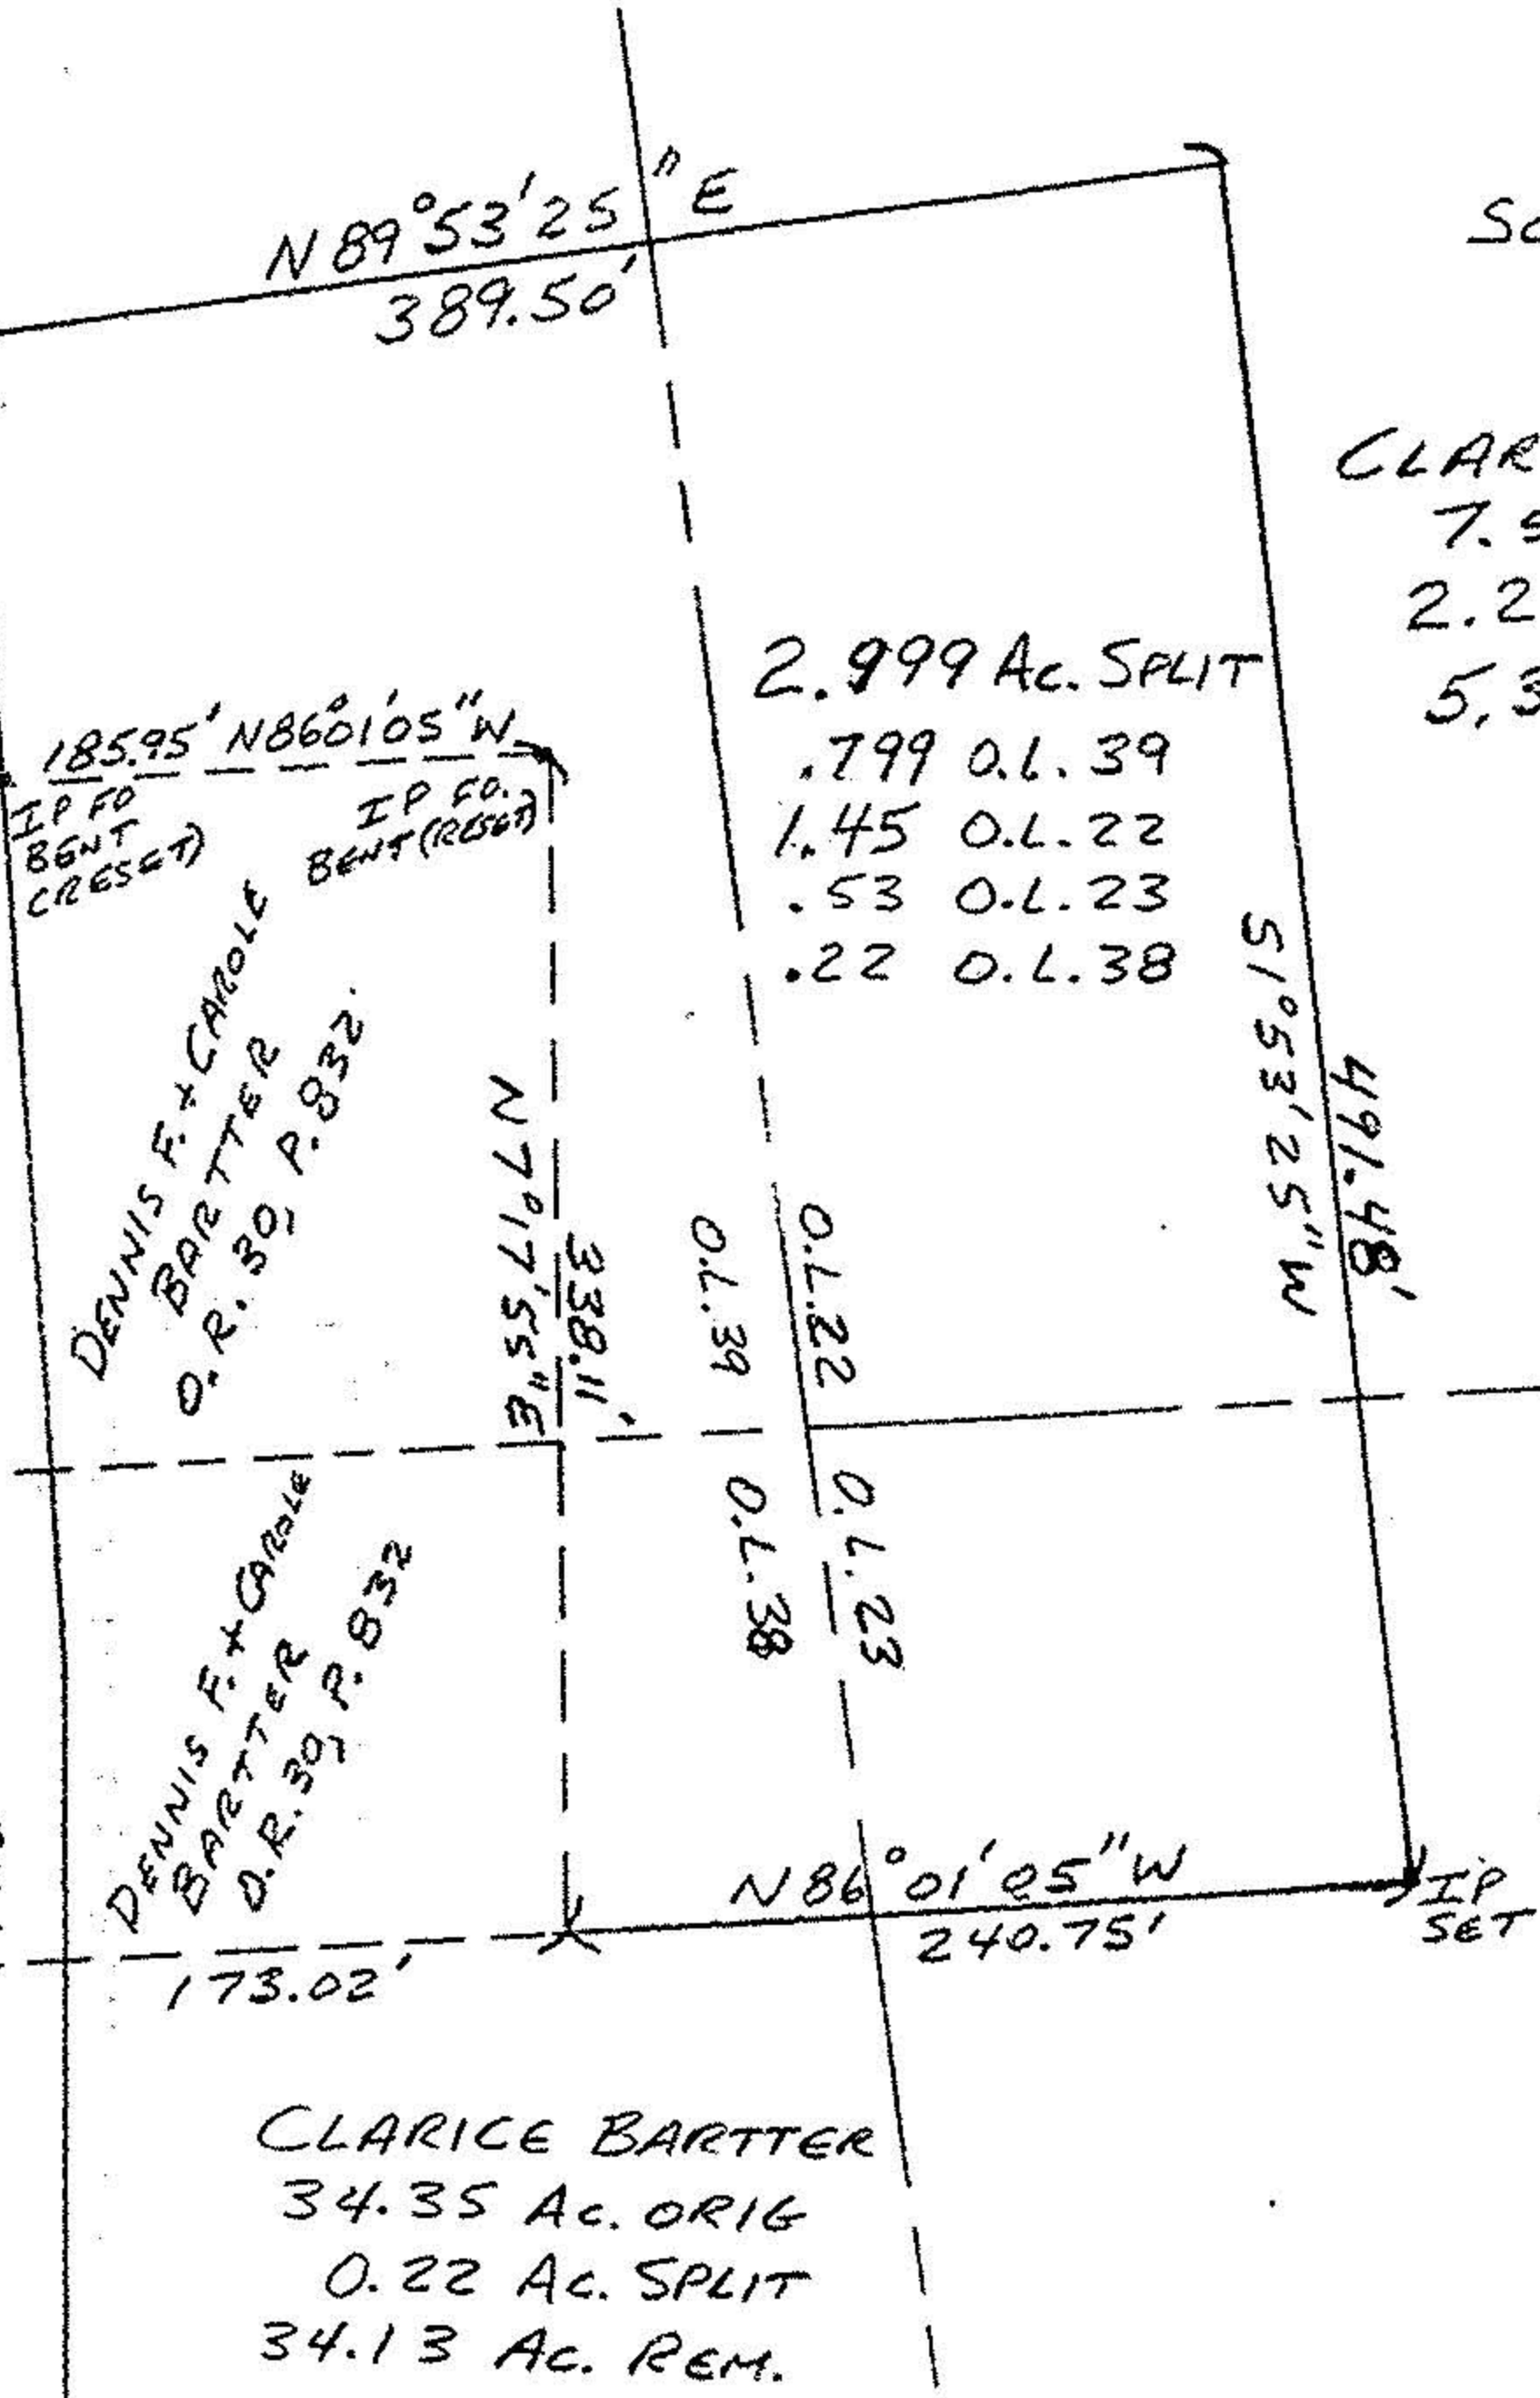

NORTH
SCALE 1"=100'

CLARICE BARTTER
7.57 Ac. ORIG.
2.249 Ac. SPLIT
5.321 Ac. REM.


19838

APPROVED
LORAIN CO.
MAP DEPT.

DATE 4-1-92
12-00-022-A 023-A
PAGE 038-B 039-B
BY CAROLYN FRANCIS
VOID AFTER # 19838

CLARICE BARTTER
67.67 Ac. ORIG
0.53 Ac. SPLIT
67.14 Ac. REM.

CLARICE BARTTER
34.35 Ac. ORIG
0.22 Ac. SPLIT
34.13 Ac. REM.

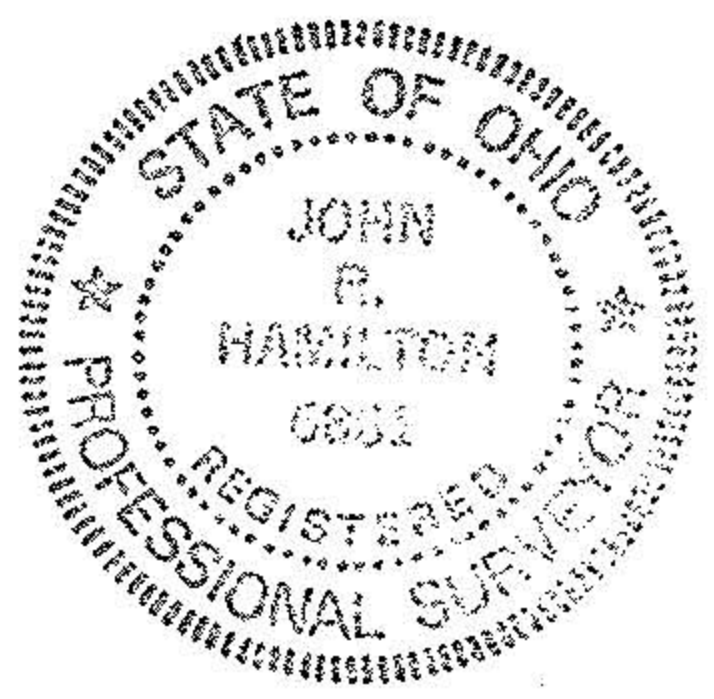

SURVEY OF 2.999 AC. SPLIT
FOR DENNIS BARTTER
O.L. 22, 23, 38, 39 - COLUMBIATWP
SCALE 1"=100'
JOHN R. HAMILTON
REG. SURV. #6861 REV. 1/1/92