PART OF COLUMBIA TWP. ORIGINAL LOT NO. 23
TOWNSHIP OF COLUMBIA, COUNTY OF LORAIN
STATE OF OHIO

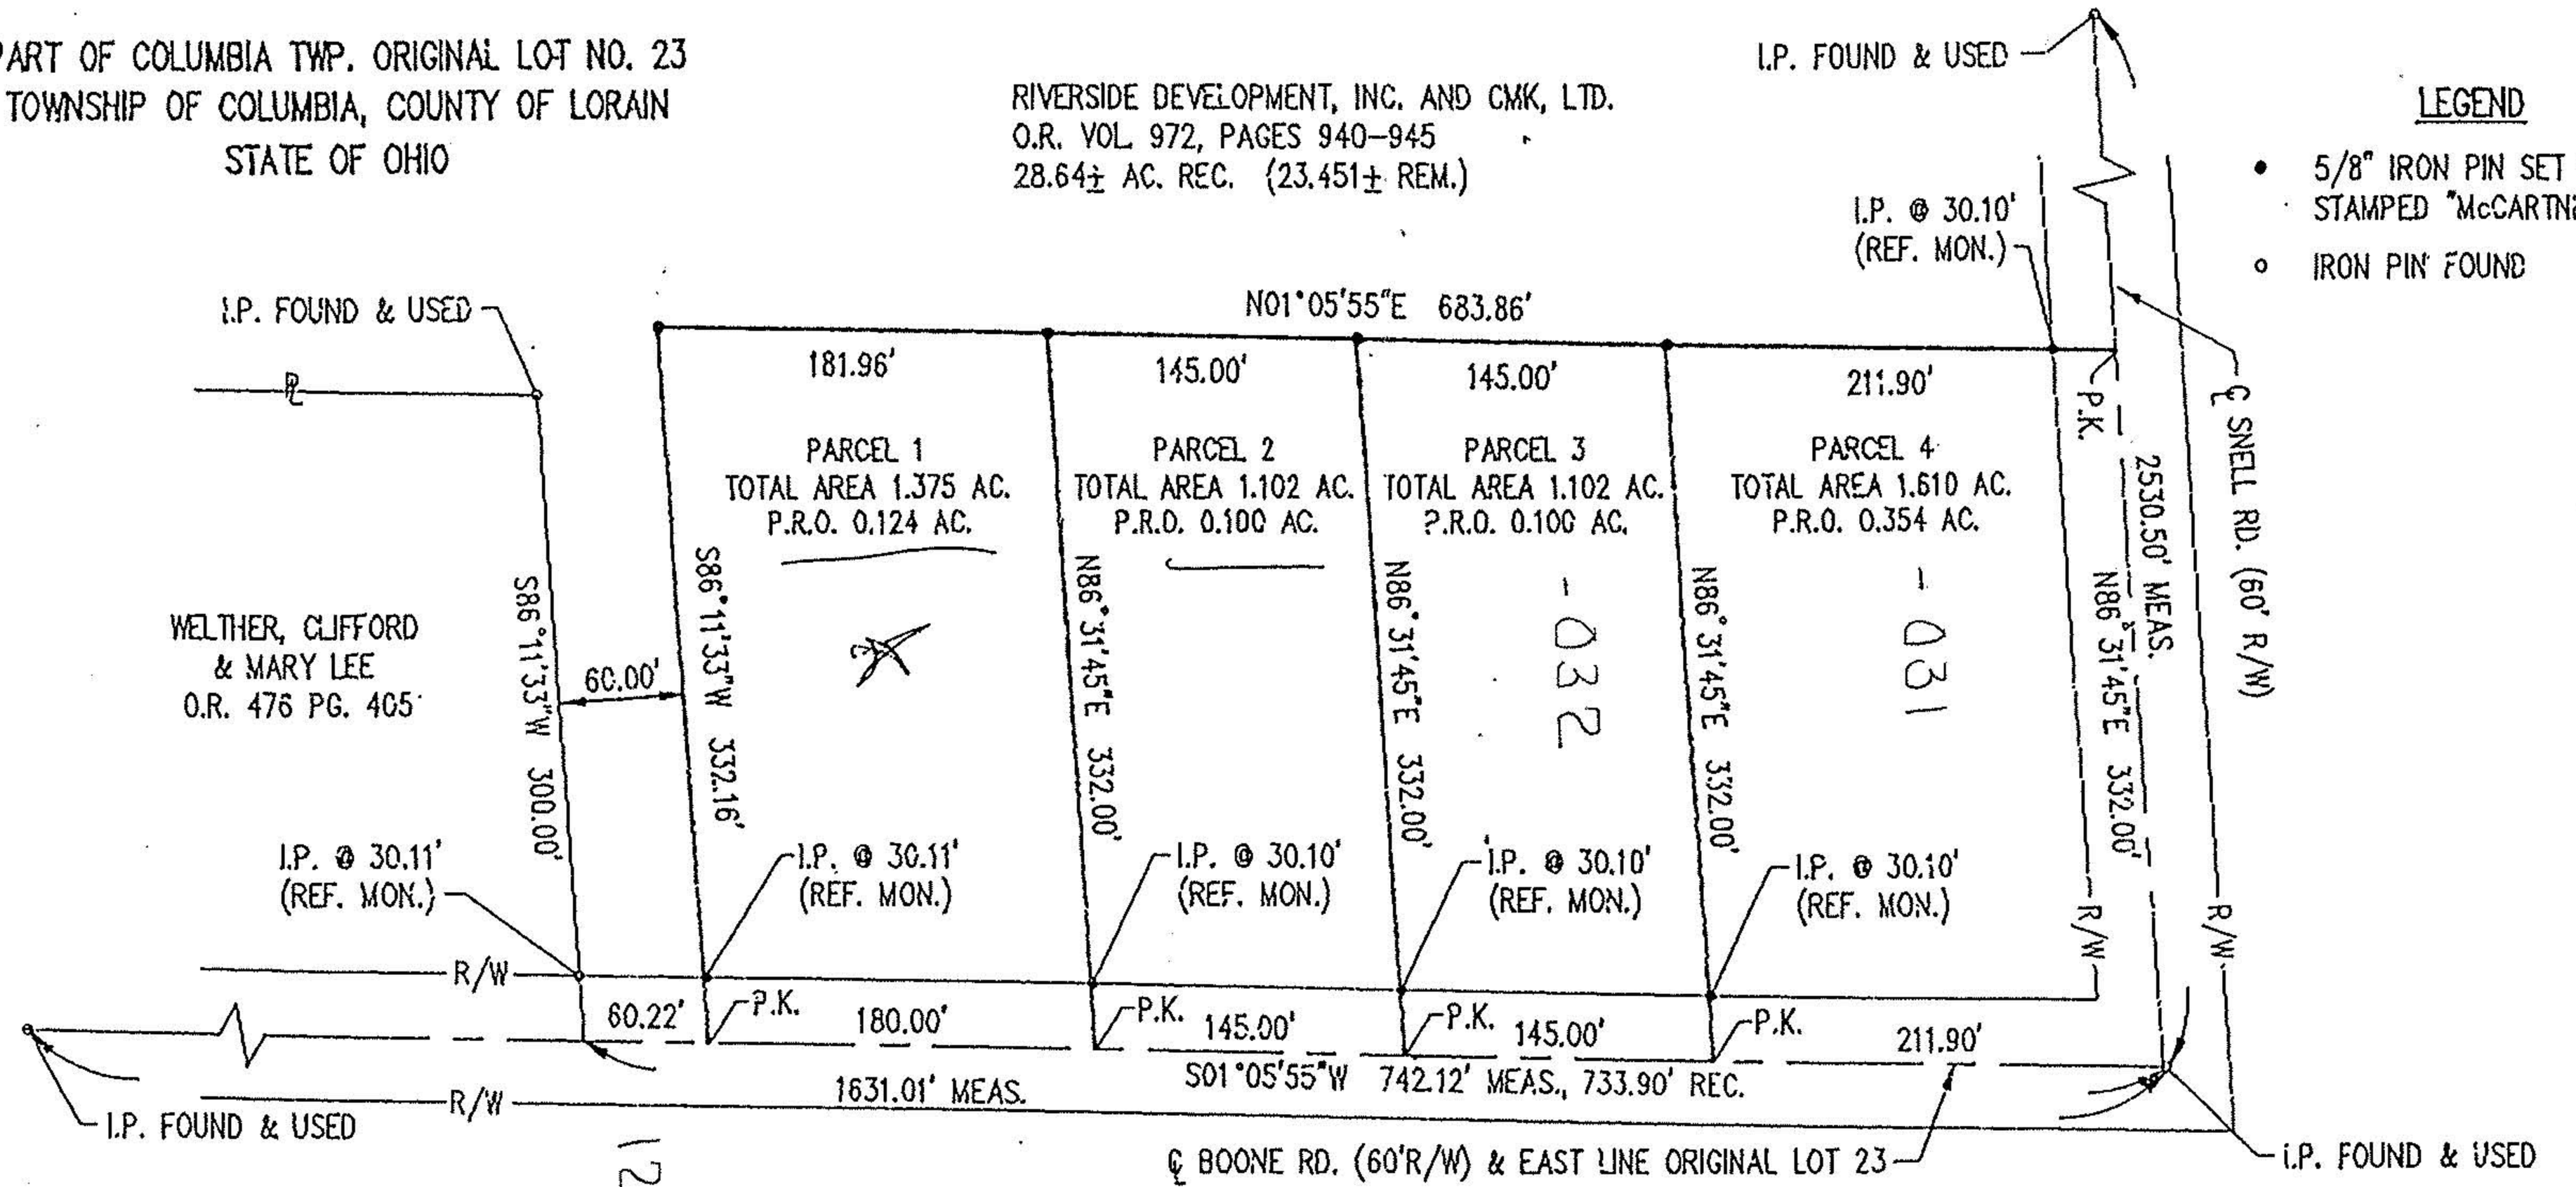

LEGEND

- • 5/8" IRON PIN SET WITH CAP STAMPED "McCARTNEY & ASSOC."
- ∘ IRON PIN FOUND

12-00-023-000-

SCALE IN FEET

0' 50' 100' 200'

NOTE:

BEARINGS SHOWN HEREON ARE TO AN ASSUMED MERIDIAN AND ARE USED TO DENOTE ANGLES ONLY.

21578
APPROVED
LORAIN CO.
MAP DEPT
DATE 12-1-95
PAGE 12-00-023-B
BY CAROLYN FRANCIS
#21578

STATE OF OHIO
JAMES B. ROBERTS
004279
REGISTERED
PROFESSIONAL SURVEYOR

SURVEY BY:
K.E. McCARTNEY & ASSOCIATES, INC.
CONSULTING ENGINEERS & SURVEYORS
LORAIN & RICHLAND COUNTIES, OHIO

JAMES B. ROBERTS,
OHIO REGISTERED SURVEYOR NO. 4279
JUNE, 1995