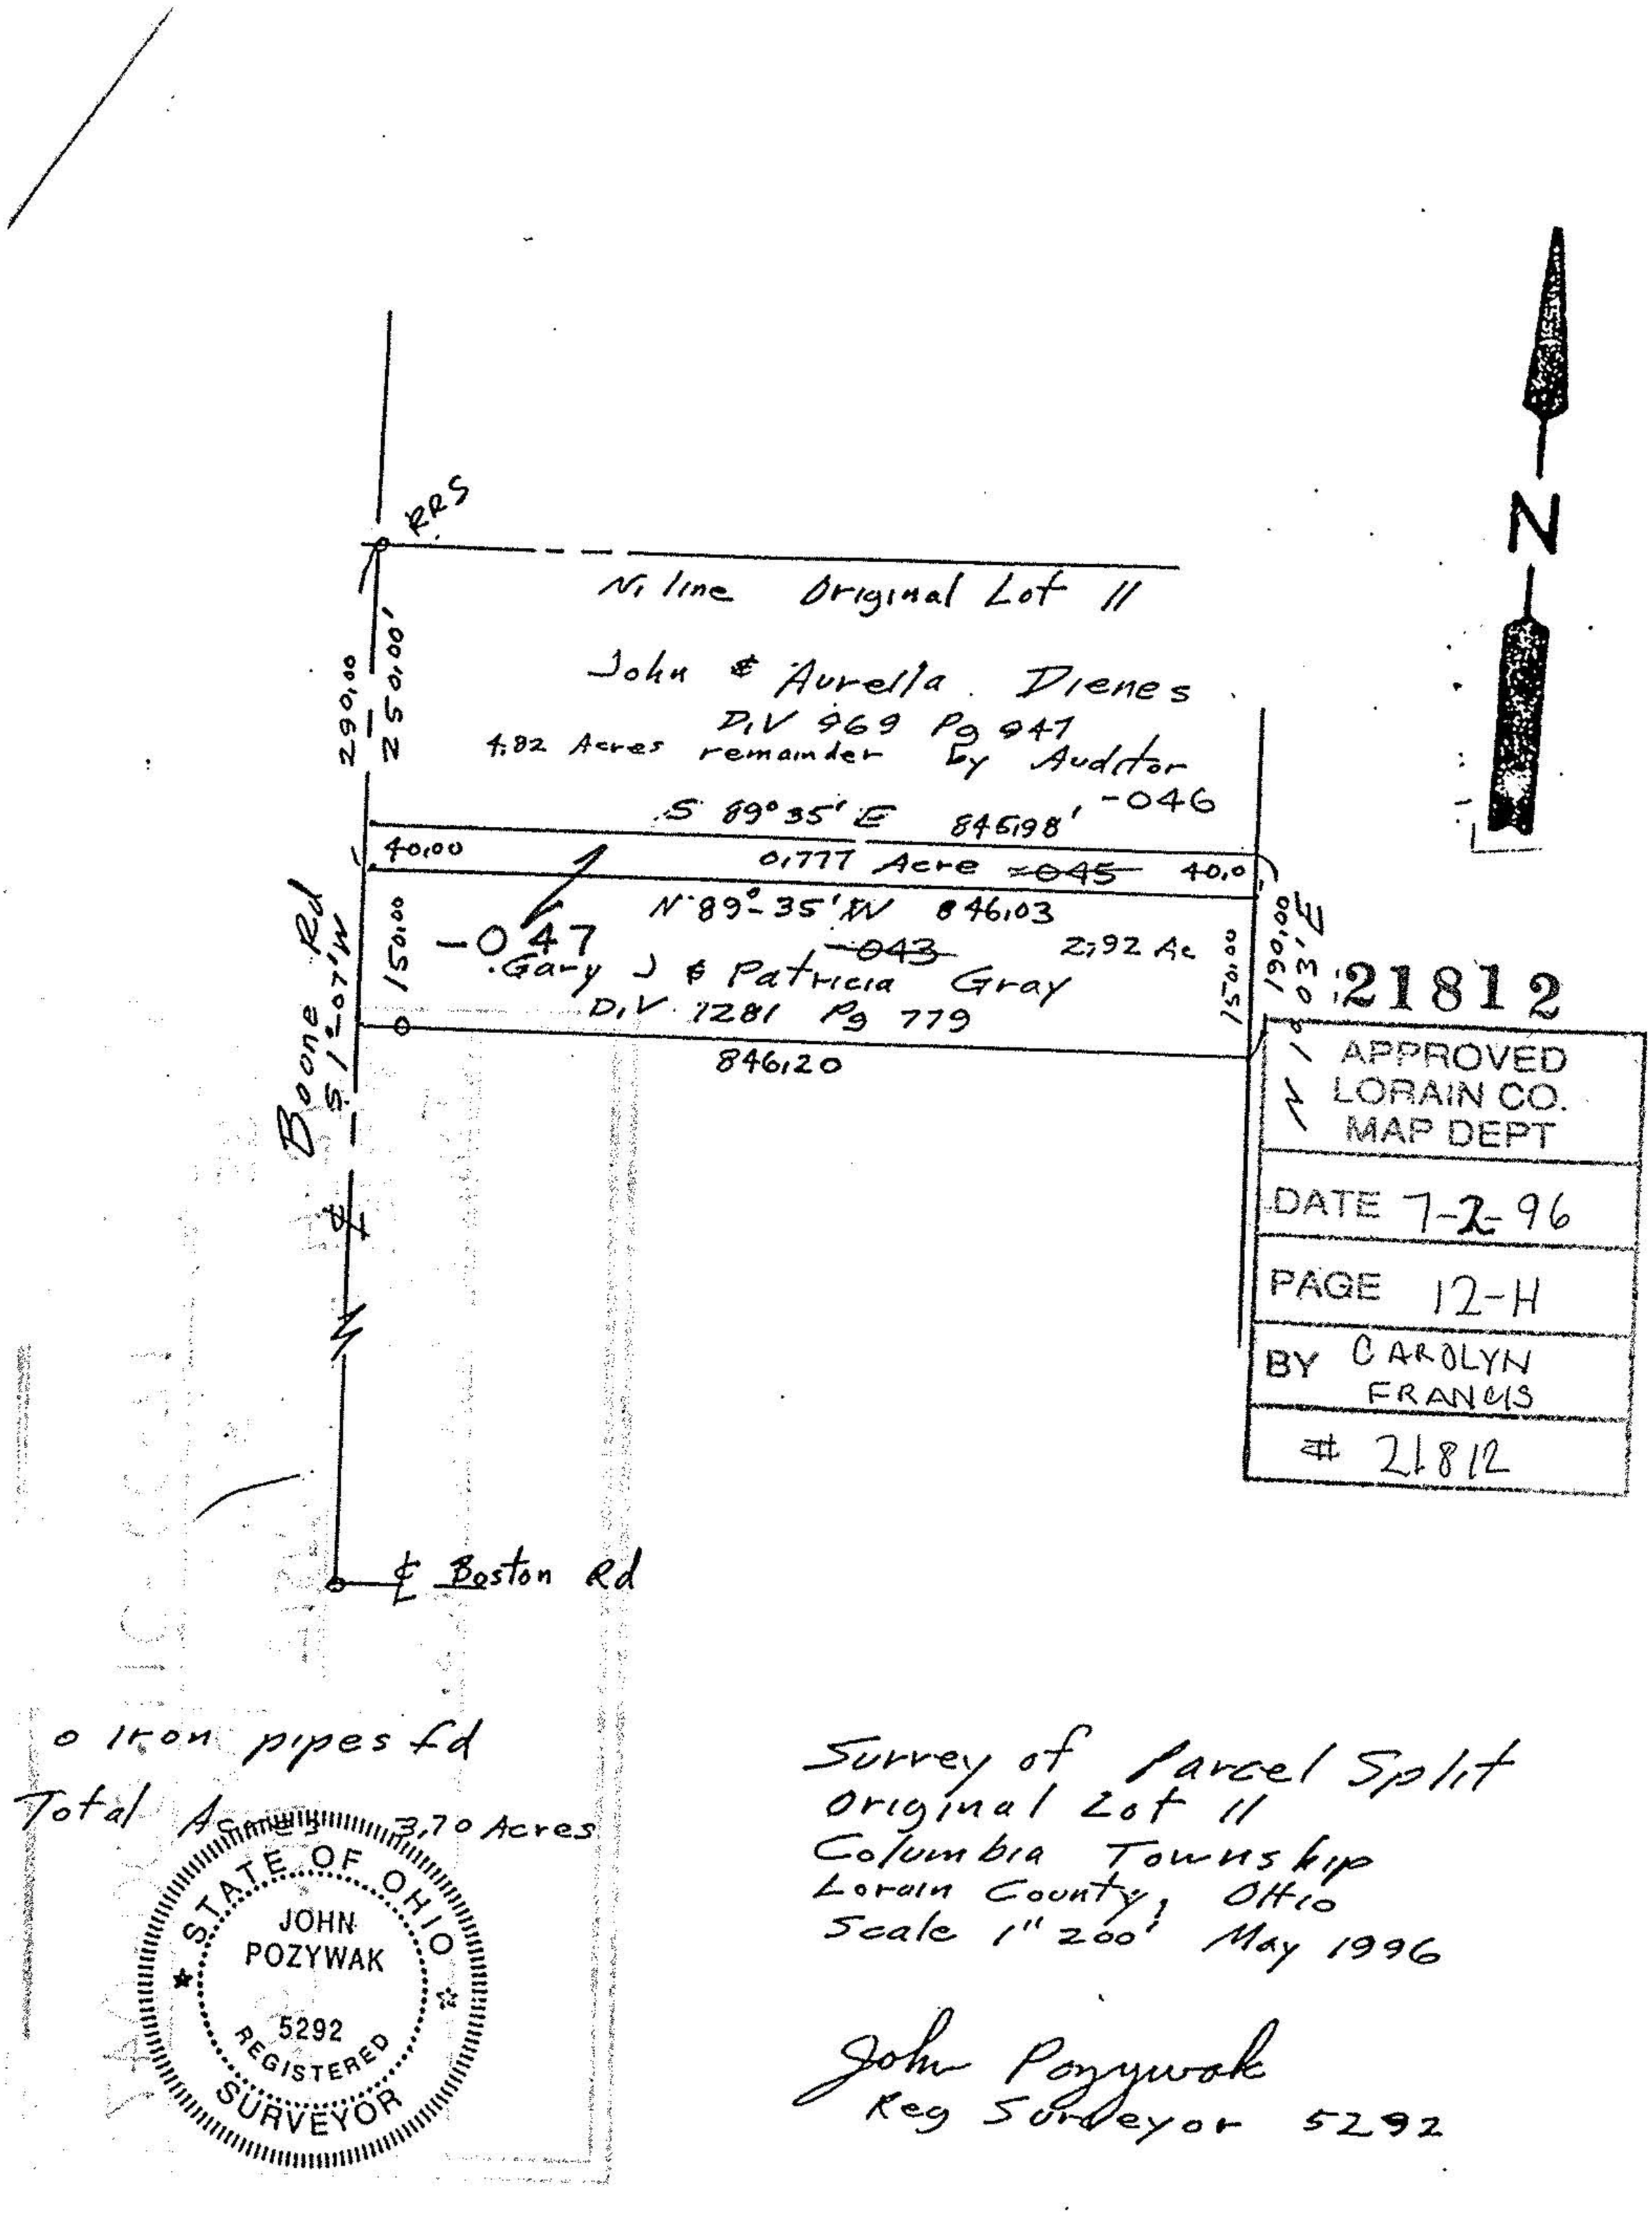

21812

APPROVED
LORAIN CO.
MAP DEPT

DATE 7-2-96

PAGE 12-H

BY CAROLYN FRANCIS

21812

o iron pipes fd

Total Acreage 3.70 Acres

STATE OF OHIO
JOHN POZYWAK
5292
REGISTERED
SURVEYOR

Survey of Parcel Split
Original Lot 11
Columbia Township
Lorain County, Ohio
Scale 1" 200' May 1996

John Pozywak
Reg Surveyor 5292