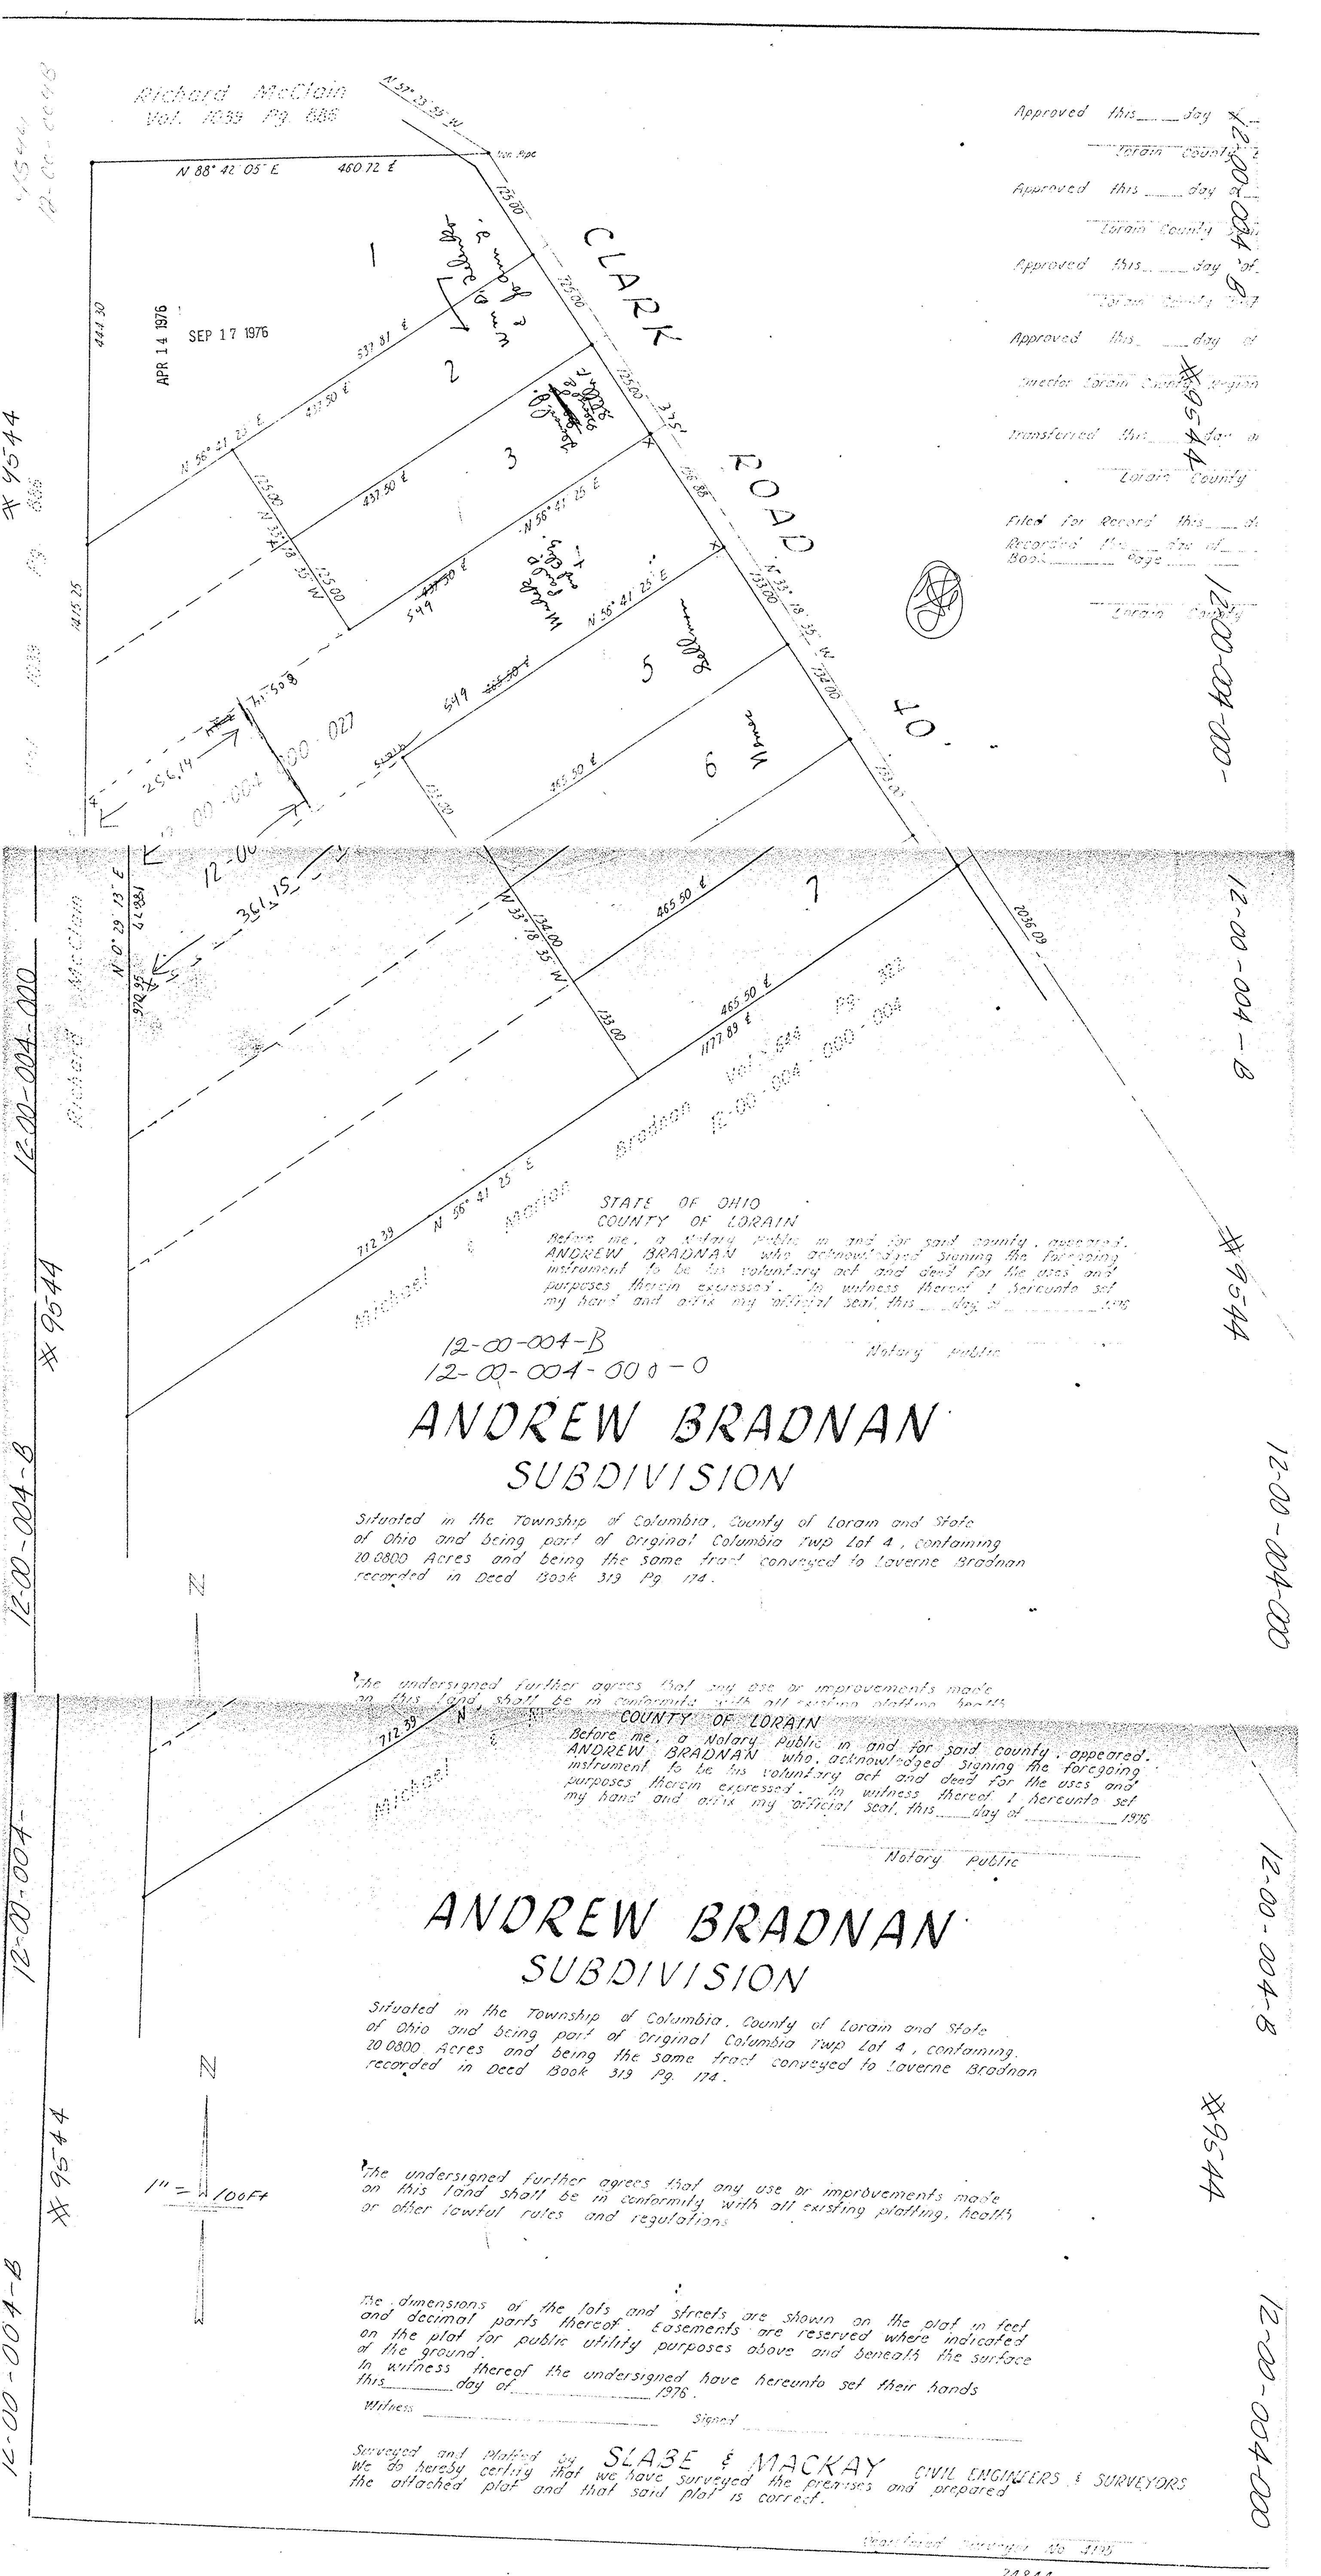
Richard McClain
Vol. 1039 Pg 886
N 88° 42' 05" E
460.72 E
CLARK ROAD
APR 14 1976
SEP 17 1976
Approved this ___ day of
Lorain County
Approved this ___ day of
Lorain County
Approved this ___ day of
Lorain County
Approved this ___ day of
Director Lorain County Regional
Transferred this ___ day of
Lorain County
Filed for Record this ___ day of
Recorded in Book ___ Page ___
Lorain County
#95444
12-00-004-00
12-00-004-B
12-00-004-000
Richard McClain
Michael & Marion Bradnan Vol. 648 Pg. 352
12-00-004-000-004
STATE OF OHIO
COUNTY OF LORAIN
Before me, a Notary public in and for said county, appeared ANDREW BRADNAN who acknowledged signing the foregoing instrument to be his voluntary act and deed for the uses and purposes therein expressed. In witness thereof I hereunto set my hand and affix my official seal, this ___ day of ___ 1976
Notary public
12-00-004-B
12-00-004-000-0
ANDREW BRADNAN
SUBDIVISION
Situated in the Township of Columbia, County of Loram and State of Ohio and being part of Original Columbia Twp Lot 4, containing 20.0800 Acres and being the same tract conveyed to Laverne Bradnan recorded in Deed Book 319 Pg. 174.
N
1" = 100Ft
The undersigned further agrees that any use or improvements made on this land shall be in conformity with all existing platting, health or other lawful rules and regulations.
The dimensions of the lots and streets are shown on the plat in feet and decimal parts thereof. Easements are reserved where indicated on the plat for public utility purposes above and beneath the surface of the ground.
In witness thereof the undersigned have hereunto set their hands this ___ day of ___ 1976.
Witness ___ Signed ___
Surveyed and Platted by SLASE & MACKAY CIVIL ENGINEERS & SURVEYORS
We do hereby certify that we have surveyed the premises and prepared the attached plat and that said plat is correct.