03-00-042

SURVEY OF SL 721, A WESTERLY PORTION OF SL 722 OF THE LAKE BREEZE ALLT. VOL. 10 PG. 21 AND A PARCEL WEST OF LAKE BREEZE ALLT.

TOTAL AREA OF PARCEL = 0.426 ACRES

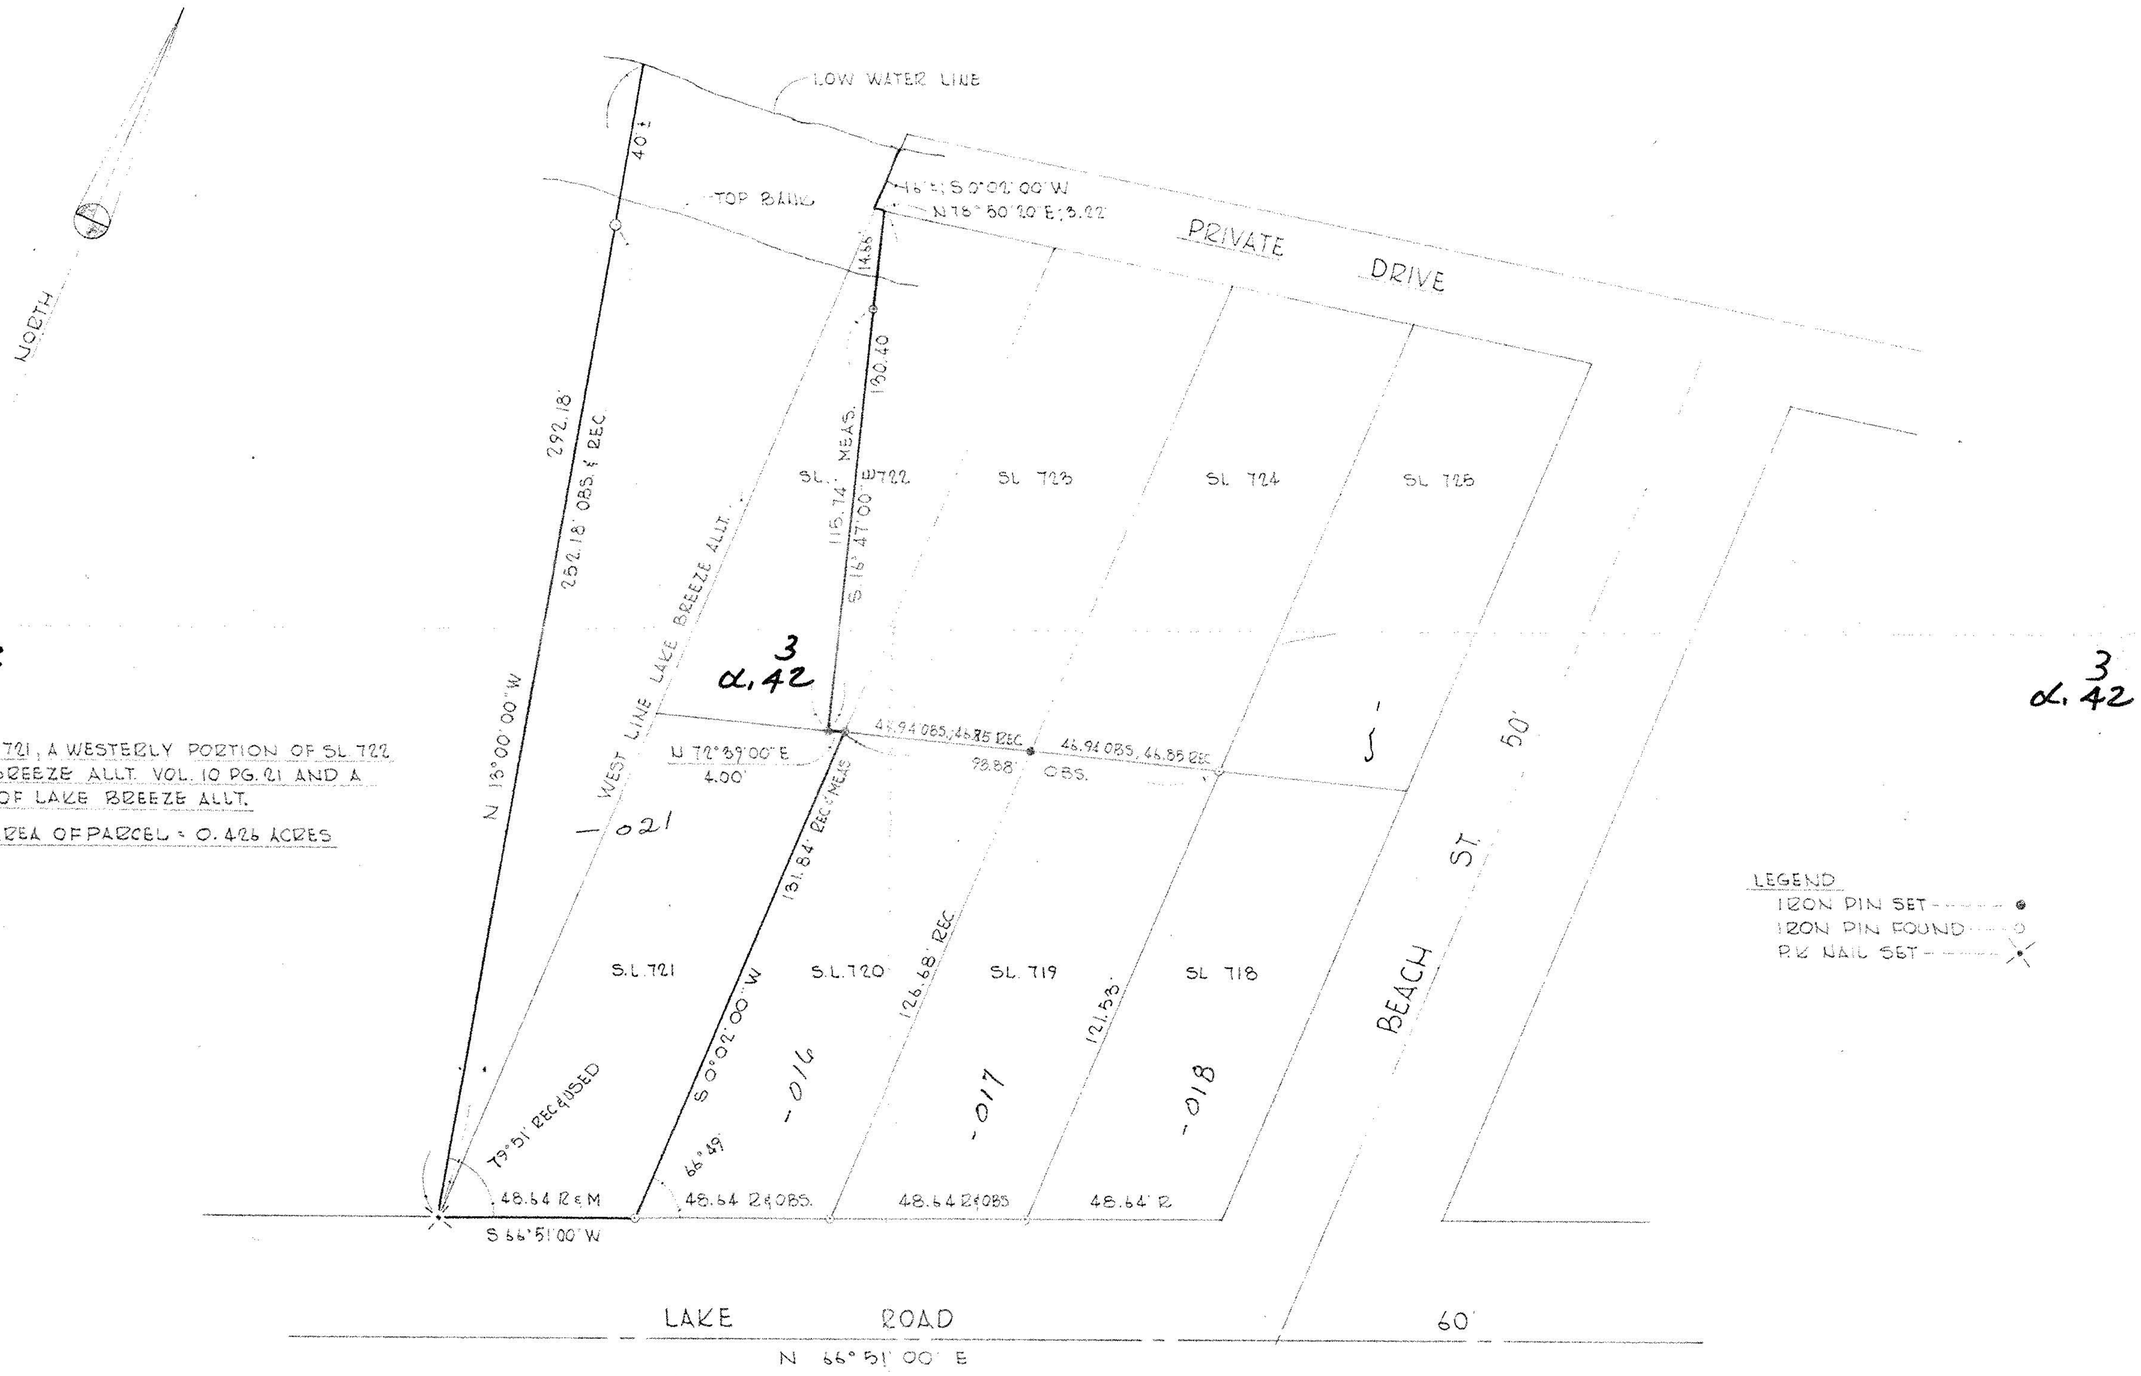


LEGEND
IRON PIN SET
IRON PIN FOUND
PK NAIL SET

JACK PISKURA
4045 LAKE RD.
SHEFFIELD LAKE, OHIO

**SCHAFER, HURA & ASSOCIATES, INC.**
ENGINEERS AND SURVEYORS
4656 OBERLIN AVE.
LORAIN, OHIO

SURVEY

ORIGINAL LOT 42
TOWNSHIP SHEFFIELD
CITY OF SHEFFIELD LAKE
COUNTY OF LORAIN
STATE OF OHIO
W. O. S-1017

DATE 6-3-75
SCALE 1" = 30'
FIELD BOOK 228 PG 131
DRAWN BY JFB
CHECKED BY
FILE NO. 3-00-042