3-00-031A

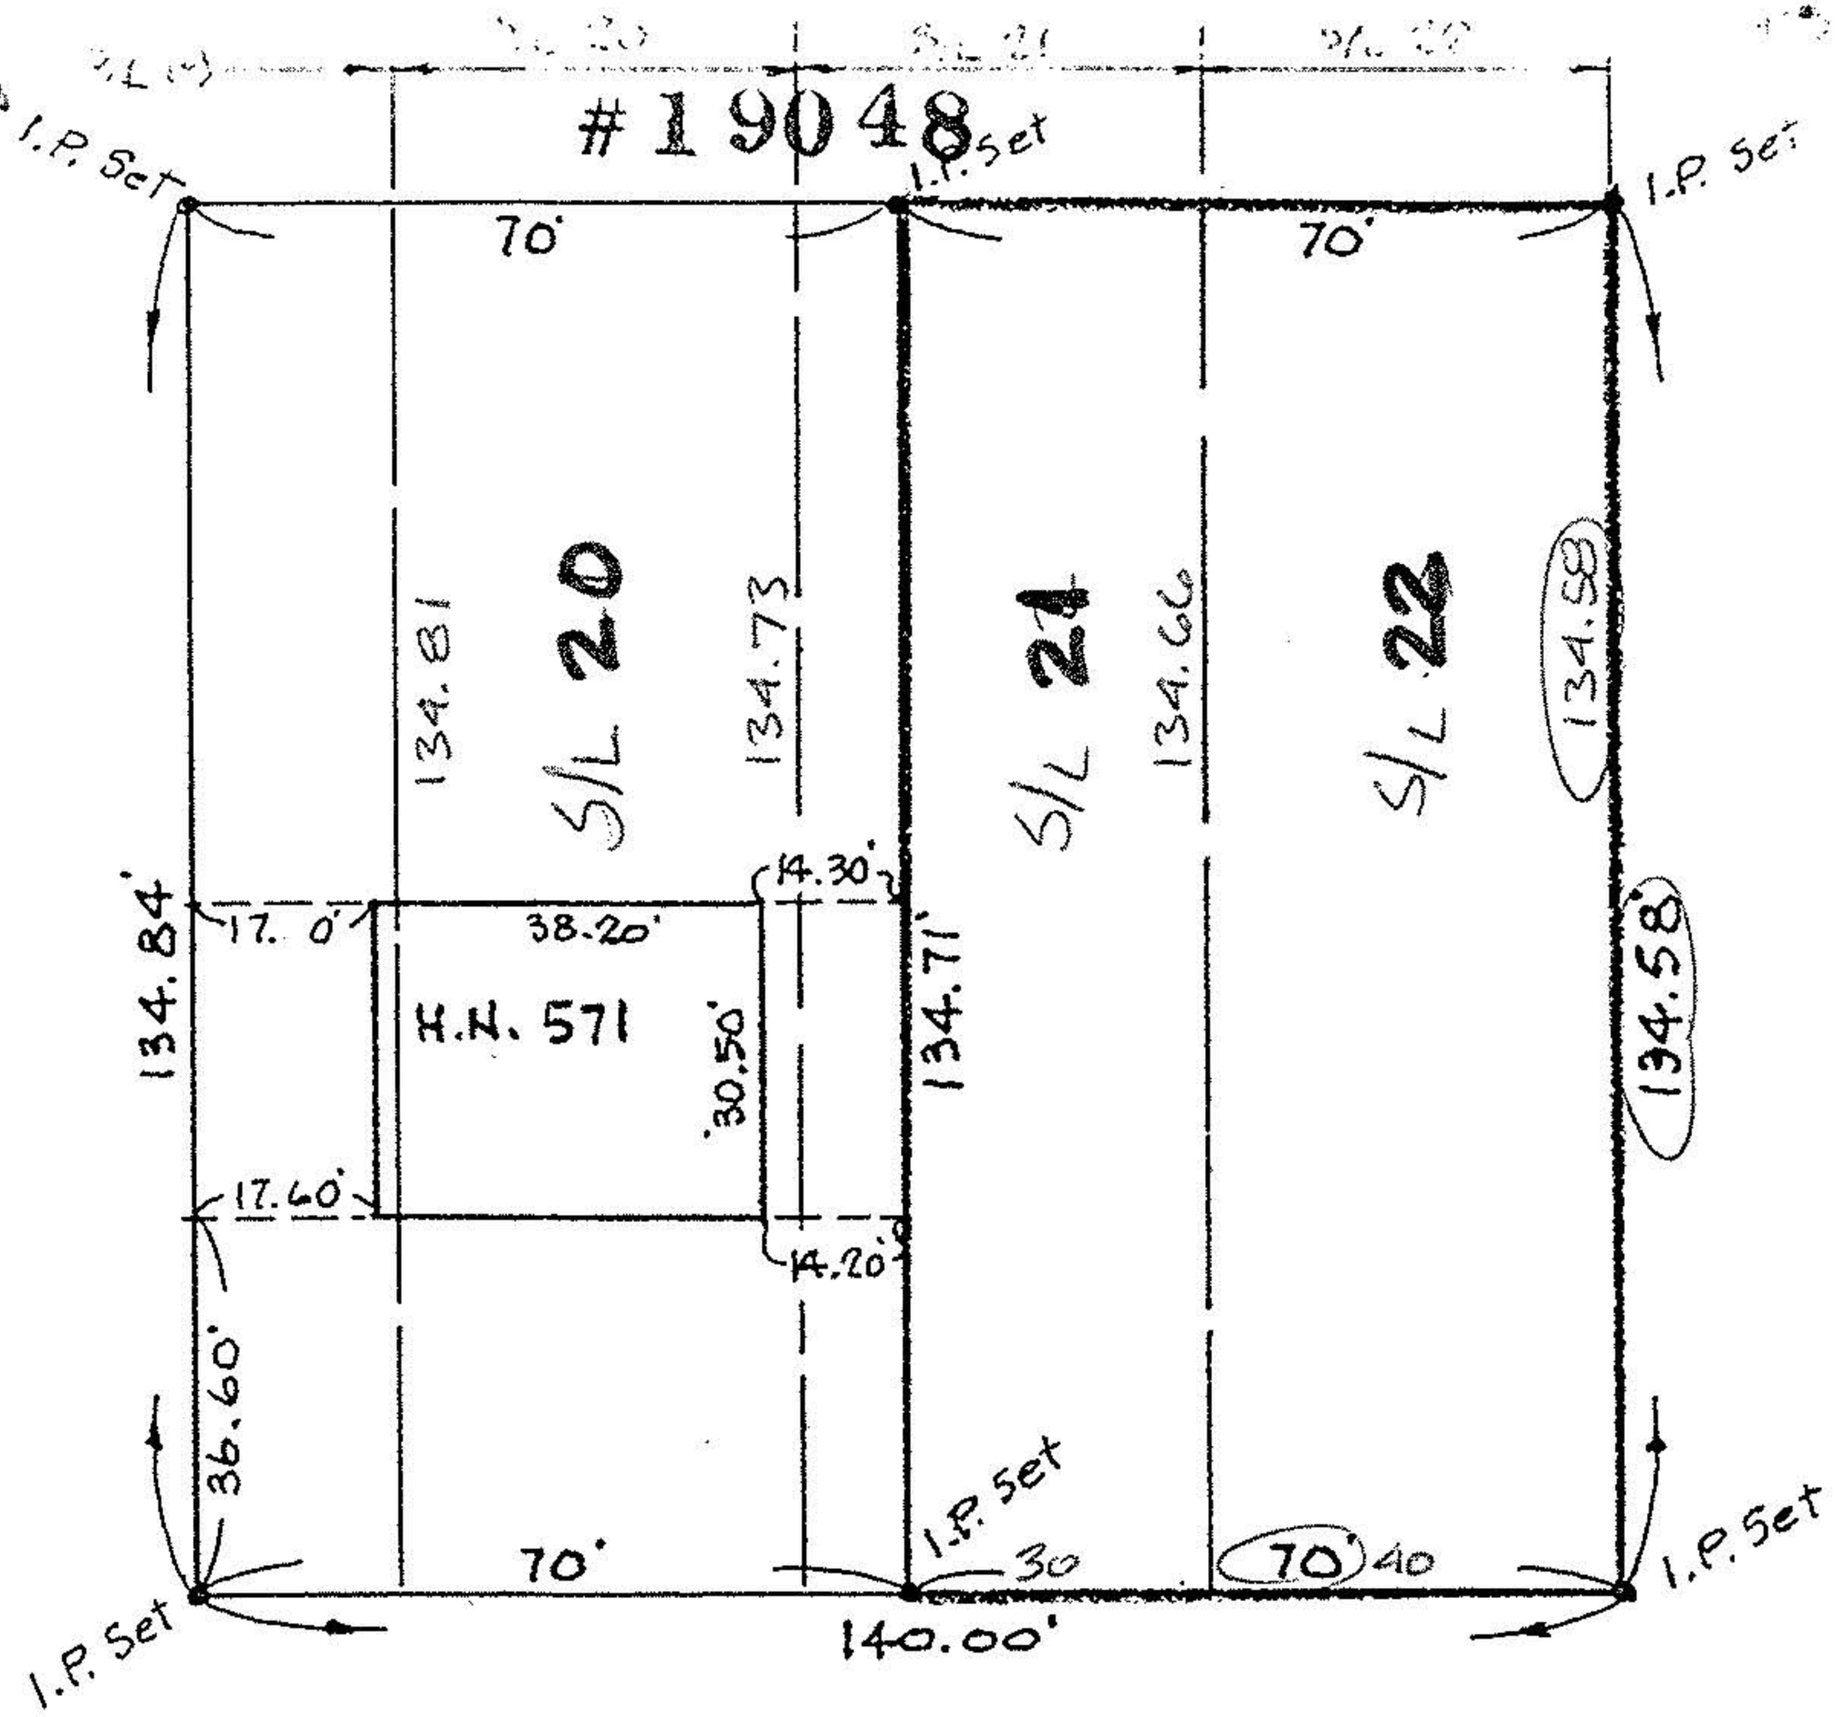


#19048
APPROVED
LORAIN CO.
MAP DEPT.
DATE 7-19-90
PAGE 3-00-031A
BY CAROLYN FRANCIS
VOID AFTER #19048

LAFAYETTE BLVD. - 70'

MAP of SURVEY

PREPARED FOR BURL MILLER

PART SUBLOT 19 & ALL OF SUBLOTS 20, 21 & 22 IN BLOCK 'C' OF CORAL BEACH SUB'D - PLAT VOL. 11, PG. 17
CITY OF SHEFFIELD LAKE, LORAIN COUNTY, OHIO

McGLINCHY & ASSOC. INC.
ELYRIA OHIO
APRIL, 1980 #506265