MAP OF SURVEY
for
3728 STATE ROUTE 611

SHEFFIELD VILLAGE
COUNTY OF LORAIN – STATE OF OHIO
by

McSTEEN & ASSOCIATES, INC.
ENGINEERS & SURVEYORS
26451 Curtiss Wright Parkway
Richmond Heights, Ohio 44143
(216) 797-9800

PRINTED
MAY 23 2002
McSTEEN & ASSOCIATES

Situated in the State of Ohio, County of Lorain, Village of Sheffield, being part of Original Sheffield Township Lot Number 59, being a parcel of land, now or formerly in the name of Debbie P. McDavid as recorded in Volume 858, Page 230 of the Official Records of Lorain County.

Bearings shown hereon are to an assumed meridian and are used to denote angles only. Distances are given in feet and decimal parts thereof. All iron pins shown as set are 30" long 1/2" rebar with an identification cap stamped "McSteen & Assoc".

Robert A. Dorner 5-28-02
ROBERT A. DORNER REG. PROF. SURVEYOR # 6943
JOB No. 02-091

STATE OF OHIO ROBERT A. DORNER 6943 REGISTERED SURVEYOR

The Basis of Bearings for this survey is S 59°41'00" E as the centerline of Lorain Avon Road, as evidenced by concrete right of way monuments found, and is the same bearing as shown on page 29 of 66 of the Ohio Department of Transportation Plans for State Highway 827: SEC-Sheffield-P.T.

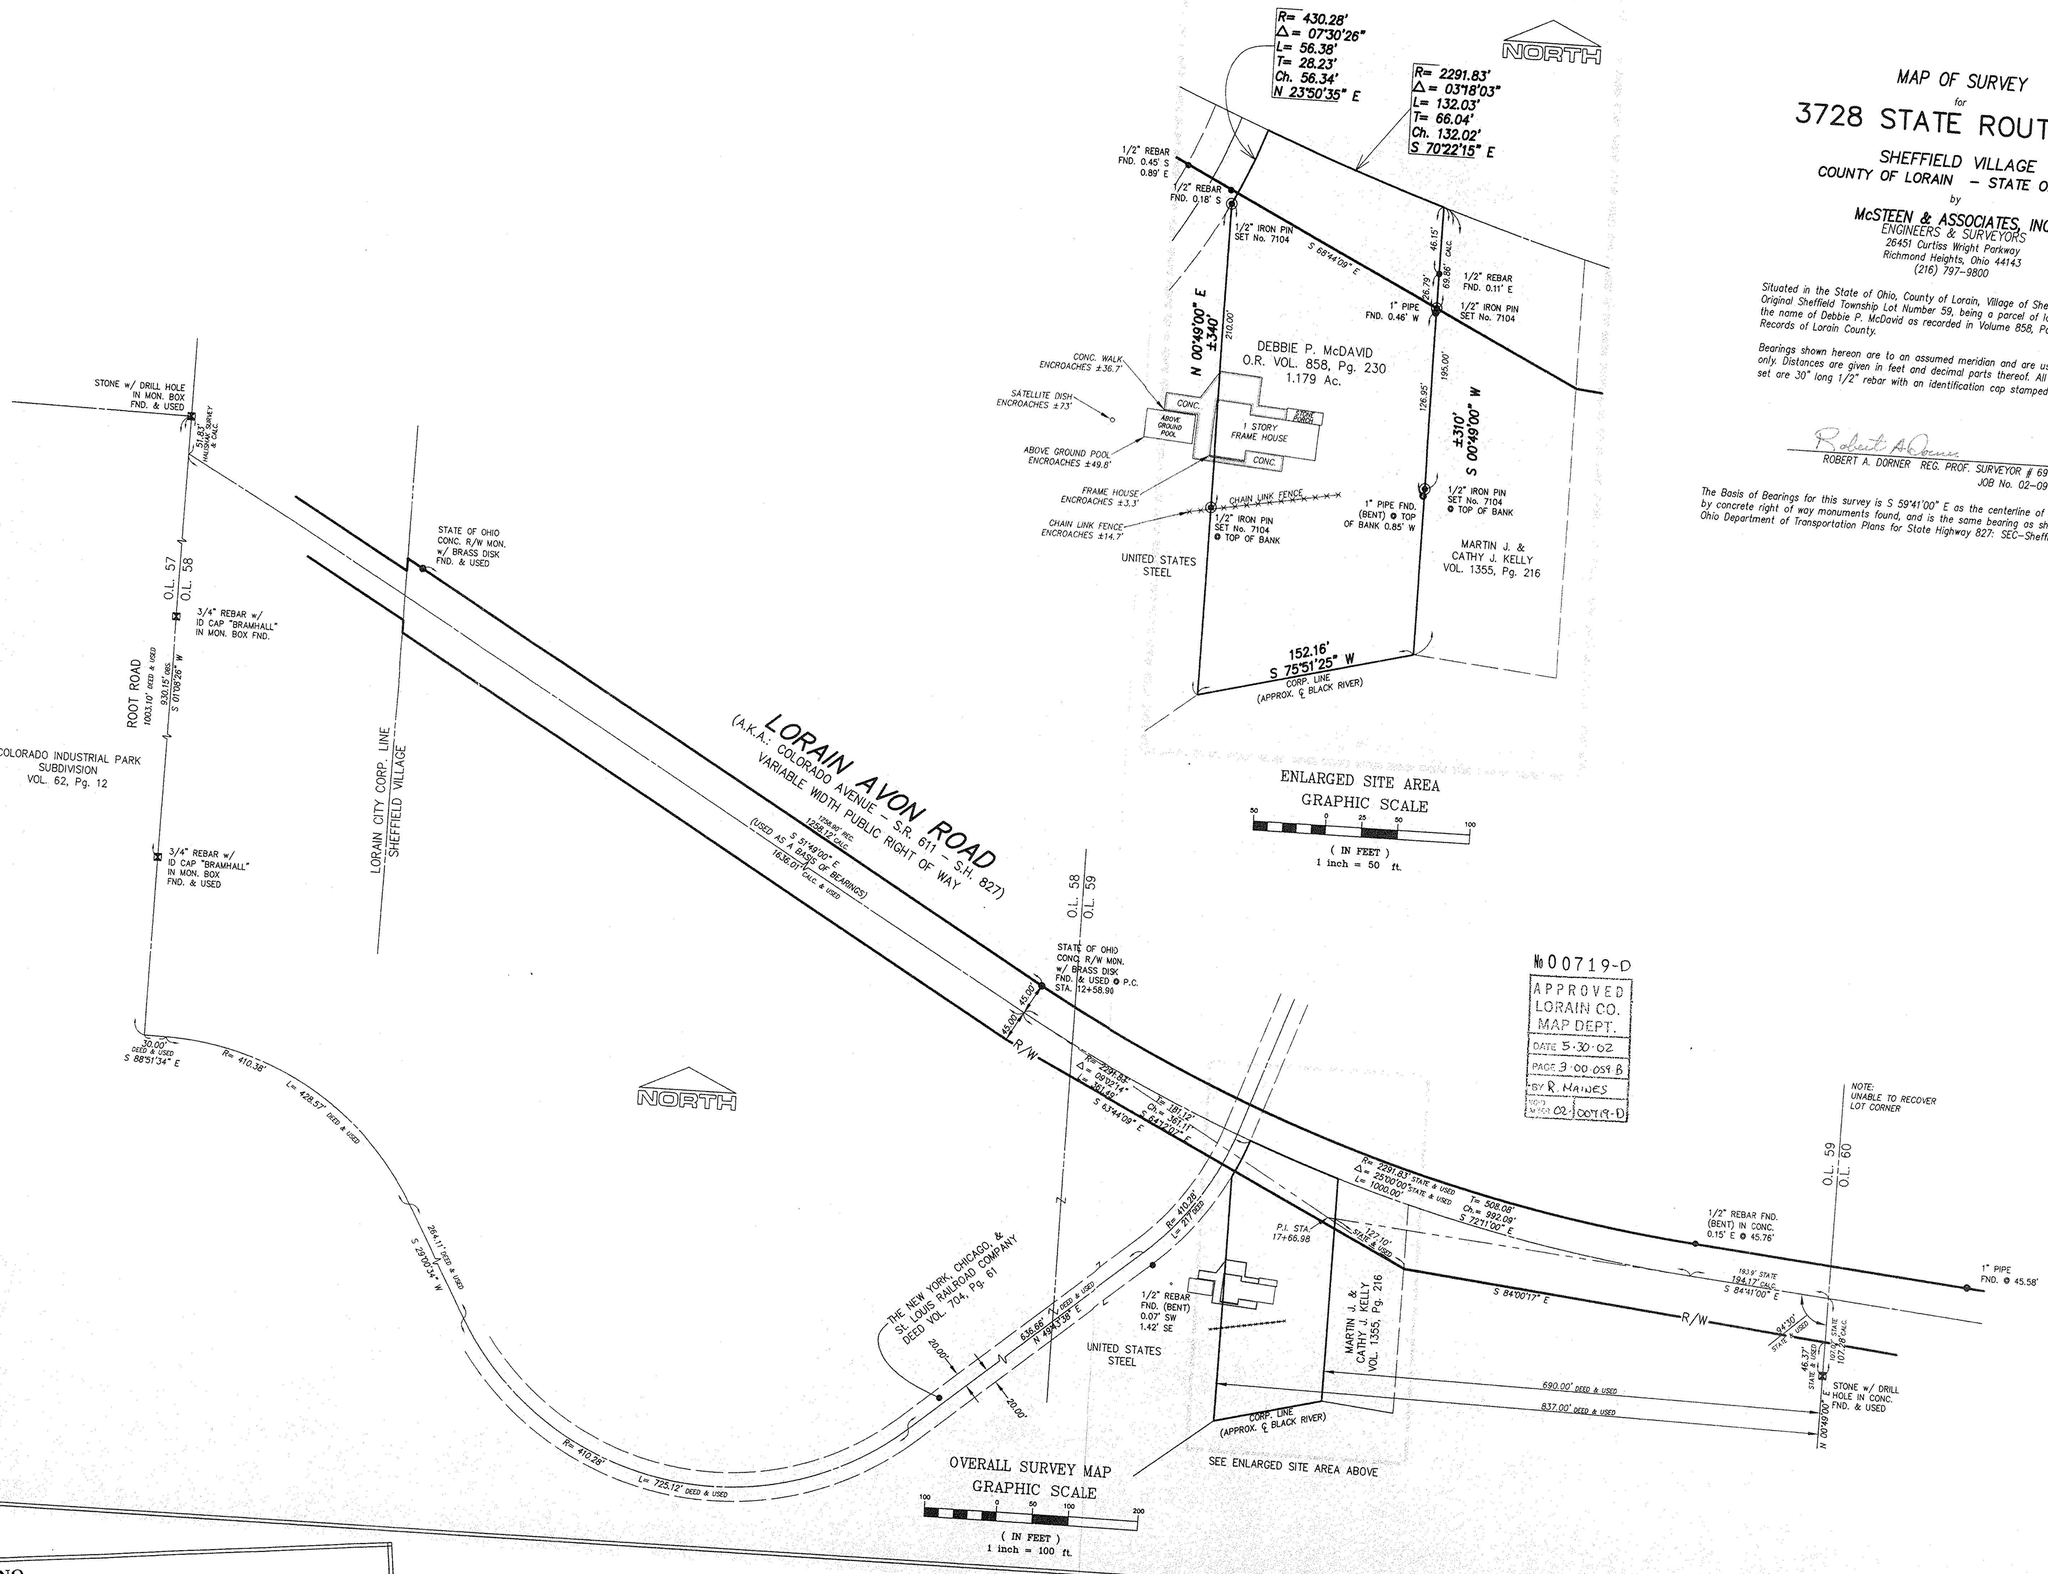

P.P. NO.	
03-00-059-000-005	
SPLIT #	DATE OF SURVEY
01-00719-D	5/28/02