# Boundary Survey of 4949 Lake Road

*Situated in the City of Sheffield Lake, County of Lorain and State of Ohio and known as being part of Original Sheffield Township Lot No. 36*

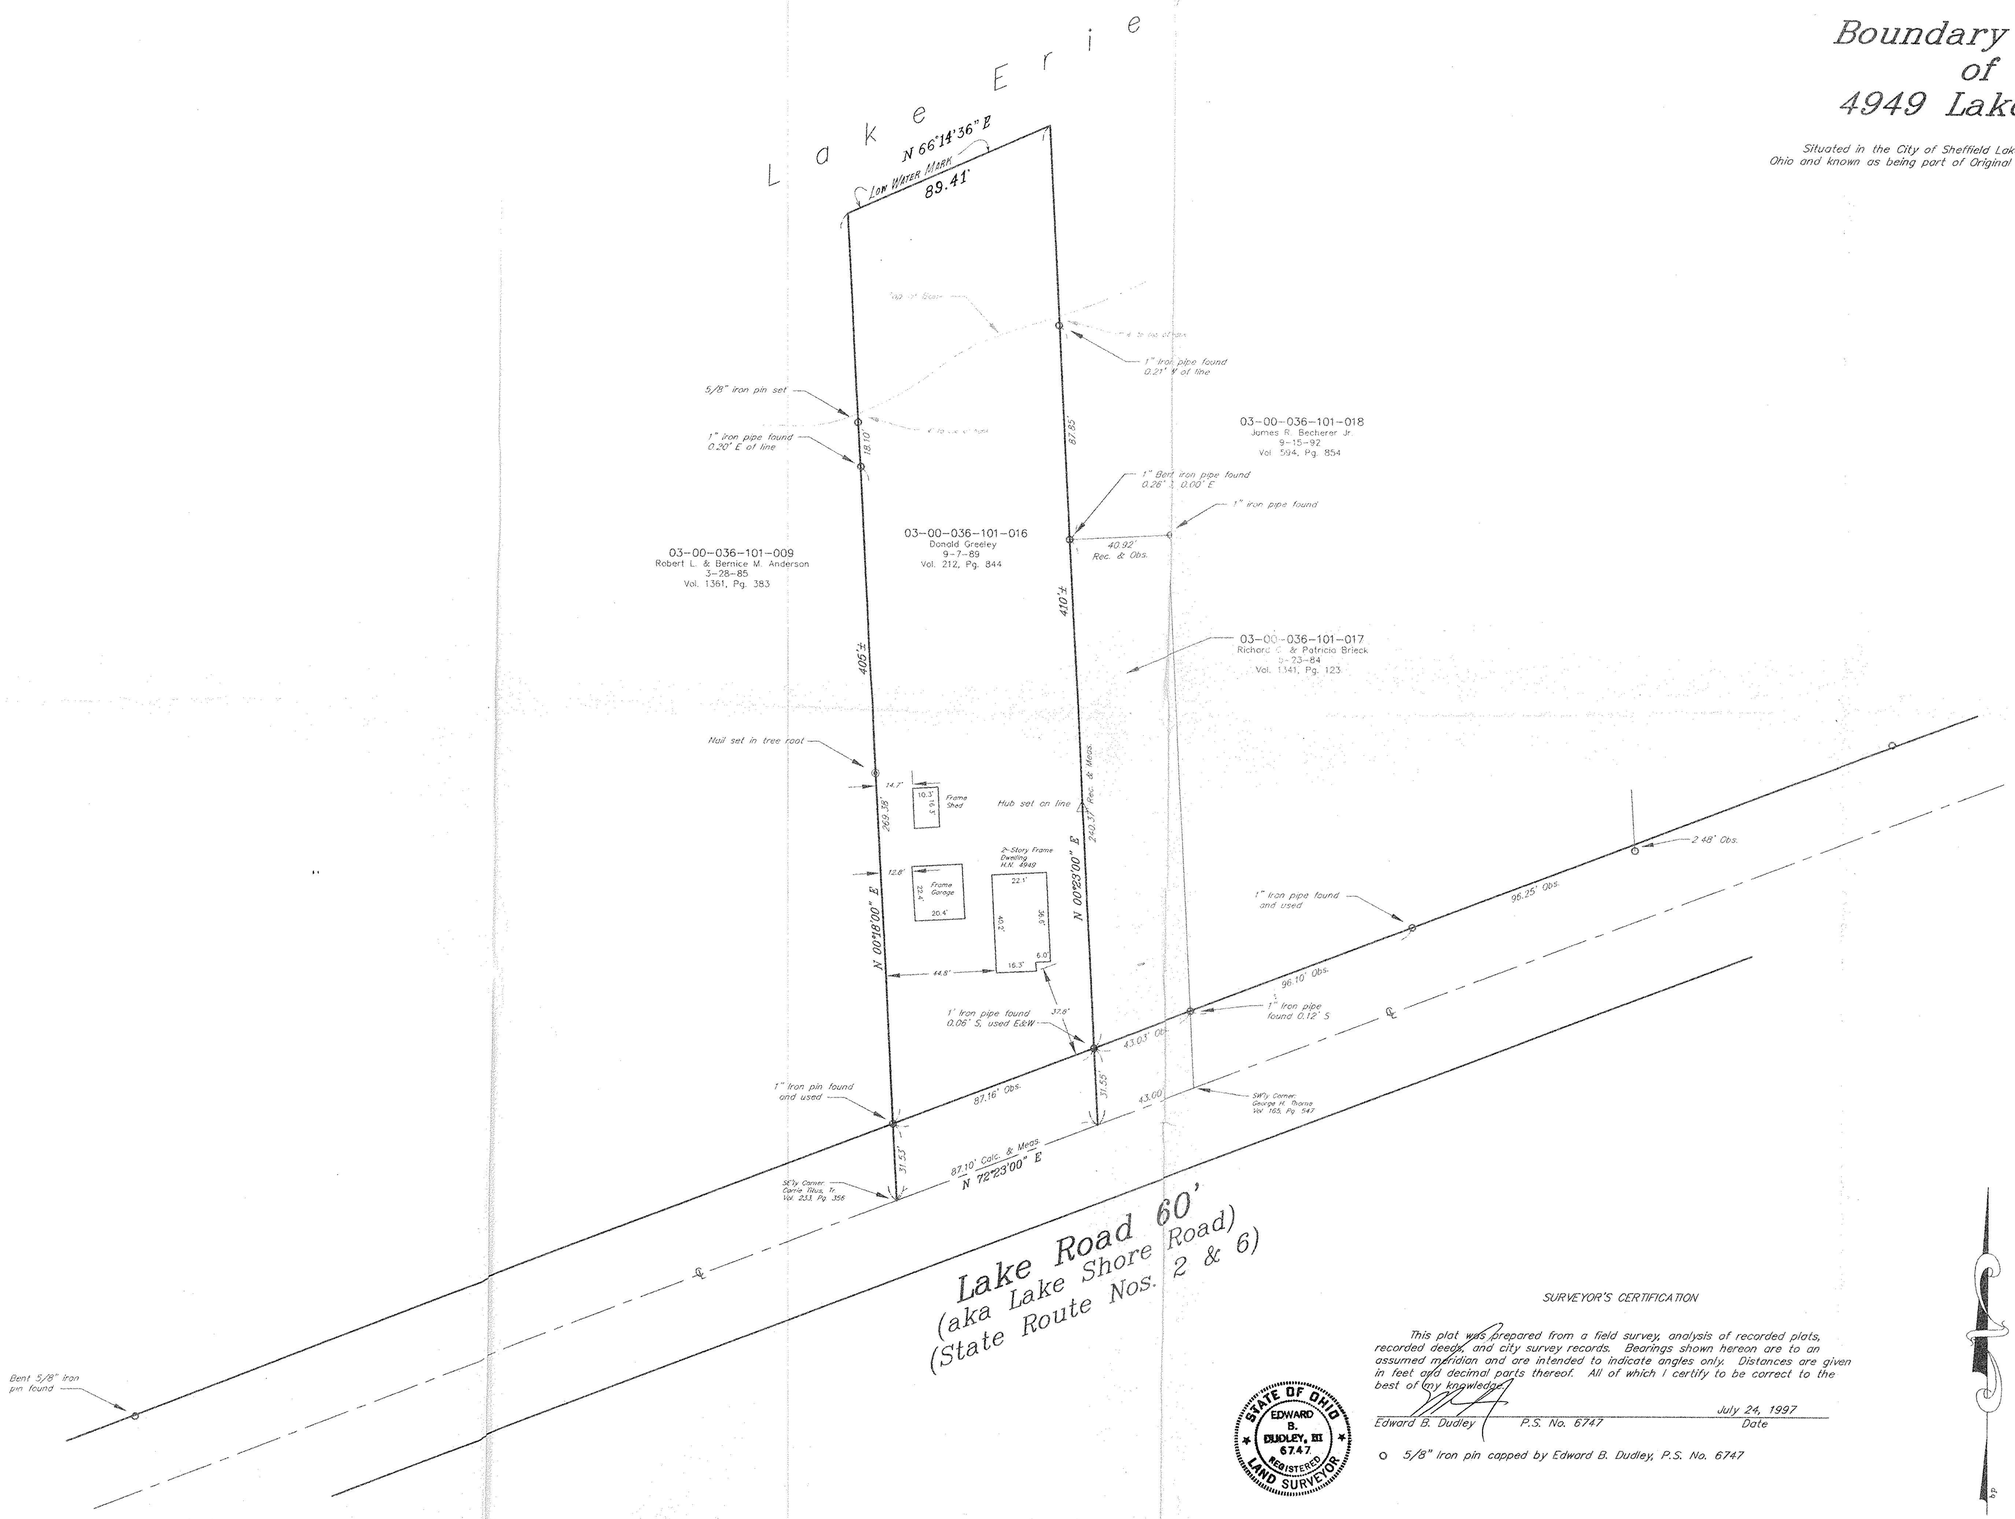


#22282-D

| APPROVED LORAIN CO. MAP DEPT |
|---|
| DATE 9/30/97 |
| PAGE 3-00-036-A |
| BY K. Colbert |

## LEGEND

| | |
|---|---|
| STORM MANHOLE | WATER METER MANHOLE |
| SANITARY MANHOLE | HYDRANT |
| CURB INLET | WATER VALVE |
| CATCH BASIN | UTILITY POLE |
| GAS METER | LIGHT POLE |
| MONUMENT BOX | ELECTRIC METER |
| DRILL HOLE | TRANSFORMER BOX |
| IRON PIN | |
| CENTERLINE | |
| WATERLINE | |
| PROPERTY LINE | |
| RIGHT-OF-WAY LINE | |
| GAS LINE | |
| OVERHEAD UTILITY LINE | |
| ELECTRIC LINE | |
| SANITARY SEWER | |
| STORM SEWER | |
| EASEMENT LINE | |
| ORIGINAL PROP. LINE | |
| FENCE LINE | |
| RAILROAD TRACKS | |

| | | | |
|---|---|---|---|
| REC./R. | RECORD | VOL. | VOLUME |
| MEAS./M. | MEASURED | PG. | PAGE |
| CALC./C. | CALCULATED | C.L.F. | CHAIN-LINK FENCE |
| OBS. | OBSERVED | CONN. | CONNECTION |
| ENCR. | ENCROACHES | AC. | ACRES |
| CLR. | CLEARS | S.F. | SQUARE FEET |
| ADJ. | ADJACENT | C.C.M.R. | CUYAHOGA COUNTY MAP RECORDS |
| ASP. | ASPHALT | | |
| CONC. | CONCRETE | P.P.N. | PERMANENT PARCEL NUMBER |

### SURVEYOR'S CERTIFICATION

This plat was prepared from a field survey, analysis of recorded plats, recorded deeds, and city survey records. Bearings shown hereon are to an assumed meridian and are intended to indicate angles only. Distances are given in feet and decimal parts thereof. All of which I certify to be correct to the best of my knowledge.

Edward B. Dudley P.S. No. 6747 — July 24, 1997 Date

STATE OF OHIO — EDWARD B. DUDLEY, III — 6747 — REGISTERED LAND SURVEYOR

○ 5/8" iron pin capped by Edward B. Dudley, P.S. No. 6747

GRAPHIC SCALE

30 0 15 30 60 120

( IN FEET )
1 inch = 30 ft.


The NORTH COAST Engineering & Surveying Co., Inc.
2570 Superior Ave., Suite 501 Clev., Ohio 44114
Tel. (216) 241-7070 Fax (216) 241-7071