3-00-033-B

3-00-033-B

03-00-033-118-058

1" = 30'

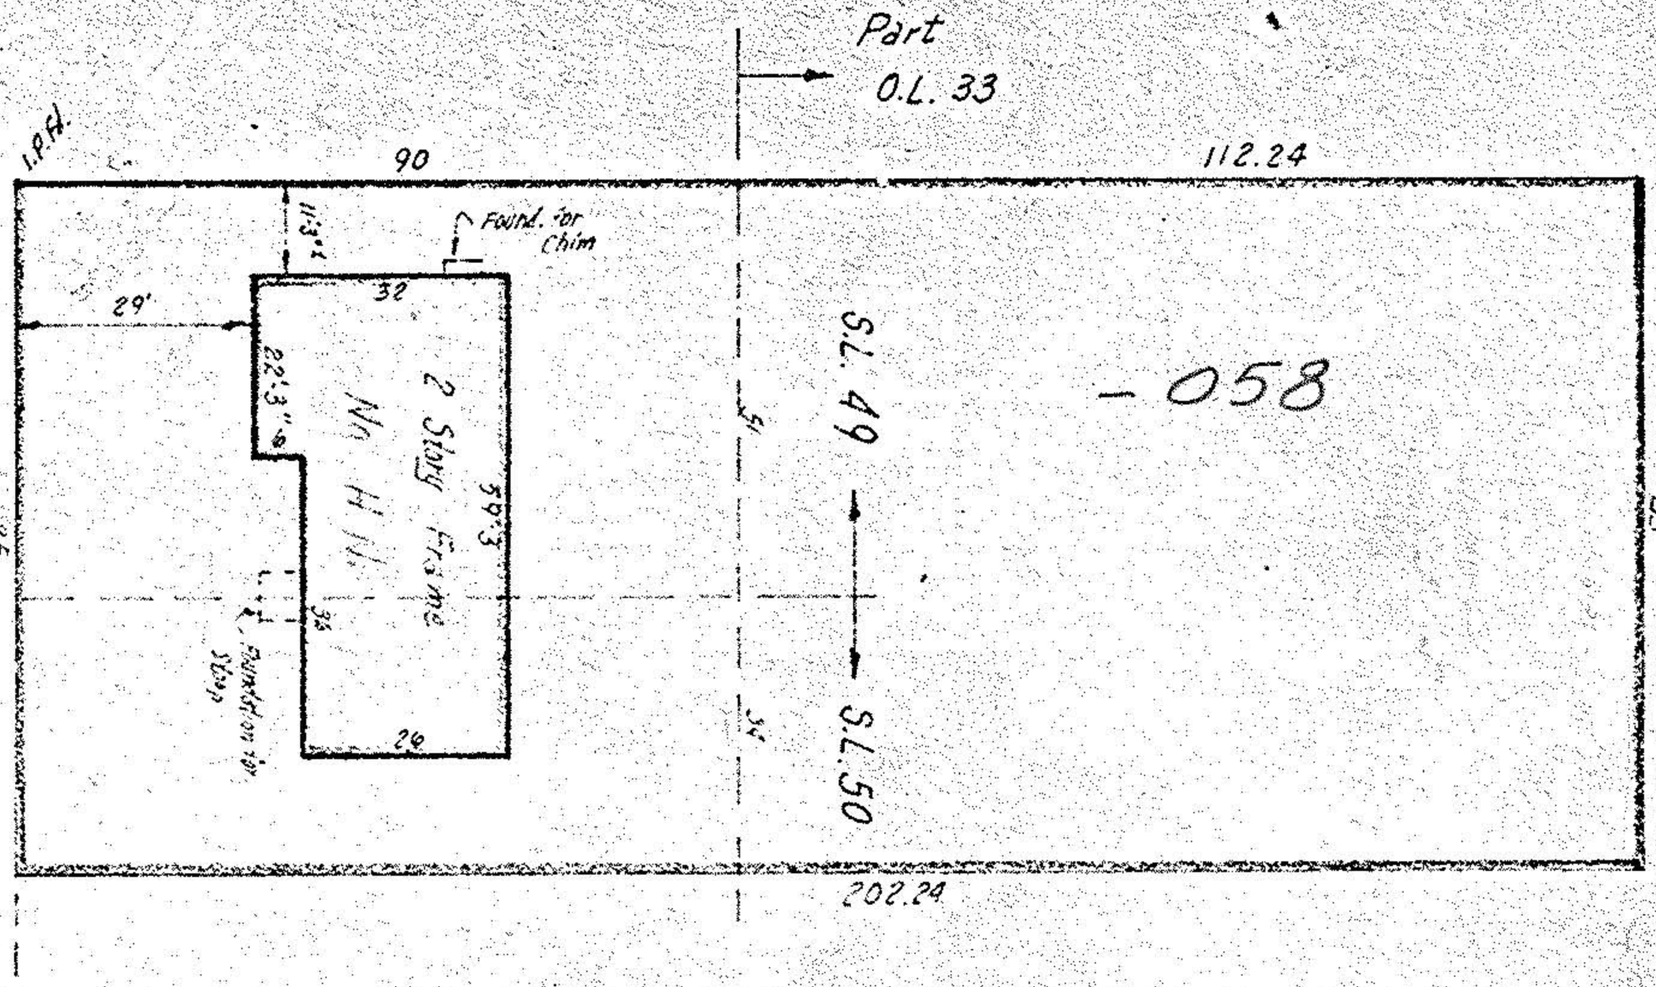

#1151
APPROVED
LORAIN CO.
MAP DEPT.
DATE 6-14-78
PAGE 3-00-033 B
BY T. McNair
VOID AFTER

PART of SUBLOT # 50 plus ALL of
SUBLOT #49 of COVE BEACH ALLOTMENT

PLAT VOL. 11 PAGE 11 plus
PART of ORIG. SHEFFIELD TWP. LOT 33
NOW in CITY of SHEFFIELD LAKE, OHIO

THIS IS NOT A PLAT OF SURVEY:
FOR MORTGAGE LOAN PURPOSES ONLY

McGLINCHY & ASSOCIATES
FEB. 14, 1978 #772534
ST-L-8126