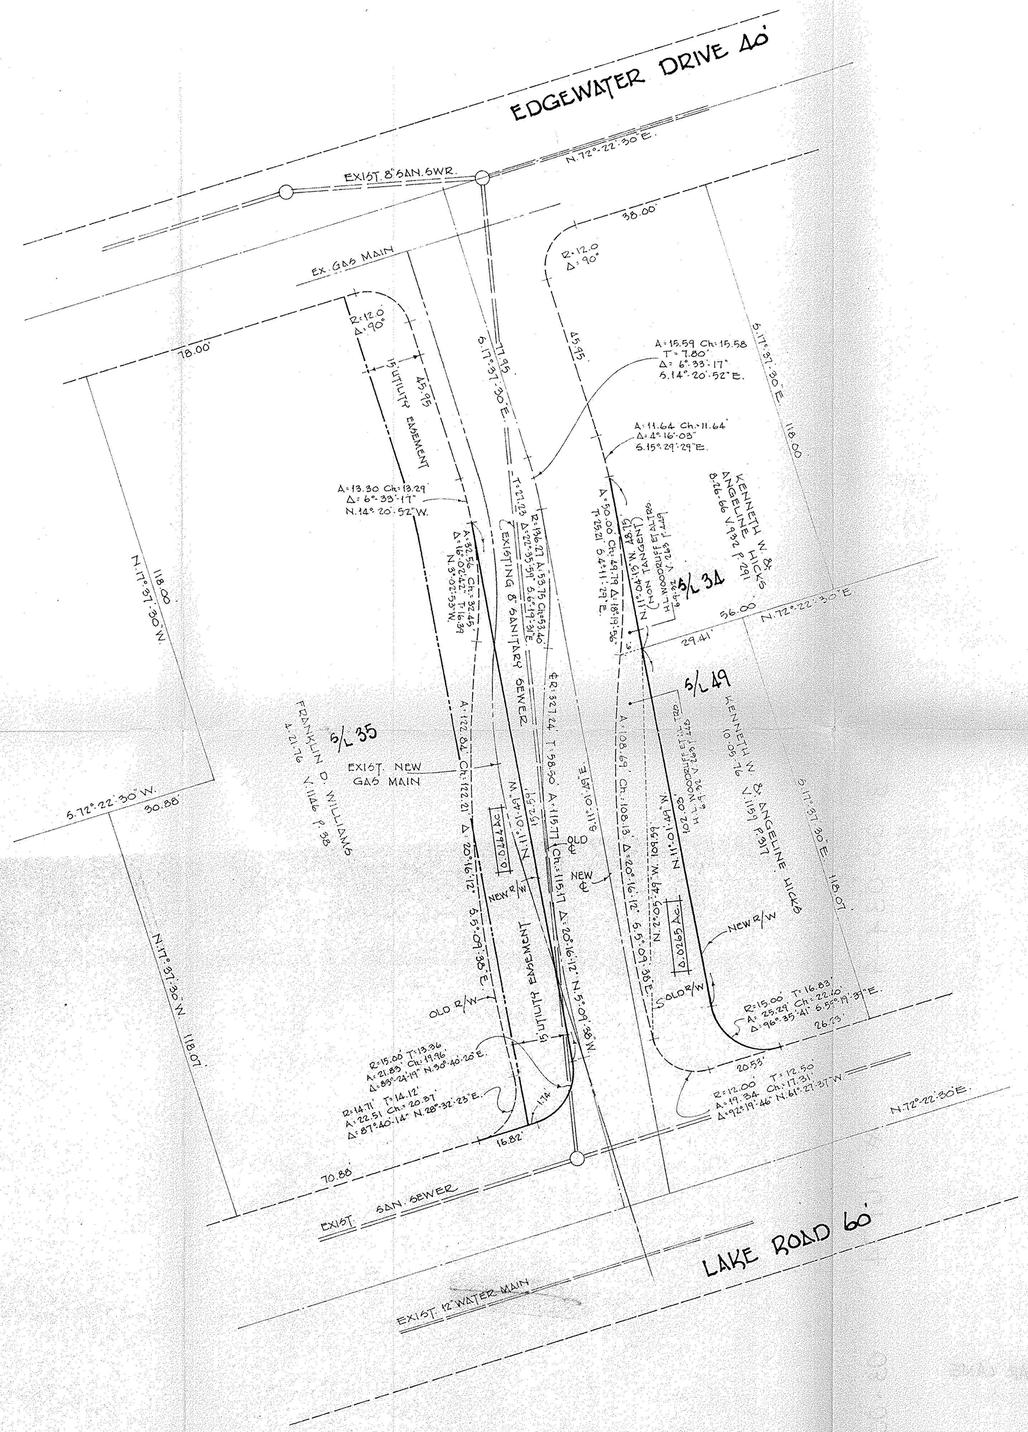

JIM TRUBACH (BUILDING DEPT.) 949-7141 (949-5767)

MERLE WALTON 949-6839 (SEWER DIRECTOR)

OLD NAME
North SHEFFIELD DR.

RIGHT - OF - WAY RELOCATION

CEDAR LANE

PART OF BORDER CITIES CO'S. SHEFFIELD ON THE LAKE ALLOTMENT
PLAT VOL. 11 PG. 7

O.L. 34 SHEFFIELD TWP. — CITY OF SHEFFIELD LAKE
COUNTY OF LORAIN — STATE OF OHIO
JANUARY 21, 1985 — SCALE 1" = 20'

LAUNDON • SIMON • CAHL & ASSOC.
ENGINEERS SURVEYORS
JOB Nº 84-1334

#16174
APPROVED
LORAIN CO.
MAP DEPT.
DATE 5.10.85
PAGE 3.00.034.A
BY T. McMain
VOID

REVISED AND RE-DRAWN JAN. 21, '85 & SUPERSEDES PREVIOUS DWG. DATED NOV. 5, '84

3-00-034-103