


9-00-094-A

P.P.# 03-00-085-101-85

09-00-085-101

3-00-094-A

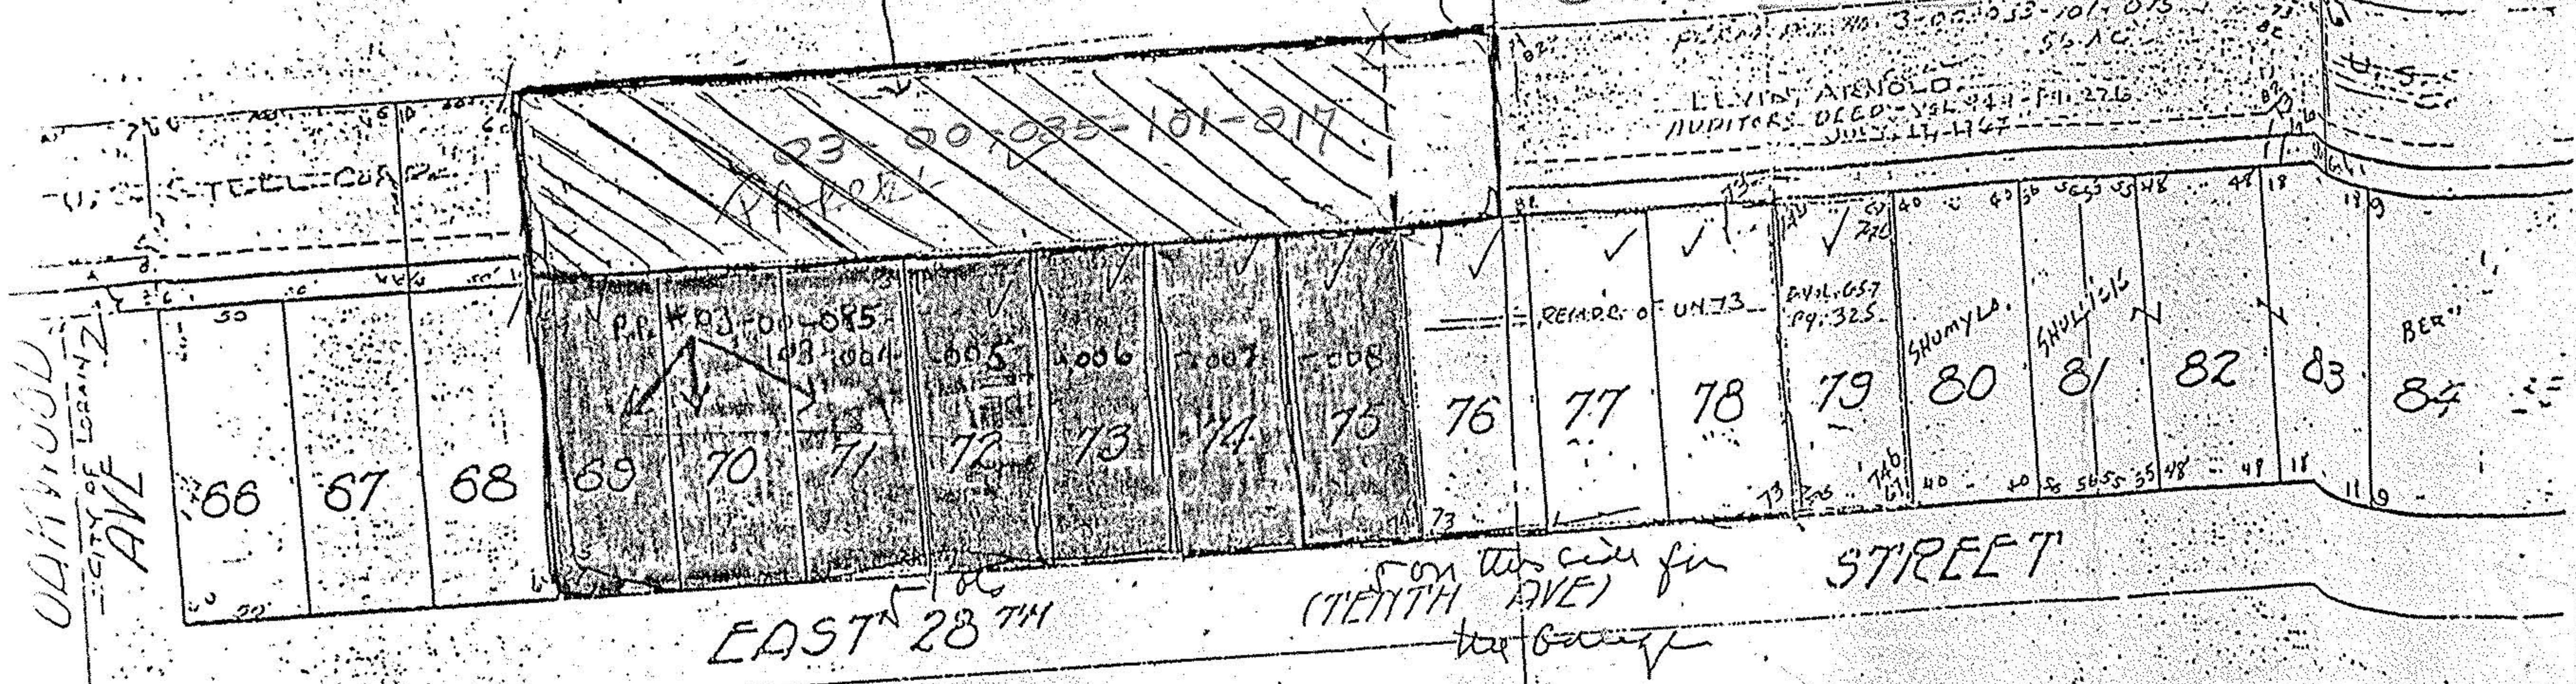

CITY OF LORAIN  
AVE

EAST 28TH

on the side for  
TENTH AVE

STREET

~~RECEIVED~~  
PROPERTY OF THE CITY OF LORAIN  
PLANNING DEPARTMENT

S.

#11904

APPROVED	DATE 8-8-78
LORAIN CO.	PAGE 3-00-094-A
MAP. DEPT.	BY: T. McNamee
VOID AFTER	