


3-00-029-A #17735 03-00-024-000




DATE: SEPT 29, 1987
SCALE: 1"=100'

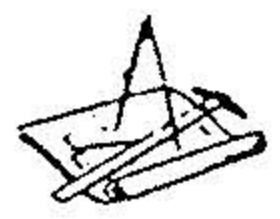


HAPONEK & ASSOCIATES, INC.

Engineers & Surveyors
34100 Center Ridge Road
NORTH RIDGEVILLE, OHIO 44039
(216) 327-4776

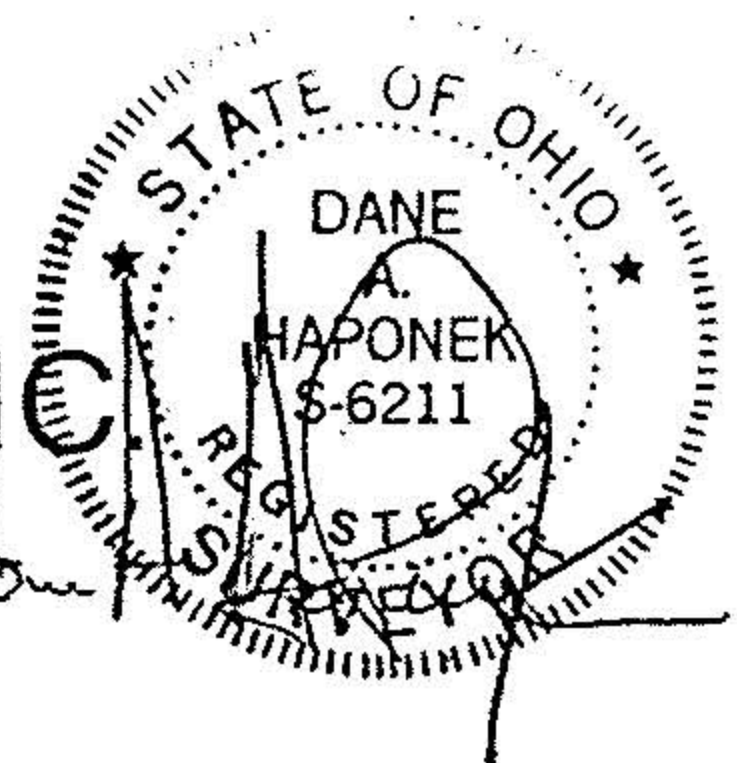

PREPARED FOR
WALTER AND JUNE RAUSCHER
959 HARRIS RD.
SHEFFIELD VILLAGE, O.

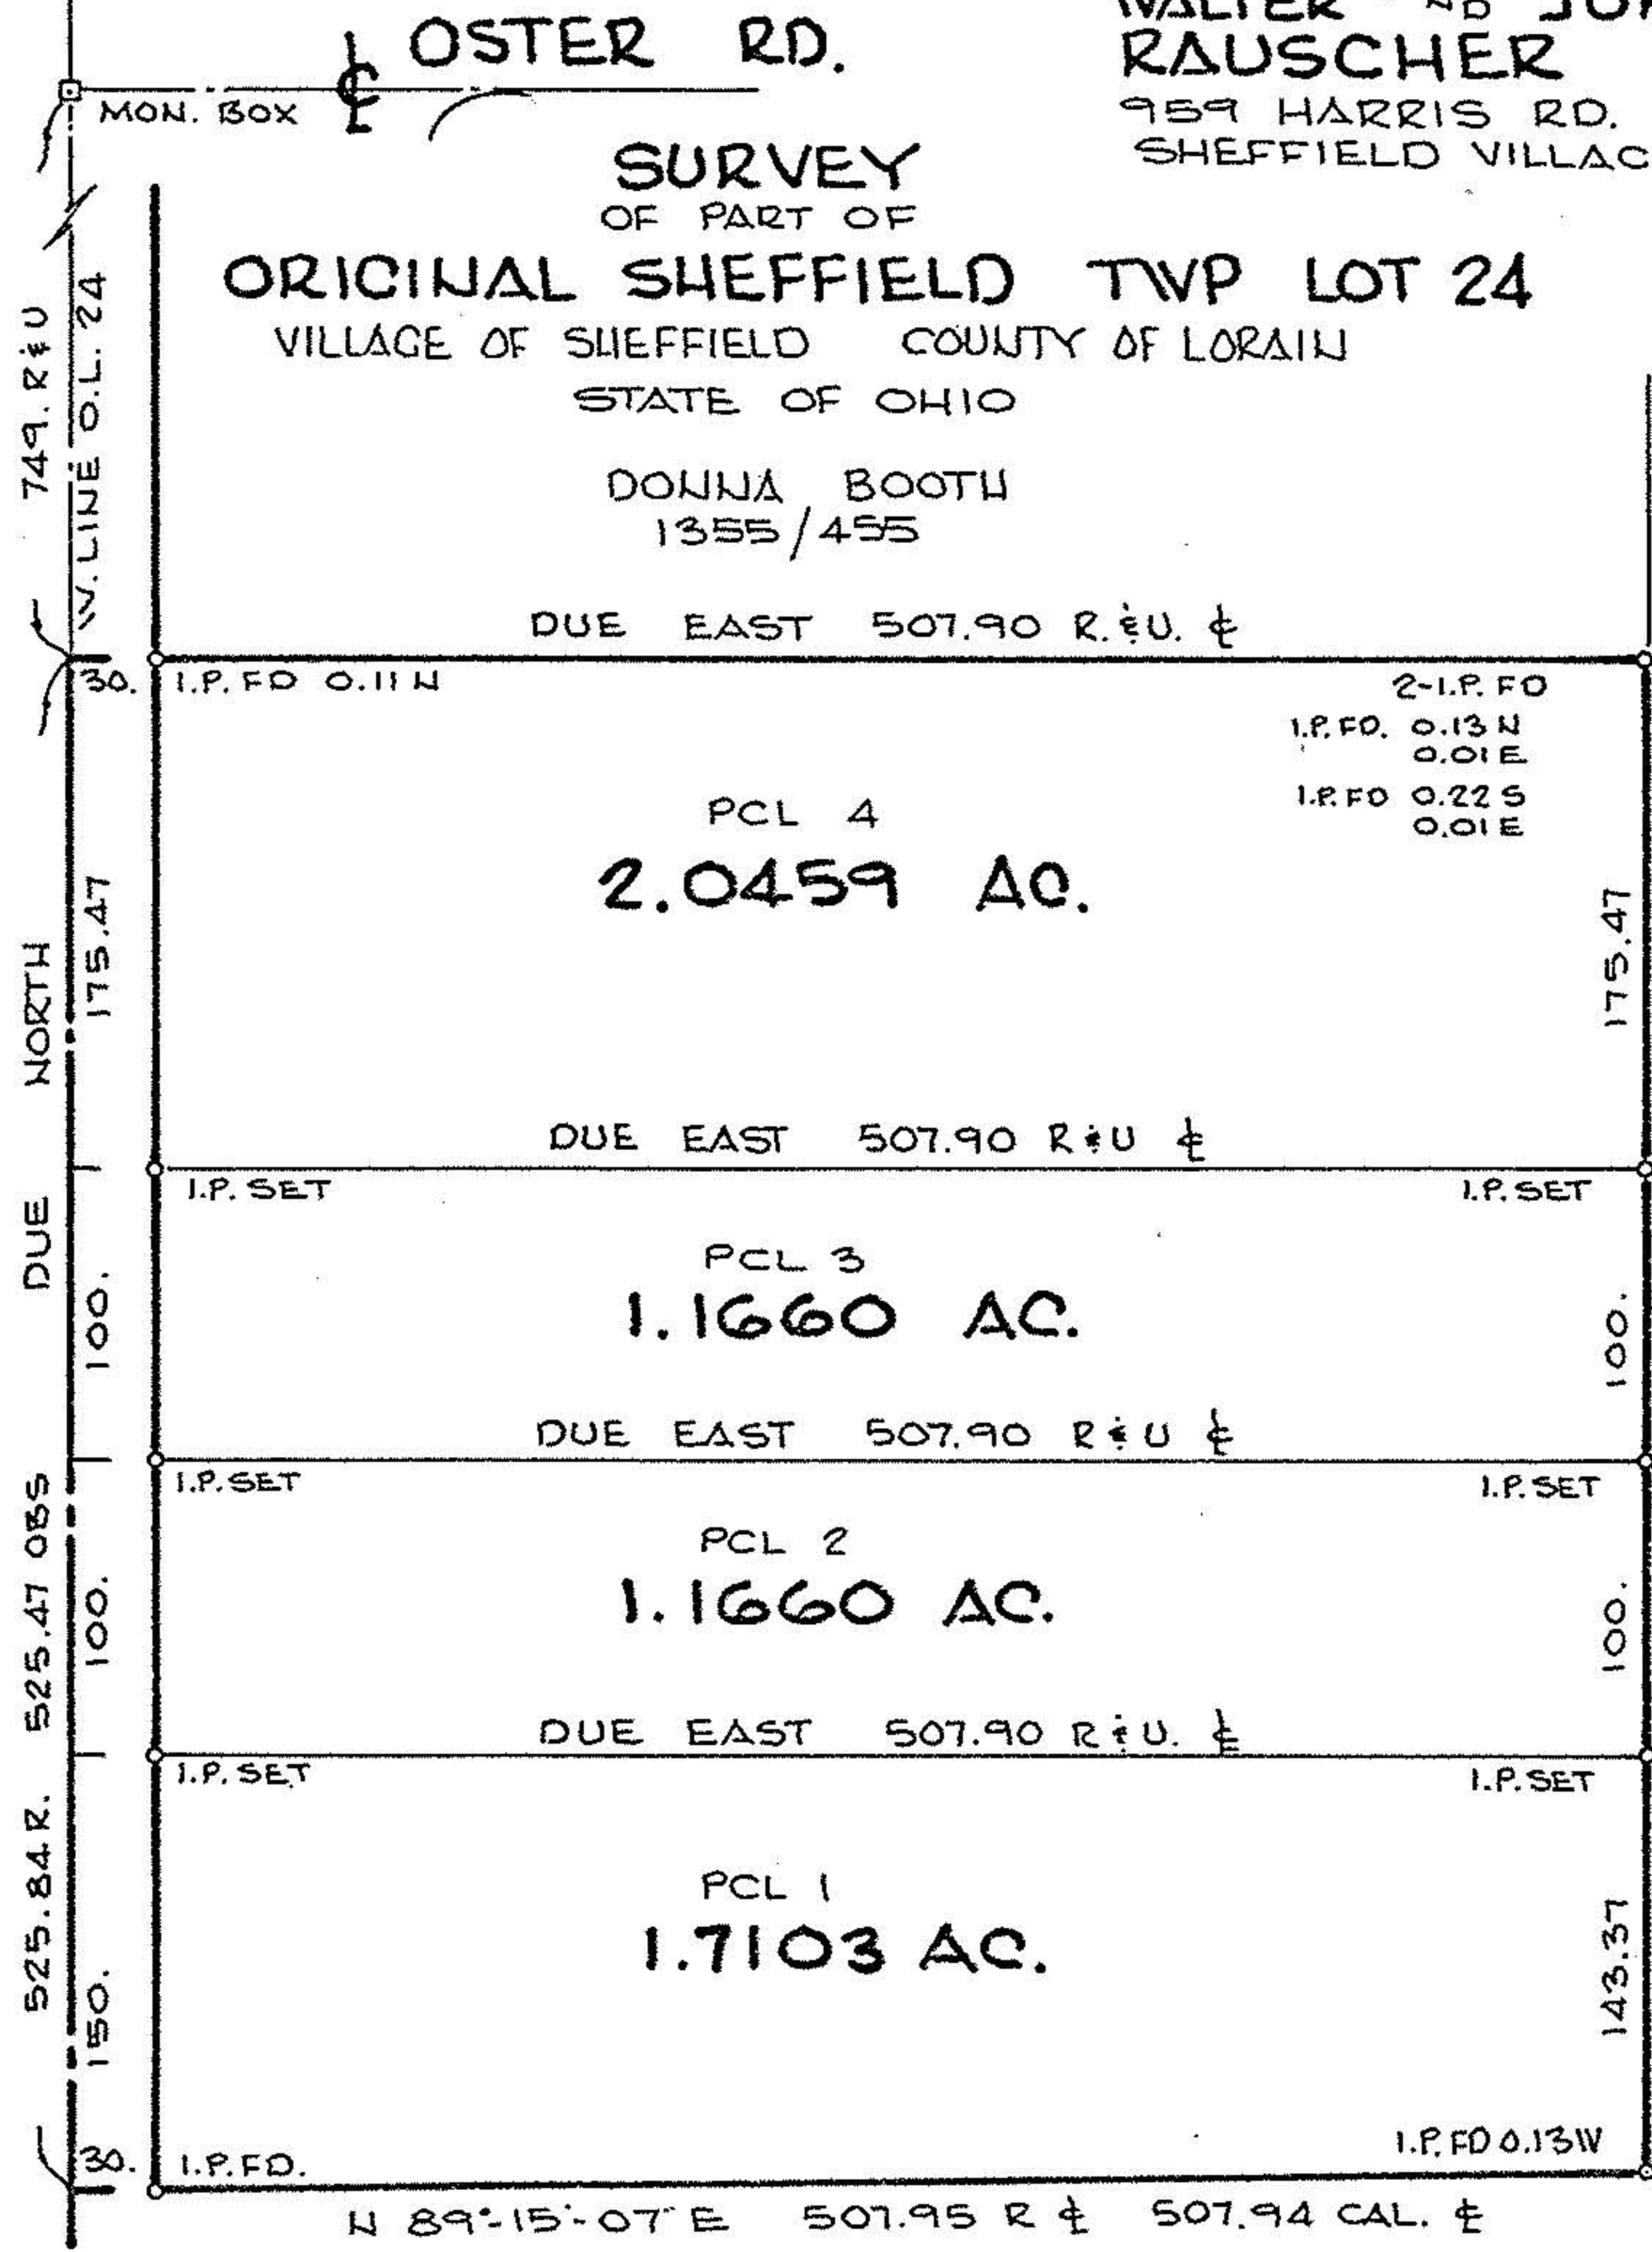

NORFOLK AND WESTERN RAILWAY CO.

GILBERTE A. & JOHN P. SHAW
1340/919