12-00-054-000

#18960

D-054-A,B

KLEINOEDER · SCHMIDT and ASSOCIATES

ENGINEERS — SURVEYORS — CONSULTANTS in LAND PLANNING

ELYRIA · NORWALK · MEDINA OHIO

SURVEY MAP

JOB Nº 77-396

SUBLOT

SUBDIVISION

OTHER PART OF COLUMBIA TOWNSHIP ORIG. LOT 54 - LORAIN CO. - OHIO

#18960 APPROVED LORAIN CO. MAP DEPT. DATE 6-15-90 PAGE 12-00-054-A,B BY CAROLYN FRANCIS VOID AFTER # 18960

UPDATED & REVISED BY KS ASSOCIATES INC. ENGINEERS SURVEYORS

David L. Elwell

REG. SURVEYOR NO. 6333

STATE OF OHIO DAVID L. ELWELL 6333 REGISTERED SURVEYOR

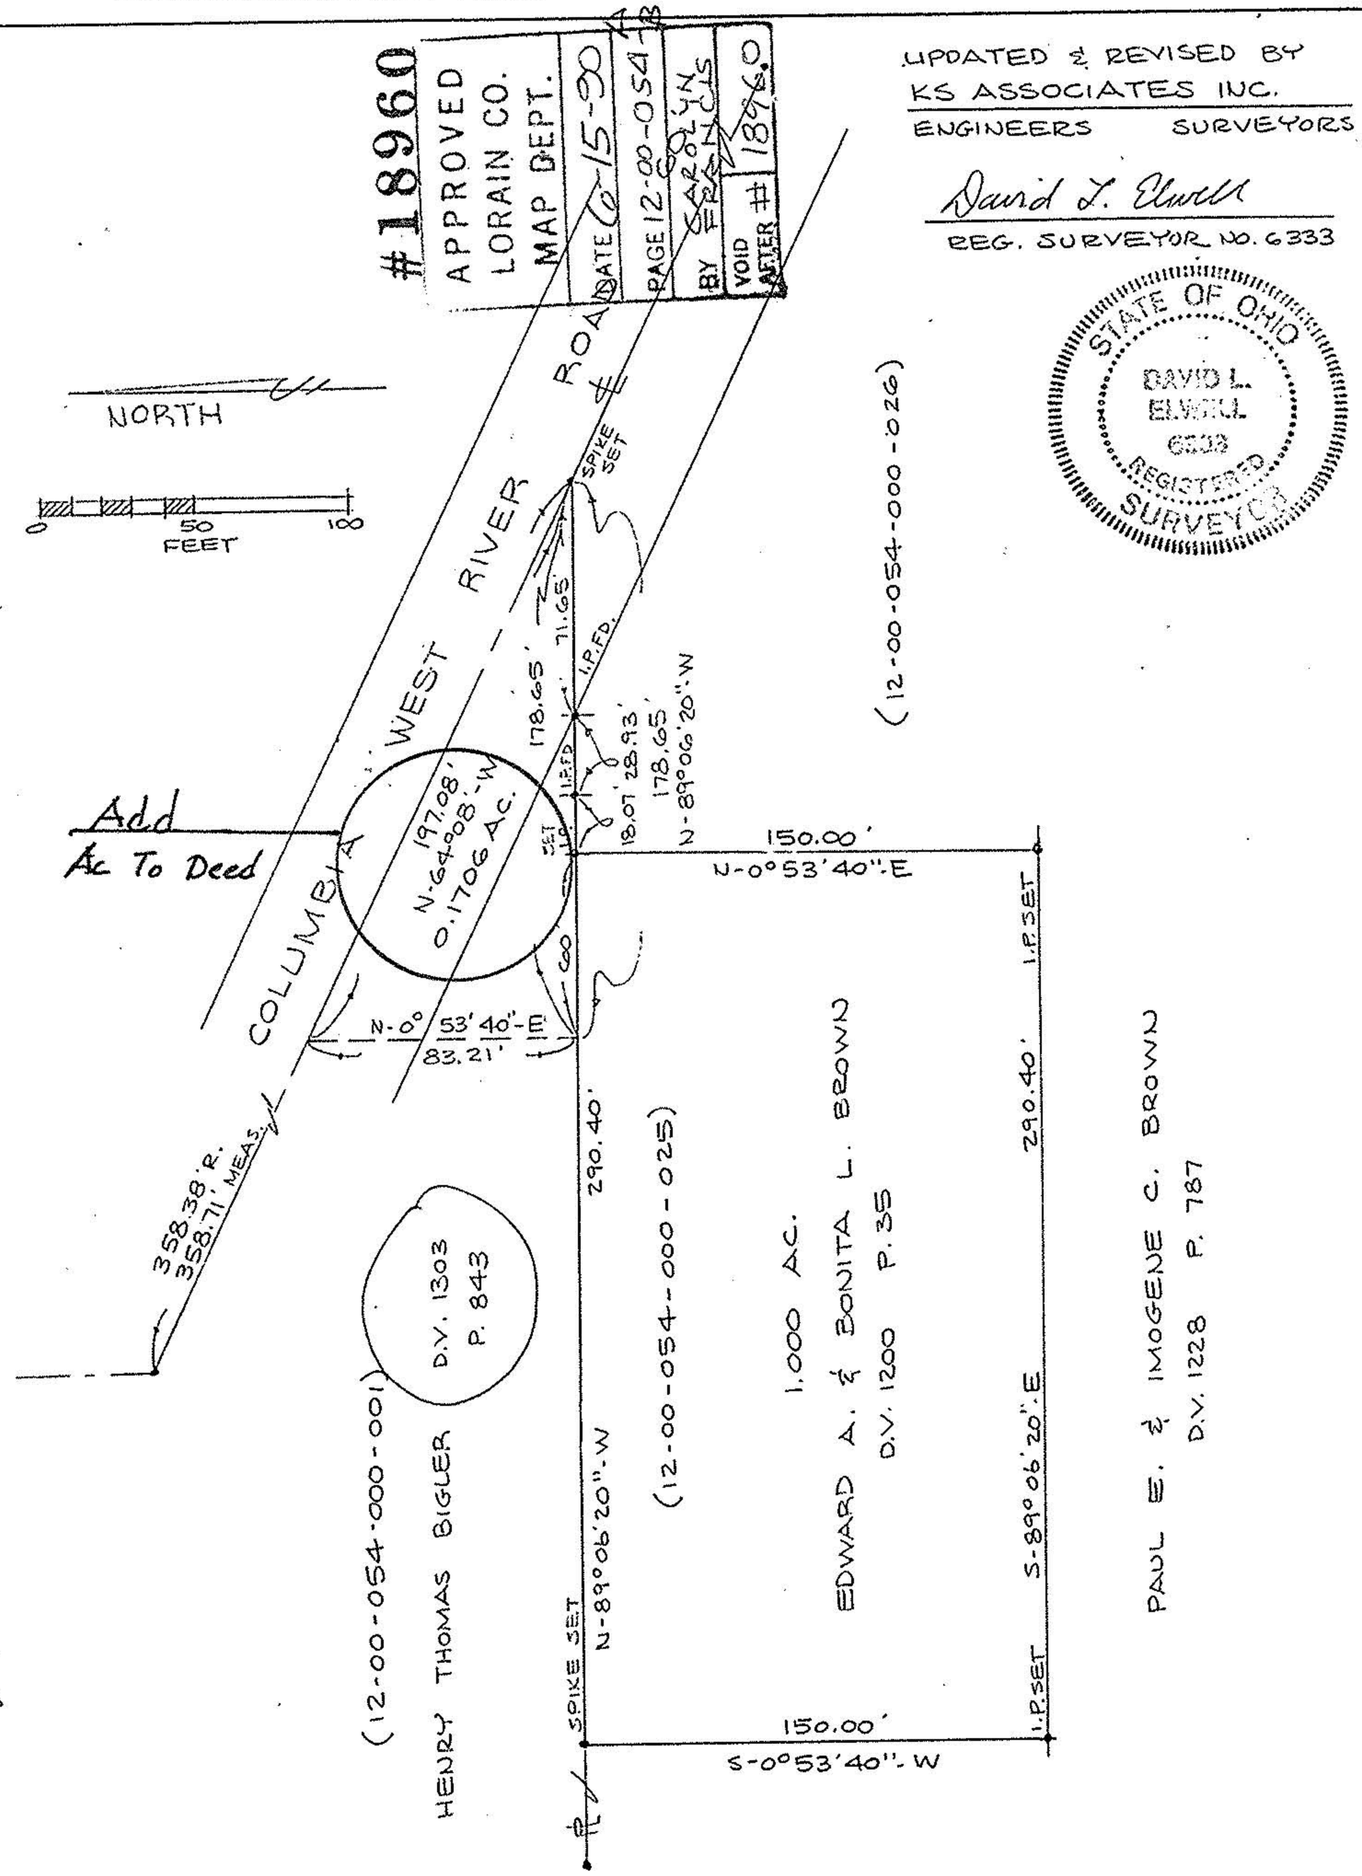

Prepared for:

Scale: 1" = 60'

Date: APRIL 6, 1978 REVISED JUNE 13, 1990

KLEINOEDER · SCHMIDT and ASSOCIATES

ENGINEERS — SURVEYORS — CONSULTANTS in LAND PLANNING

ELYRIA · NORWALK · MEDINA OHIO

PLOT PLAN

JOB Nº 77-396

SUBLOT

SUBDIVISION

OTHER PART OF COLUMBIA TOWNSHIP ORIG. LOT 54 - LORAIN CO. - OHIO

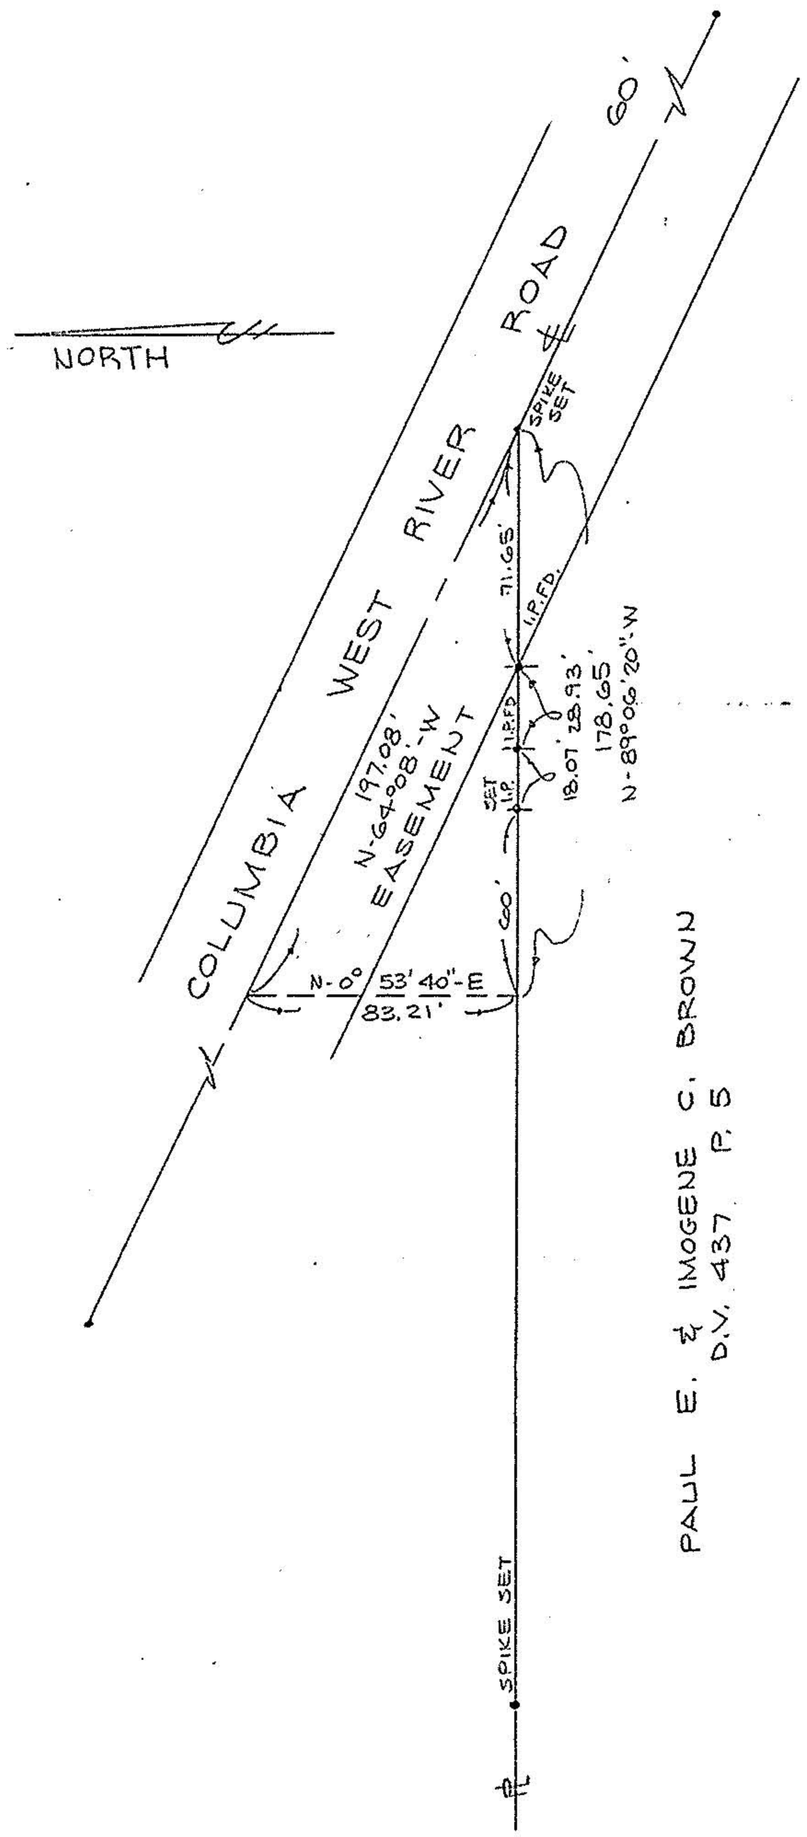

give back To owner

Prepared for:

Scale: 1" = 60'

Date: