LAUNDON . SIMON . CAHL & ASSOC. INC.
CONSULTING ENGINEERS & SURVEYORS
219 COURT ST. ELYRIA, OHIO 44035

SURVEY FOR:
ALBERT & DOROTHY I. ZIEMER
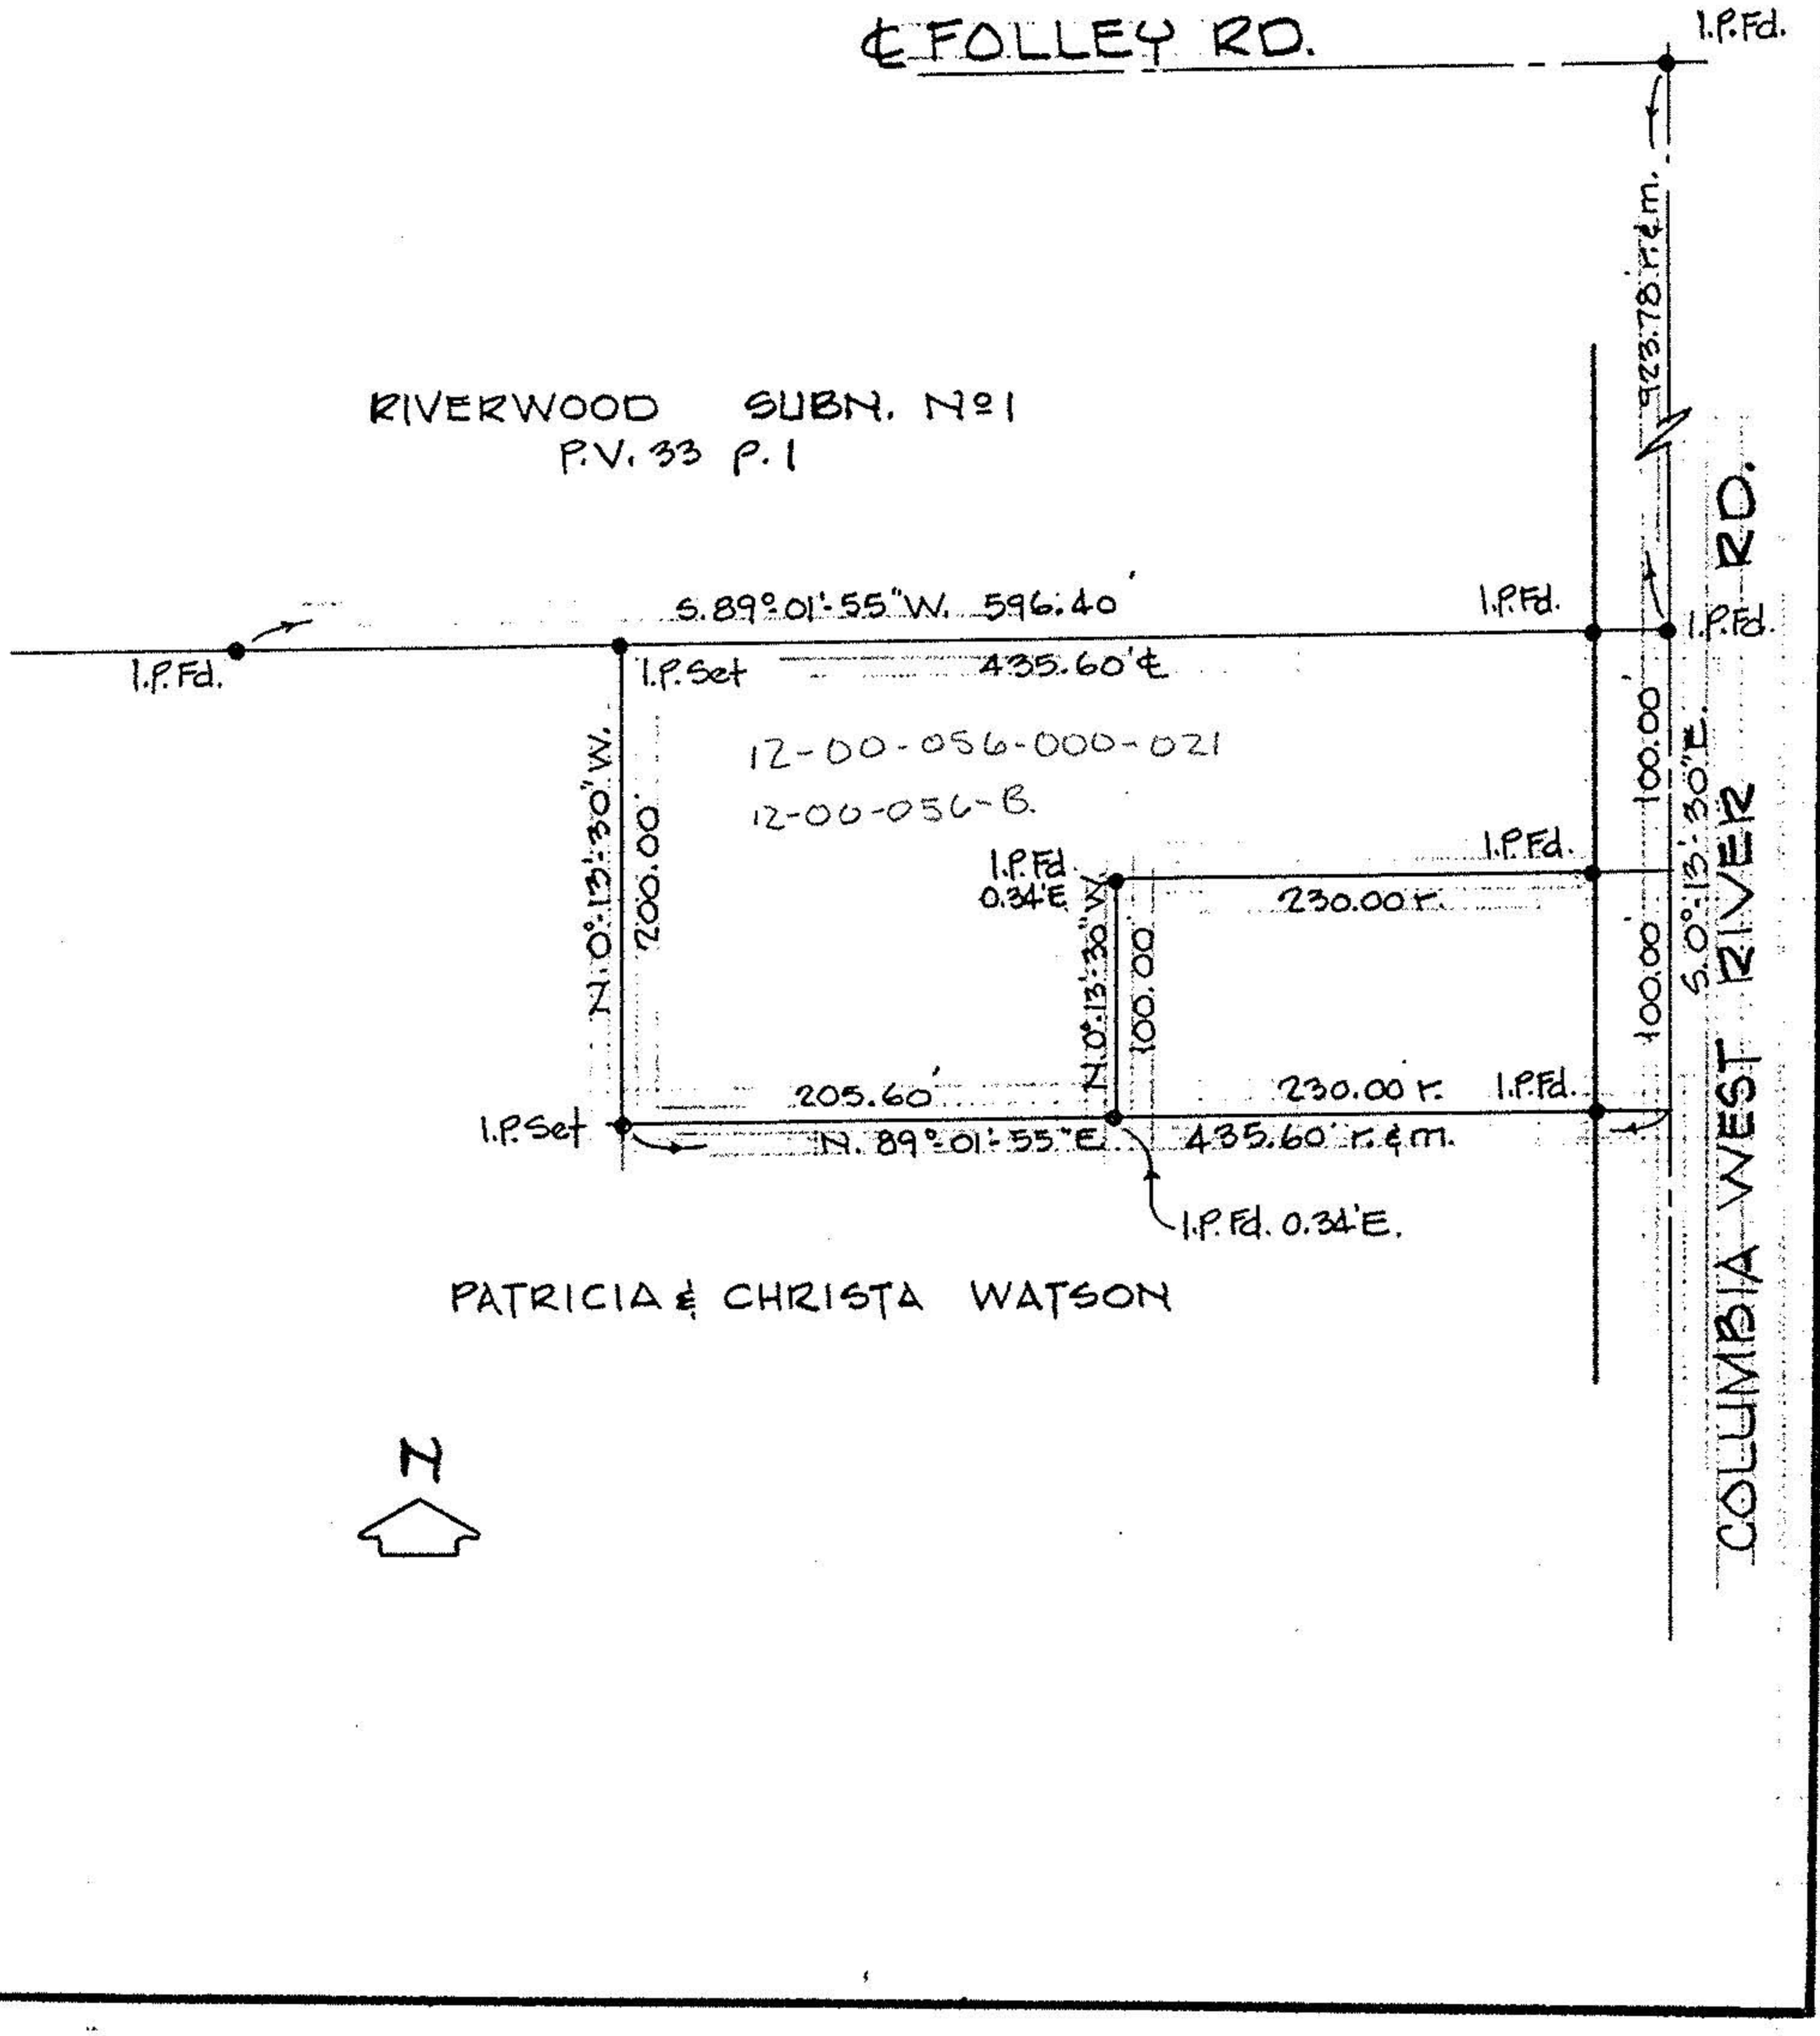
Orig. Lot 56	City of	Date AUG. '90 Scale
Orig. Sec	Village of	Dwn. by R.G.S. Chkd. by K.B.
Tract	County of LORAIN	Job No. 90-1957 F.B.
Township of COLUMBIA	State of OHIO	Printed