

OR 207 Pg 199
Russell S & Dawn Buckwald

586° 35' 40" E

928.20'

Richard
Buckwald

N 30° 15' E
255.00

355.36'

697.00
N 86° 45' W

13.119 Acres

Richard D & Holly J
Planchko OR 532
Pg 723

250.00

438.88
N 30° 15' E

Donald T & Valerie J
Harcar Sr
OR 536 Pg 54

250.00

N 86° 54' 40" W
441.35

1386.80'

S 30° 47' W

Donald J Justice OR 1060
Pg 470




Sagway Rd

RR5

283.00 1P 20 250.00 125.00 220

86° 54' 40" E 1131.50'

Nichols Rd

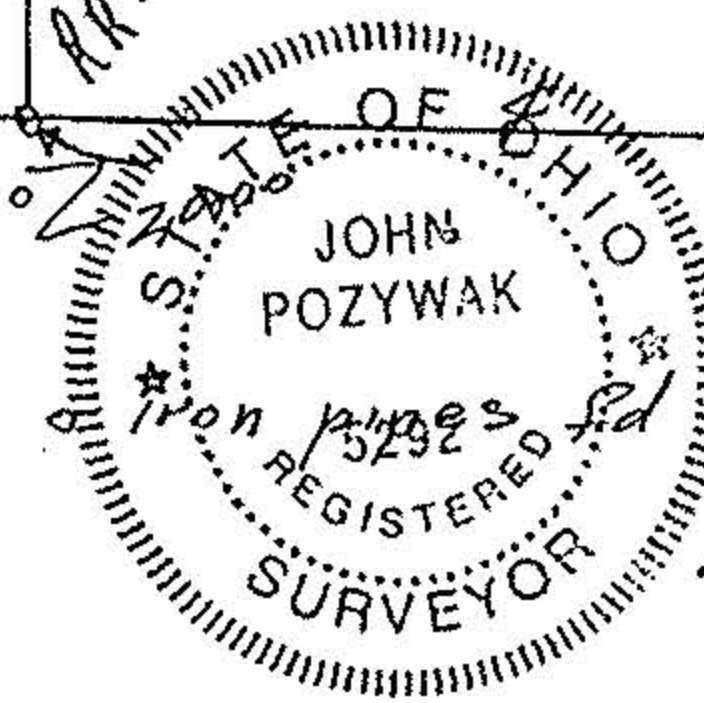

John Pozywak
Reg Surveyor
5292

Parcel Split for
Samuel Bucci
original Lot 58
Columbia Township Lorain County
Ohio Scale 1" = 200' Oct 1995
From Previous Surveys

#00277-D

