LOT SPLIT AND CONSOLIDATION SURVEY
FOR
EMIILY A. WALKER
INSTRUMENT NO. 795305
P.P.NO. 12-00-062-000-080
AND DANIEL A. & SHERYL A. PULICE
DEED VOLUME 1122, PAGE 749
P.P.NO. 12-00-062-000-057
BEING PART OF LOT 62
OF COLUMBIA TOWNSHIP
COUNTY OF LORAIN, STATE OF OHIO
FEBRUARY 15TH, 2002

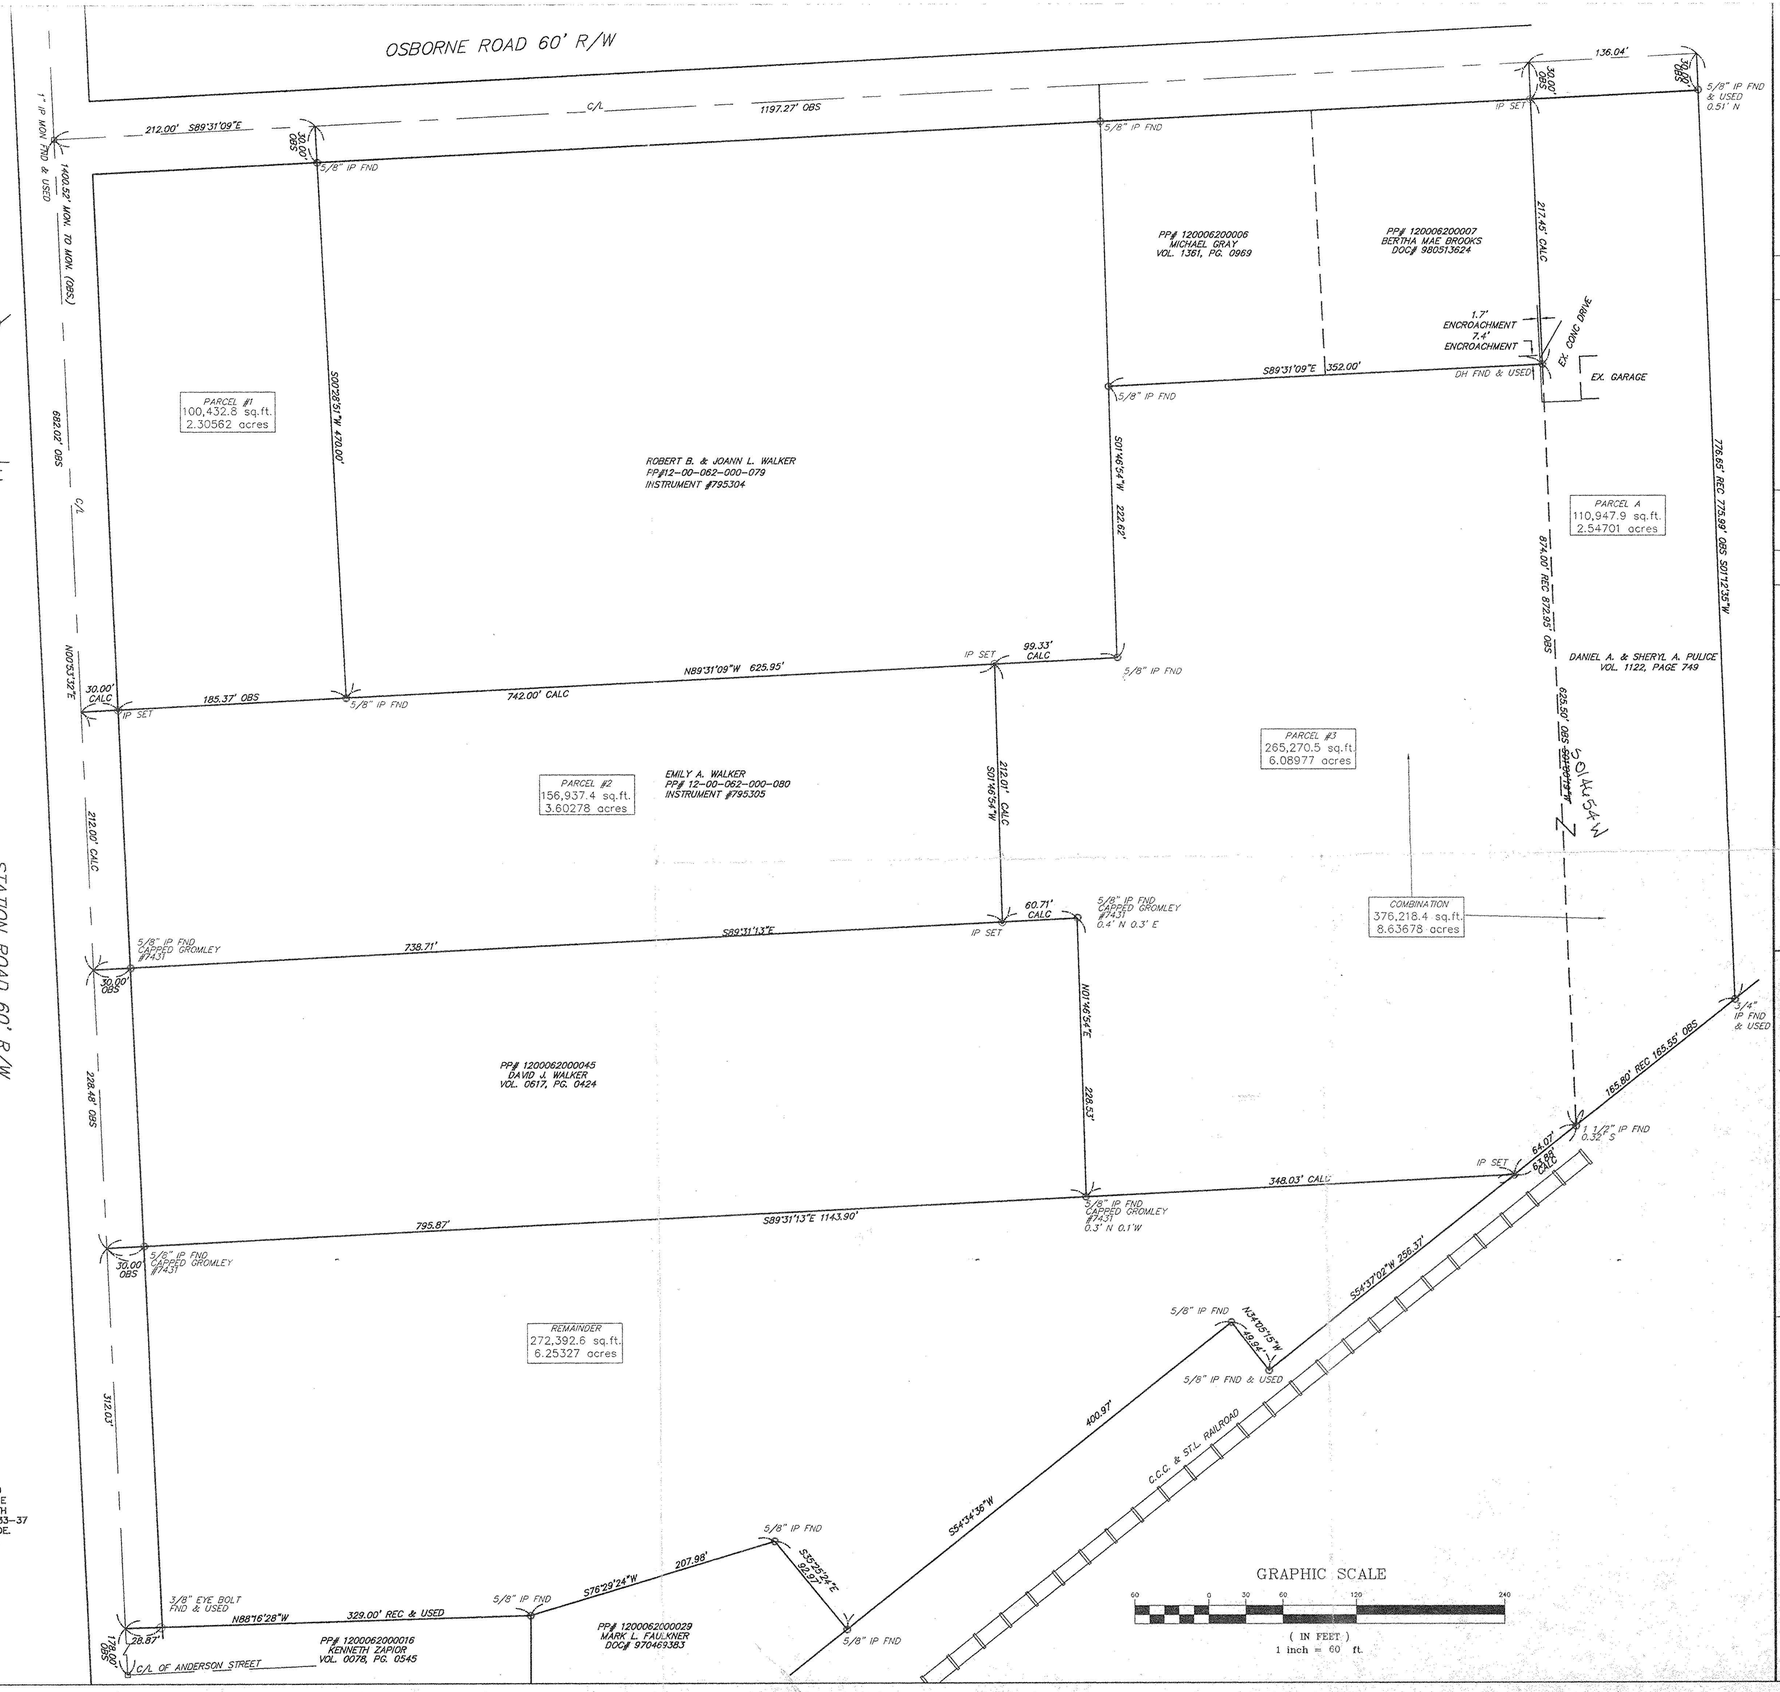

I CERTIFY THAT I HAVE SURVEYED THE PREMISES AND PREPARED THE SURVEY MAP IN ACCORDANCE WITH THE PROVISIONS OF CHAPTER 4733-37 OF THE OHIO ADMINISTRATIVE CODE.

STATE OF OHIO
RALPH GROMLEY
7431
REGISTERED SURVEYOR

RALPH W. GROMLEY
REG. SURVEYOR #7431

NO.	DATE	DESCRIPTION	BY

5794 HEISLEY ROAD MENTOR OHIO 44060
440-639-9950
FAX 639-9790
AZTECH
ENGINEERING and SURVEYING
Civil Engineering - Land Surveying

HORIZ. SCALE: 1" = 60'	VERT. SCALE:
DRAWN BY: BM	DATE: 2/15/02
CHECKED BY: RWG	DRAWING NO.:
JOB NO.: 111030	SHEET 1 OF 1